


DUNHAM SURVEYING, S.C.
SURVEYING & SUBDIVIDING
DELAVER, WISCONSIN 53115

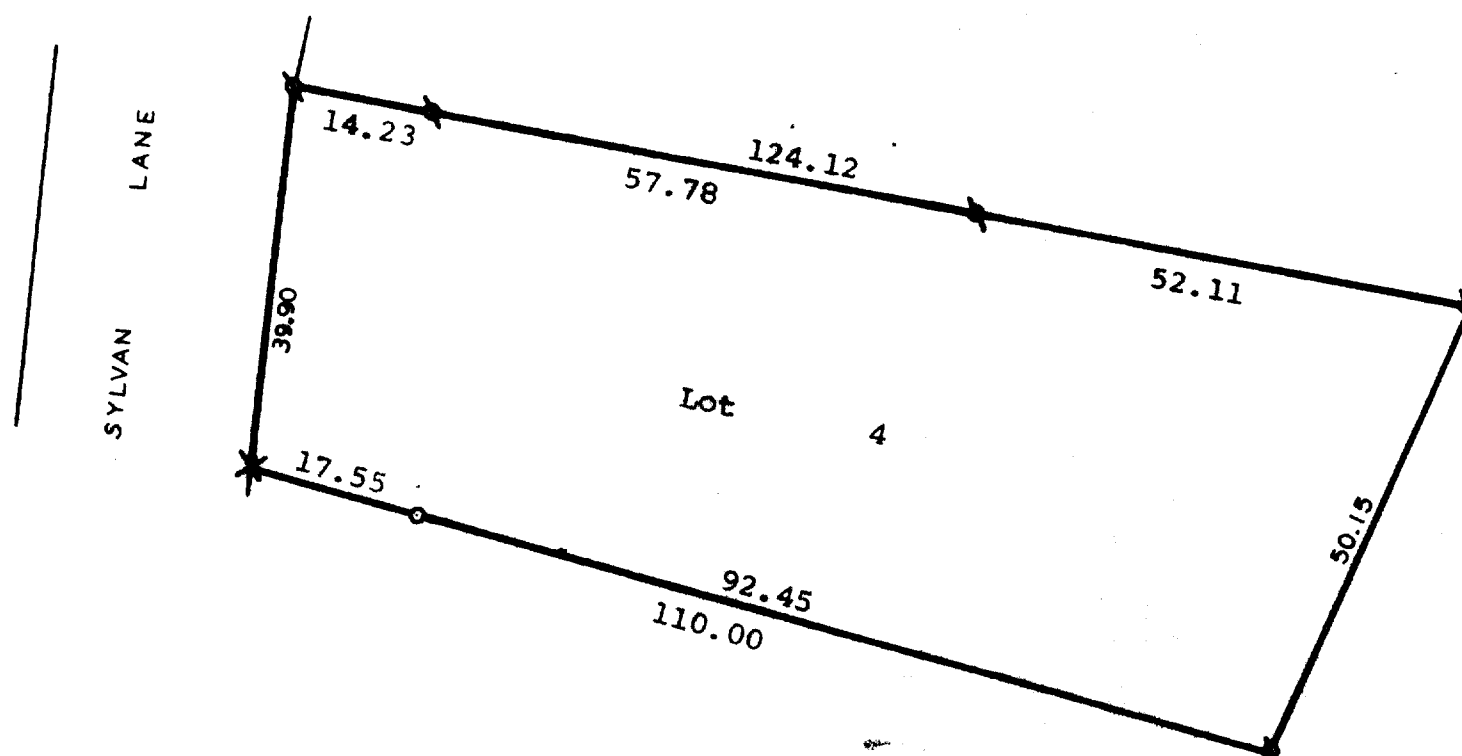


N

Scale - 1" = 20'
⊗ = Iron Pipe Found
○ = Iron Pipe Set
X = Cross in Concrete Wall

Plat of a survey of Lot 4 of Buena Vista, located
in the Village of Fontana-on-Geneva Lake, Walworth
County, Wisconsin.
June 18, 1981.

James M. Dunham
James M. Dunham, Surveyor

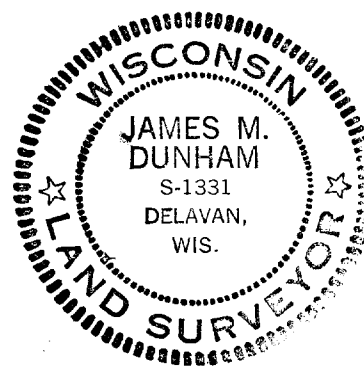

501-3

5-592-D