
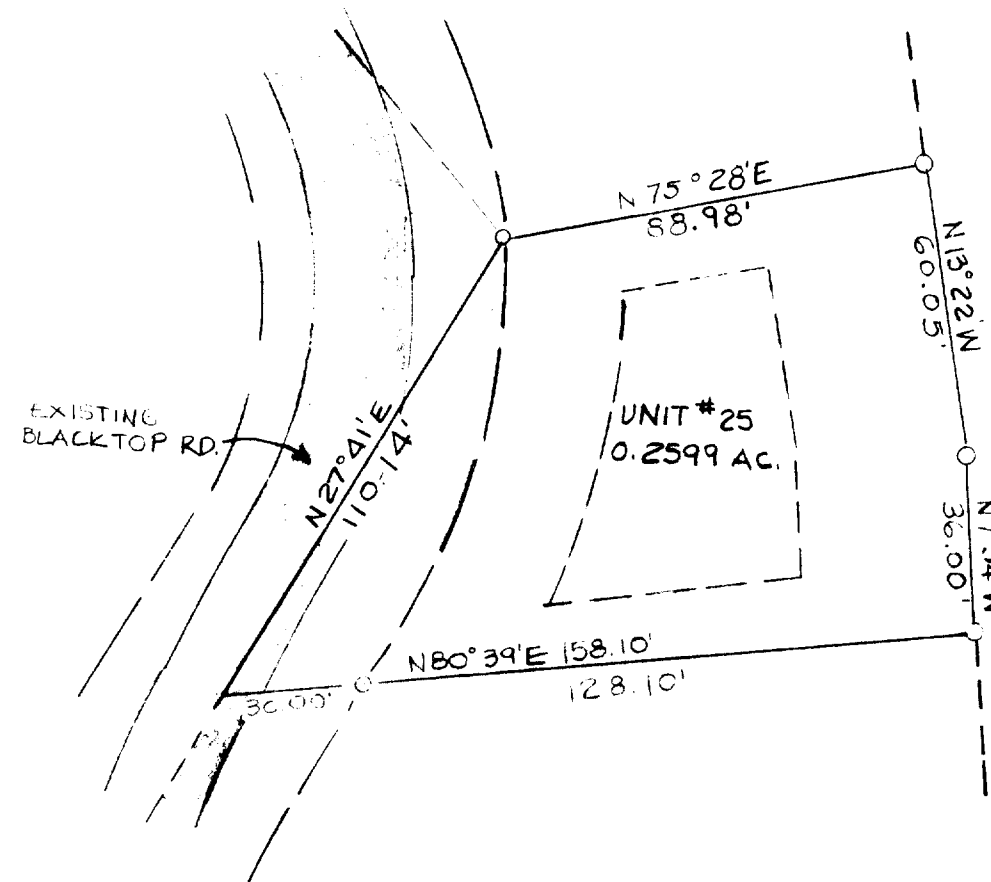


SKETCH OF UNIT 25 OF ABBEY SPRINGS

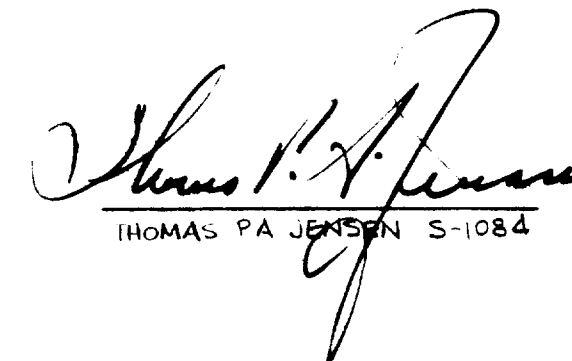
LOCATED IN THE SE 1/4 OF SECTION 13, T1N, R16E


 SCALE 1" = 40'
LEGEND
 O - IRON PIPE FOUND
 NOTE - PAINTED LATH & FLAG PLACED
 AT ALL FOUND IRON PIPE
 BEARINGS ARE BASED ON THE ORIGINAL
 CONDOMINIUM PLAT FOR ABBEY SPRINGS
 DATE: JUNE 29, 1982



OWNER - JIM DAHLKE
 BONNERHILL DR.
 WALWORTH, WIS. 53184

JENSEN SURVEYING & MAPPING S.C.
 P.O. BOX 322
 ELKHORN, WIS 53121


 THOMAS PA JENSEN S-1084