


HAROLD H. KOLB

REGISTERED PROFESSIONAL LAND SURVEYOR
LAKE GENEVA, WISCONSIN

PLAT OF SURVEY OF

LOT 8, BLOCK 2, INDIAN HILLS, TOWN 1
NORTH, RANGE 16 EAST, VILLAGE OF
FONTANA-ON-GENEVA LAKE, WALWORTH
COUNTY, WISCONSIN.

OWNER: DR. JOHN P. MCPHERSON
1803 OLD ORCHARD
ROCKFORD, IL 61100

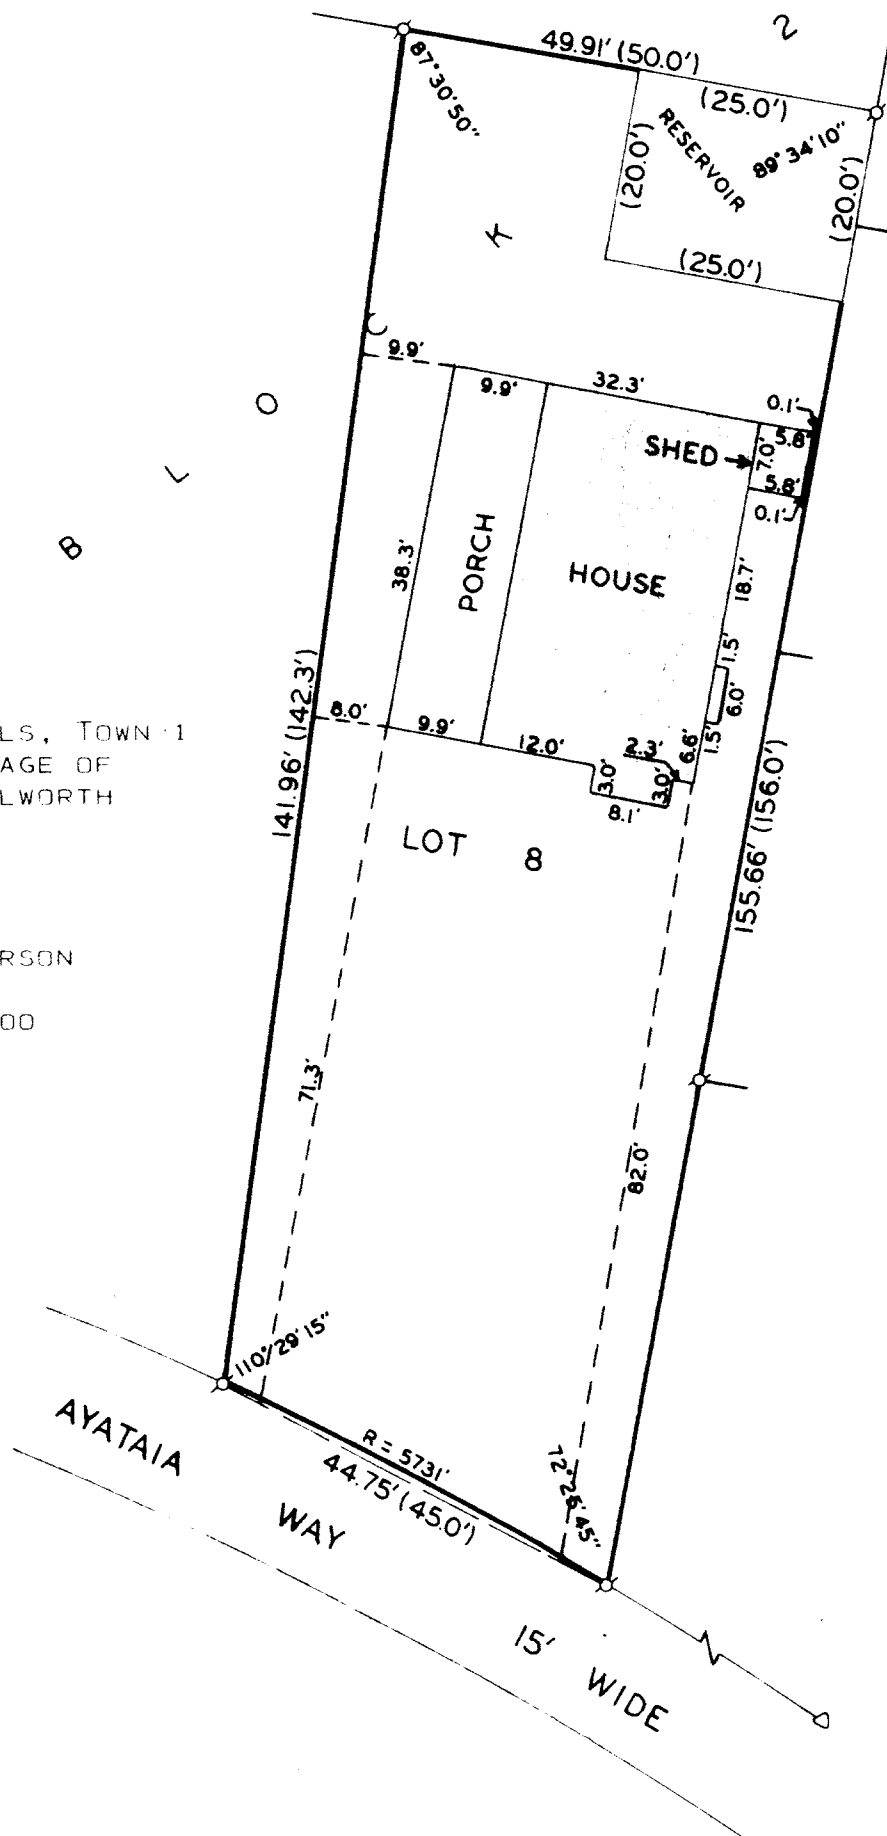

I, HAROLD H. KOLB, DO HEREBY CERTIFY THAT I HAVE
SURVEYED THE PROPERTY HEREON DESCRIBED ACCORDING
TO THE OFFICIAL RECORDS, AND THAT THE PLAT HEREON
IS A CORRECT REPRESENTATION OF THE LOT LINES.

HAROLD H. KOLB
WISCONSIN REGISTERED LAND SURVEYOR, S-187
DATE

SCALE: 1" = 20'
LEGEND

- Ø - IRON PIPE FOUND
- - CONCRETE MONUMENT, 5" DIA. x 30"
- △ - RAILROAD SPIKE () - AS PLATTED