


○ = IRON PIPE FOUND

MAP SCALE IN FEET

(XXX) = RECORD DIMENSION


UNIT 46

MEAS. $N 3^{\circ} 27' W$ 152.00'

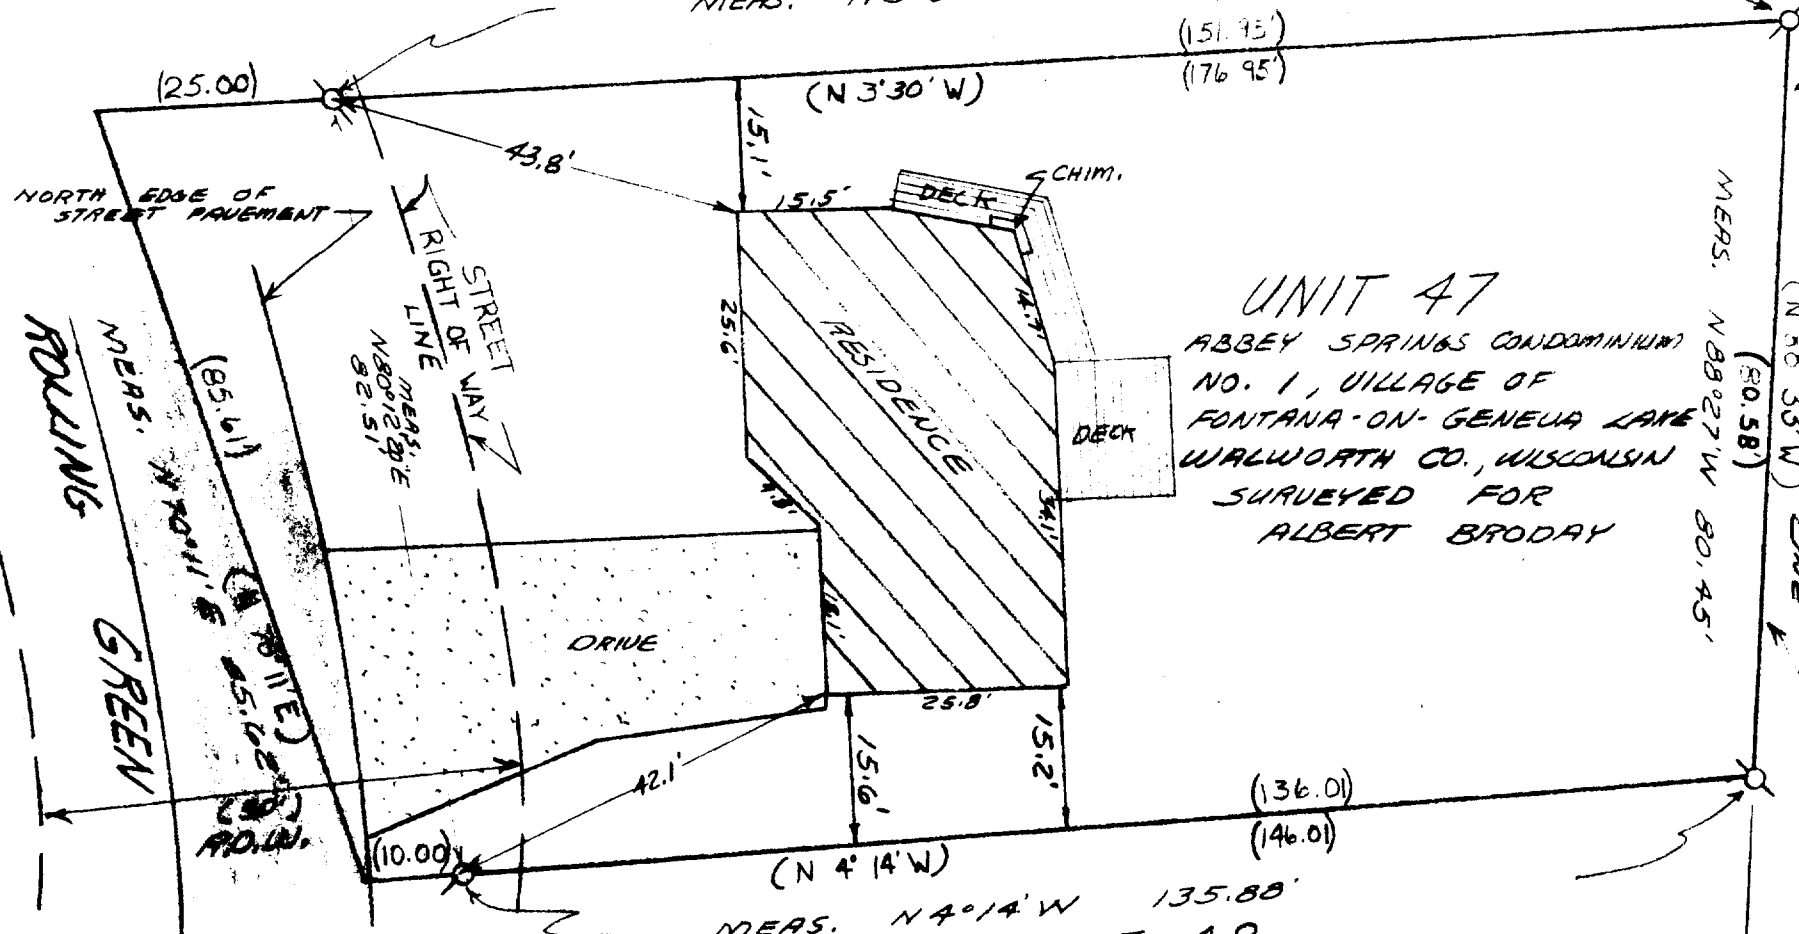

I hereby certify that I have surveyed the above described property and that the above map is a true representation thereof and shows the size and location of the property, its exterior boundaries, the location of all visible structures and dimensions of all principal buildings thereon, boundary fences, apparent easements, roadways and visible encroachments, if any.

This survey is made for the use of the present owners of the property, and also those who purchase, mortgage, or guarantee the title thereto within one (1) year from date hereof.

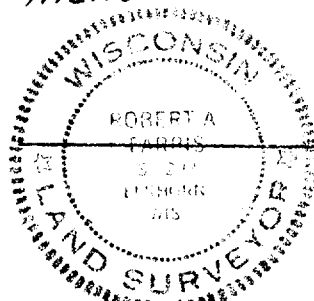

DATED 9 DEC. 1983

UNIT 48

FARRIS, HANSEN & ASSOCIATES, INC.
715 W. Walworth St. P.O. Box 487
Elkhorn, WI 53121

DRAWING NUMBER 2189