


RECEIVED
JUL 9 1986
J. S.

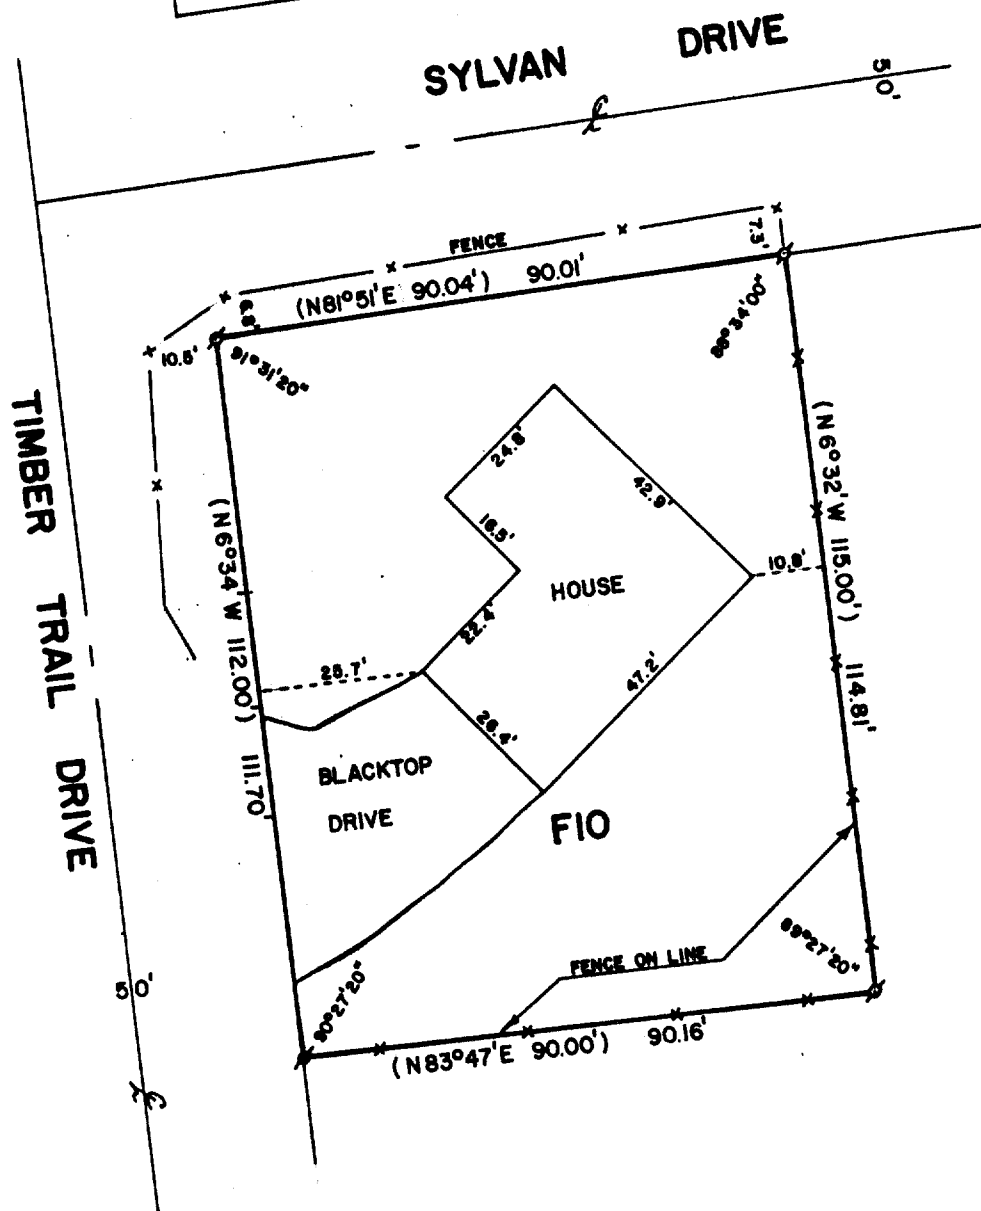

LOT F10, ADDITION F, COUNTRY CLUB ESTATES,
VILLAGE OF FONTANA-ON-GENEVA LAKE, WALWORTH
COUNTY, WISCONSIN.

The seal is circular with a double-lined border. The outer border contains the text "WISCONSIN" at the top and "LAND SURVEYOR" at the bottom, separated by two five-pointed stars. The inner circle contains the text "DAVID F. ABELL", "S-1596", and "Delavan, Wis." in a serif font.

LEGEND

- I, DAVID F. ABELL, DO HEREBY CERTIFY THAT I HAVE SURVEYED THE PROPERTY HEREON DESCRIBED ACCORDING TO THE OFFICIAL RECORDS, AND THAT THE PLAT HEREON IS A CORRECT REPRESENTATION OF THE PROPERTY LINES TO THE BEST OF MY KNOWLEDGE AND BELIEF.

David F. Abell
DAVID F. ABELL
WISCONSIN REGISTERED LAND SURVEYOR, S-1596

DATE June 14, 1986 JOB NUMBER - 86010

SCTF-10

5-610-A