


D.D. COOPER & CO. INC.

ROUTE 4, BOX 501 B
ELKHORN, WI 53121

PH 414-723-6265


SURVEYING • MODULAR HOMES

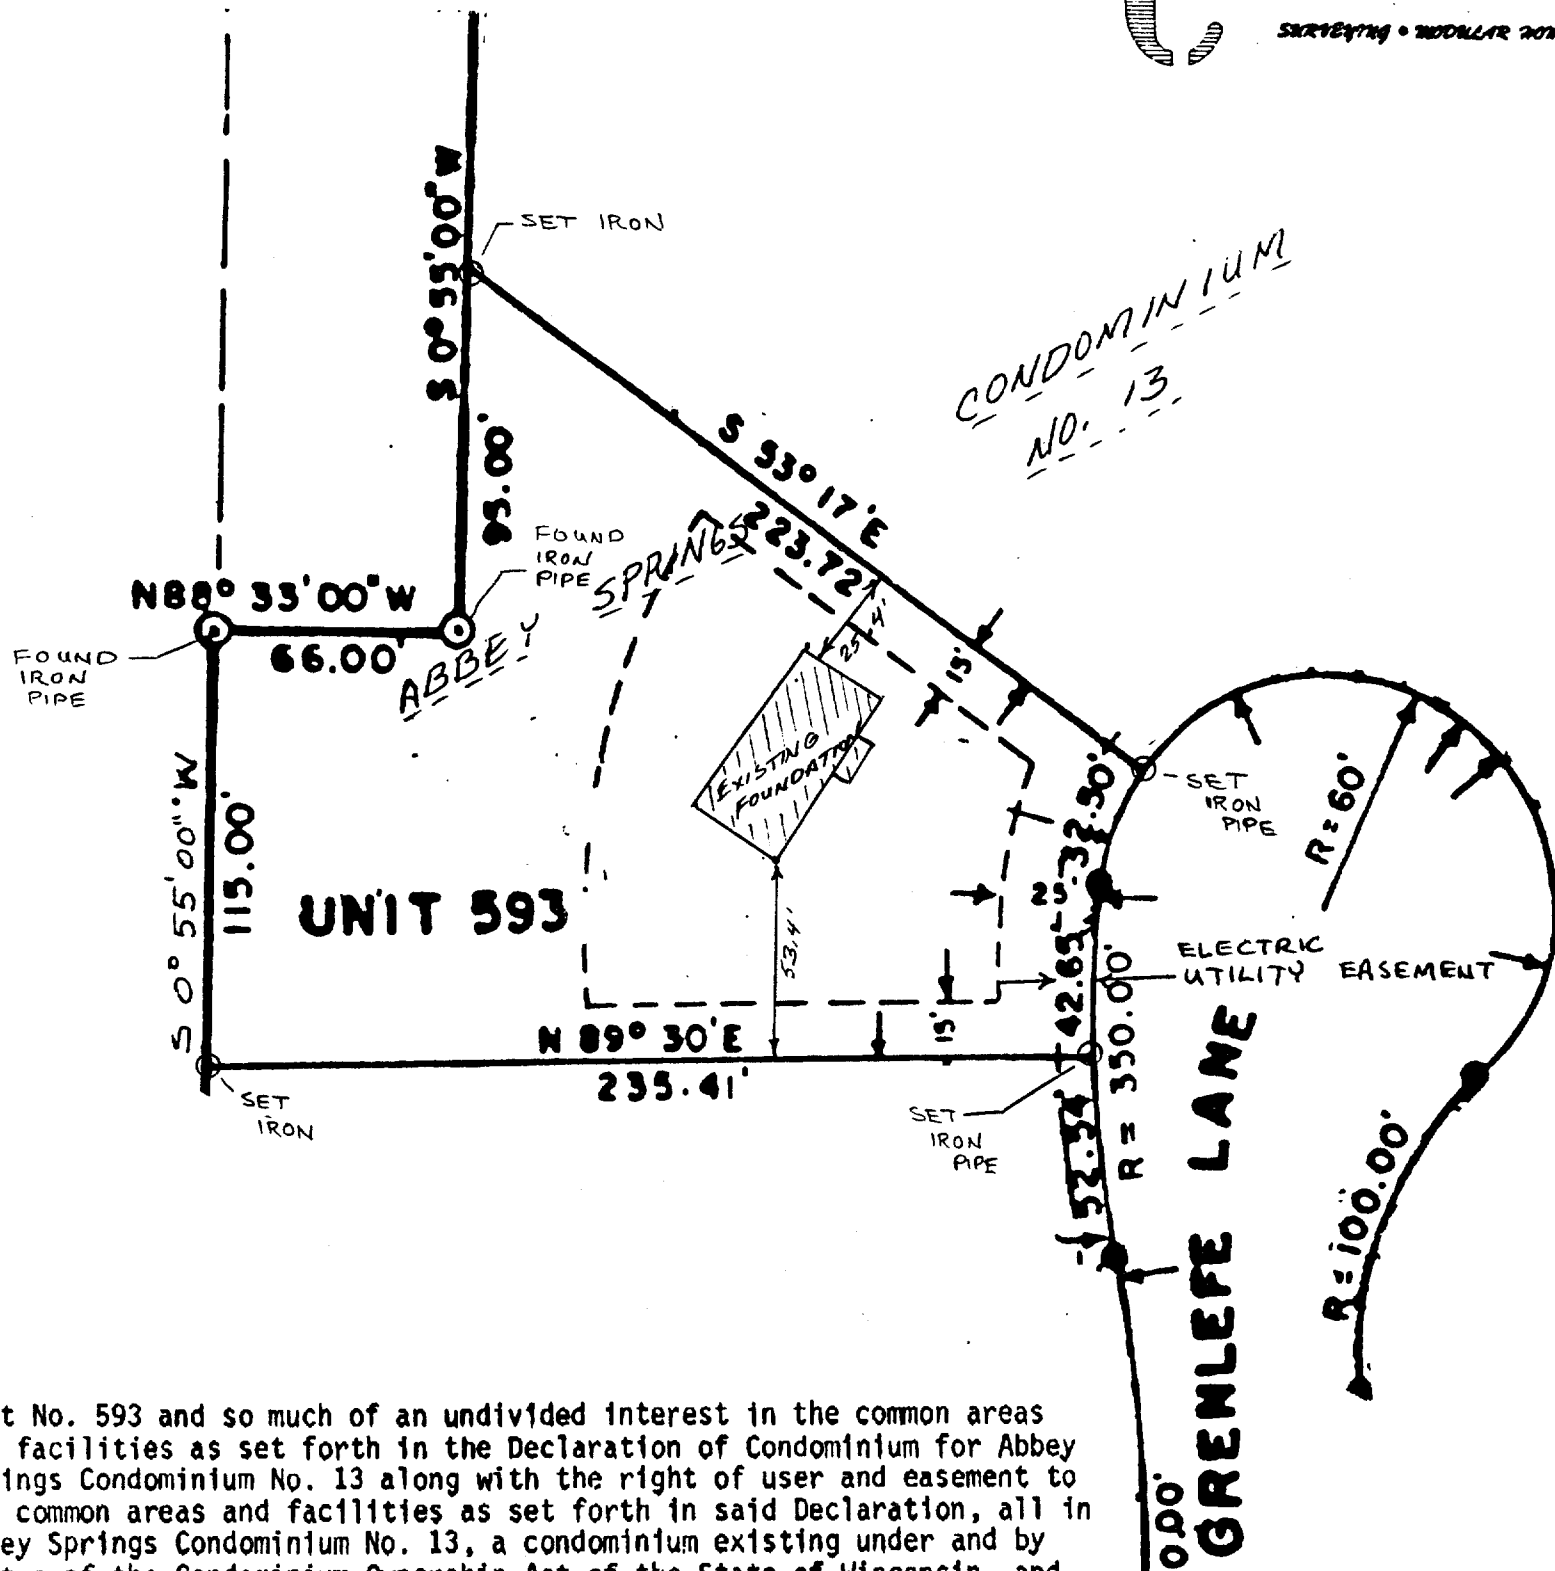

Unit No. 593 and so much of an undivided interest in the common areas and facilities as set forth in the Declaration of Condominium for Abbey Springs Condominium No. 13 along with the right of user and easement to the common areas and facilities as set forth in said Declaration, all in Abbey Springs Condominium No. 13, a condominium existing under and by virtue of the Condominium Ownership Act of the State of Wisconsin, and recorded by Declaration as such Condominium in the Office of the Register of Deeds for Walworth County, Wisconsin on June 18, 1982 in Volume 286 of Records, pages 311-355, as Document No. 79578 and re-recorded on December 1, 1982 in Volume 294 of Records, pages 377-418, as Document No. 84645, and subject to any amendments and addendums thereto. Said condominium being located on the real estate described in said Declaration.

SCALE 1"=

SURVEY DONE FOR FIRST STATE SAU

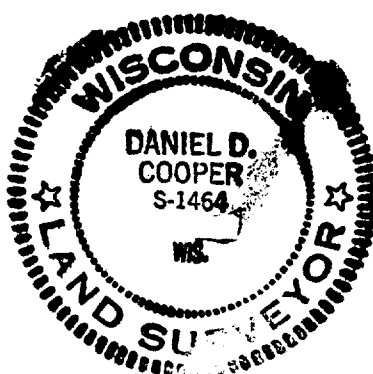

I, DANIEL D. COOPER, REGISTERED SURVEYOR, DO HEREBY CERTIFY THAT I HAVE SURVEYED THE PROPERTY DESCRIBED HEREON AND THAT THE MAP SHOWN HEREON IS A TRUE AND ACCURATE REPRESENTATION THEREOF TO THE BEST OF MY PROFESSIONAL KNOWLEDGE AND BELIEF.

DATED THIS 6 DAY OF Sept, 1984

DANIEL D. COOPER, RLS NO. 8-1464

5-612-6

SCDB-13-00593

DRAWING NO. 1966