


**SURVEYING & SUBDIVIDING
DELA VAN, WISCONSIN 53115**

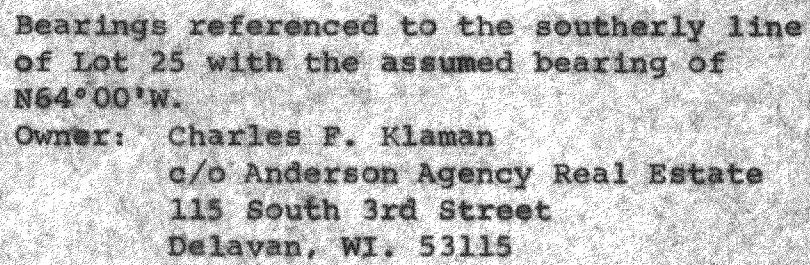

I, George F. Dunham, Surveyor, certify that I have surveyed the property described as follows:
 Lot 25 in Block 4 of Indian Hills First Addition to the Village of Fontana-on-Geneva Lake, Walworth County, Wisconsin, and that the plat shown above is a true representation thereof and shows the size and location of the property, its exterior boundaries, the location of all visible structures, and dimensions of all principal buildings thereon, boundary fences, apparent easements, roadways and visible encroachments, if any, and that I have surveyed the property hereon described according to the official records, to the best of my knowledge and belief.
 May 11, 1984

A circular seal for a Wisconsin Land Surveyor. The outer ring contains the text "WISCONSIN" at the top and "LAND SURVEYOR" at the bottom, separated by two five-pointed stars. Inside this ring, the name "GEORGE T. DUNHAM" is printed in a larger font. Below the name, in a smaller font, are the words "DELAVAN, WIS." and the surveyor's number "S-306".