


## KOLB LAND CONSULTING, INC.


LAND SURVEYING . SUBDIVIDING . LAND PLANNING

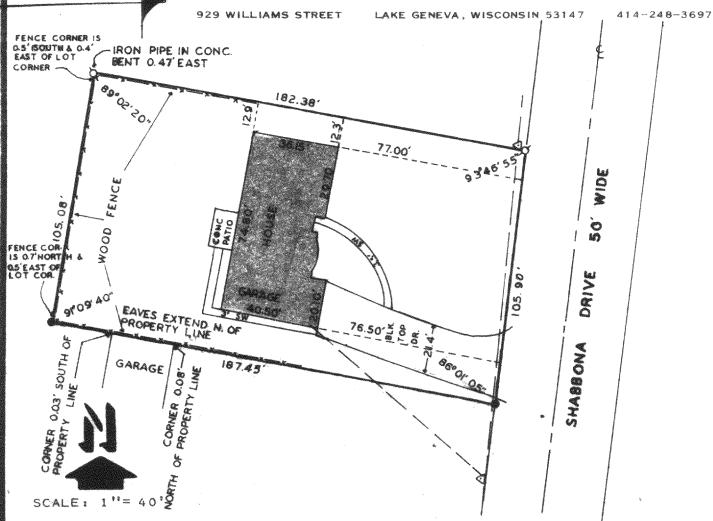

 PLAT OF SURVEY OF LOT 81 IN COUNTRY CLUB ESTATES, UNIT 2, VILLAGE OF FONTANA-ON-GENEVA LAKE, WAL-WORTH COUNTY, WISCONSIN. TAX PARCEL: SCO2-76.

ORDERED BY: RAULAND AGENCY 118 KENOSHA ST. WALWORTH, WI. 53184

FOR: HOWARD & SHIRLEY GILES

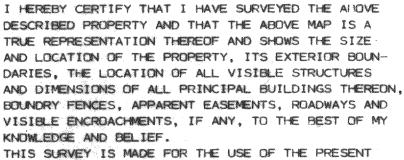

THIS SURVEY IS MADE FOR THE USE OF THE PRESENT OWNERS OF THE PROPERTY, AND ALSO THOSE WHO PURCHASE, MORTGAGE, OR GUARANTEE THE TITLE THERETO WITHIN ONE (1) YEAR FROM DATE HEREOF.



A STATE OF THE STA		_dia	
The state of the s	and the same	/ 1	Mille
	10 11 - 10	Carried State of Stat	A000
CAN MA	40 M / 1949	100 100	1
- フタイスノ ロイノ	LA ALT.		Bando -
- magazina di manana di manana	all and a second and a second areas	and the second second	
age of the contract of the con			

HAROLD H. KOLB

WISCONSIN REGISTERED LAND SURVEYOR, S-187

DATE JUNE 24, 1985

REVISED.

REVISED.