


RECEIVED
SEP 30 1985
H L

KOLB LAND CONSULTING, INC.
LAND SURVEYING • SUBDIVIDING • LAND PLANNING

929 WILLIAMS STREET LAKE GENEVA, WISCONSIN 53147 414-248-3697

N
SCALE: 1" = 30'

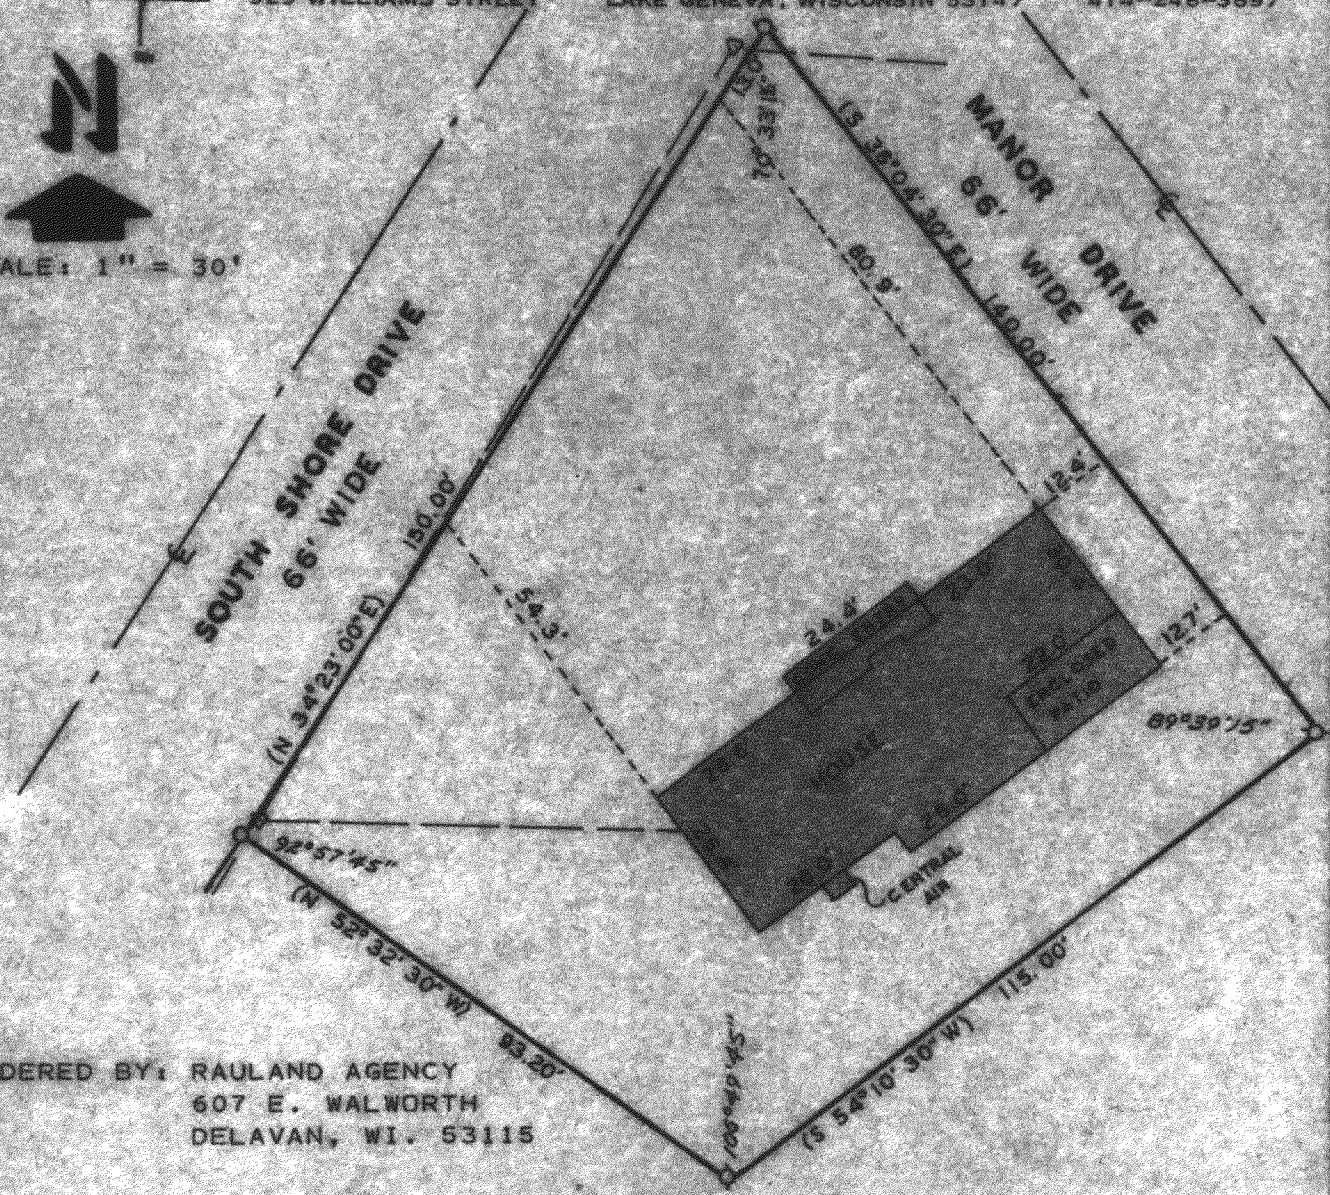

ORDERED BY: RAULAND AGENCY
607 E. WALWORTH
DELAVER, WI. 53115

PLAT OF SURVEY OF


A PARCEL OF LAND LOCATED IN THE SW 1/4, SECTION
13, T1N, R16E, VILLAGE OF FONTANA, WALWORTH COUNTY,
WISCONSIN.
TAX PARCEL: STPV 122B

LEGEND

- IRON PIPE FOUND
- 1" X 24" IRON PIPE SET
- △ UTILITY POLE
- OVERHEAD UTILITY LINES
- WAS RECORDED

NOTE: BEARINGS ARE
ASSUMED AS RECORDED.

I HEREBY CERTIFY THAT I HAVE SURVEYED THE ABOVE
DESCRIBED PROPERTY AND THAT THE ABOVE MAP IS A
TRUE REPRESENTATION THEREOF AND SHOWS THE SIZE
AND LOCATION OF THE PROPERTY ITS EXTERIOR BOUN-
DARIES, THE LOCATION OF ALL VISIBLE STRUCTURES
AND DIMENSIONS OF ALL PRINCIPAL BUILDINGS THERE-
ON, BOUNDARY FENCES, APPARENT EASEMENTS, ROAD-
WAYS AND VISIBLE ENCROACHMENTS, IF ANY TO THE
BEST OF MY KNOWLEDGE AND BELIEF.
THIS SURVEY IS MADE FOR THE USE OF THE PRESENT
OWNERS OF THE PROPERTY, AND ALSO THOSE WHO PUR-
CHASE, MORTGAGE, OR GUARANTEE THE TITLE THERE-
TO WITHIN ONE (1) YEAR FROM DATE HEREOF.

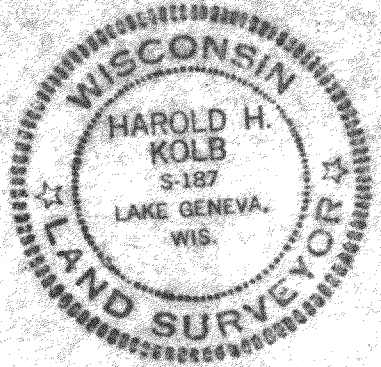

Harold H. Kolb
HAROLD H. KOLB

WISCONSIN REGISTERED LAND SURVEYOR, S-187

DATE JUNE 24, 1985

REVISED _____

REVISED _____