
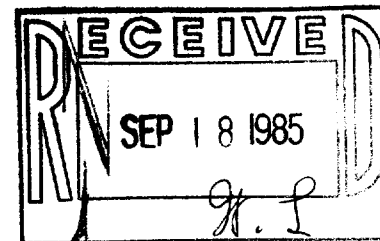


PLAT OF SURVEY UNIT 23 ABBEY SPRINGS CONDOMINIUM NO. 1  
VILLAGE OF FONTANA  
WALWORTH COUNTY, WIS.

I HEREBY CERTIFY THIS PLAT IS A TRUE AND ACCURATE REPRESENTATION OF THE LOT LINES TO THE BEST OF MY PROFESSIONAL KNOWLEDGE AND BELIEF


Robert A. Farris  
ROBERT A. FARRIS  
DATED 8/19/85

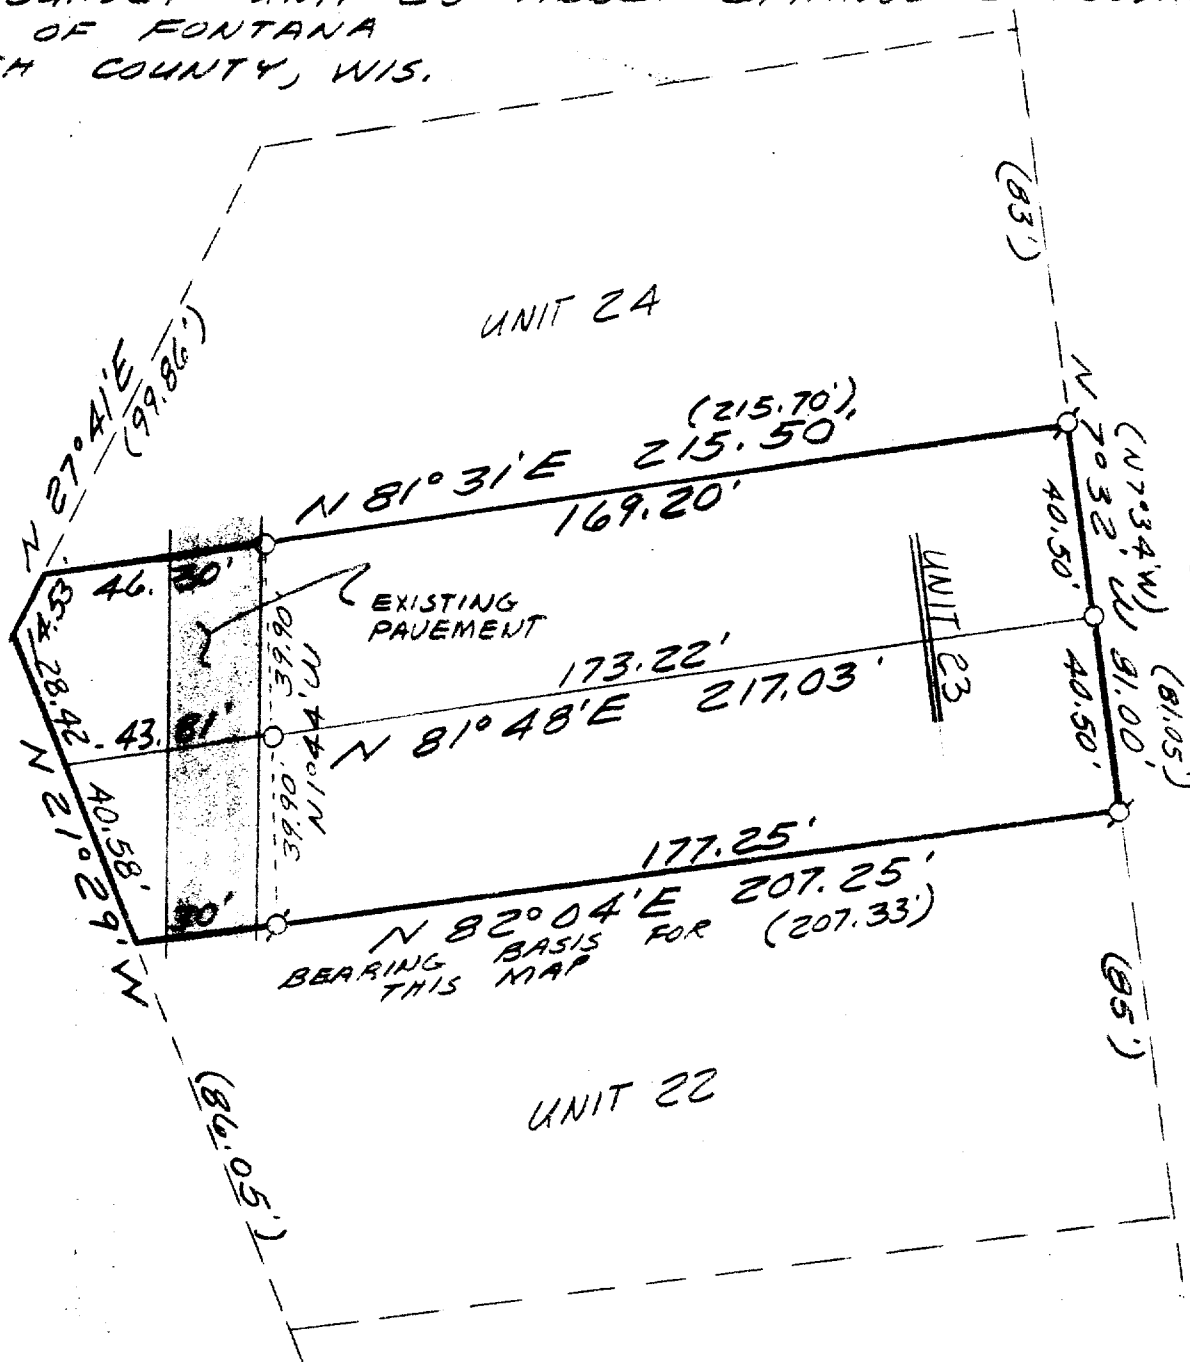

|     |       |
|-----|-------|
| MAP | SCALE |
| 1"  | = 40' |

O = SET PIPE STAKE  
 Ø = FOUND PIPE STAKE  
 (xxx) = RECORD  
 DIMENSION

ORDERED BY:  
LOIS JORGANSEN

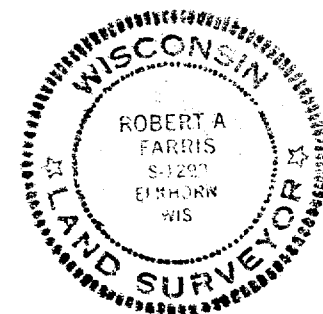

5-639-F

DRAWING NUMBER 2457<sup>v</sup>