


NORTH SHORE DRIVE
66' WIDE

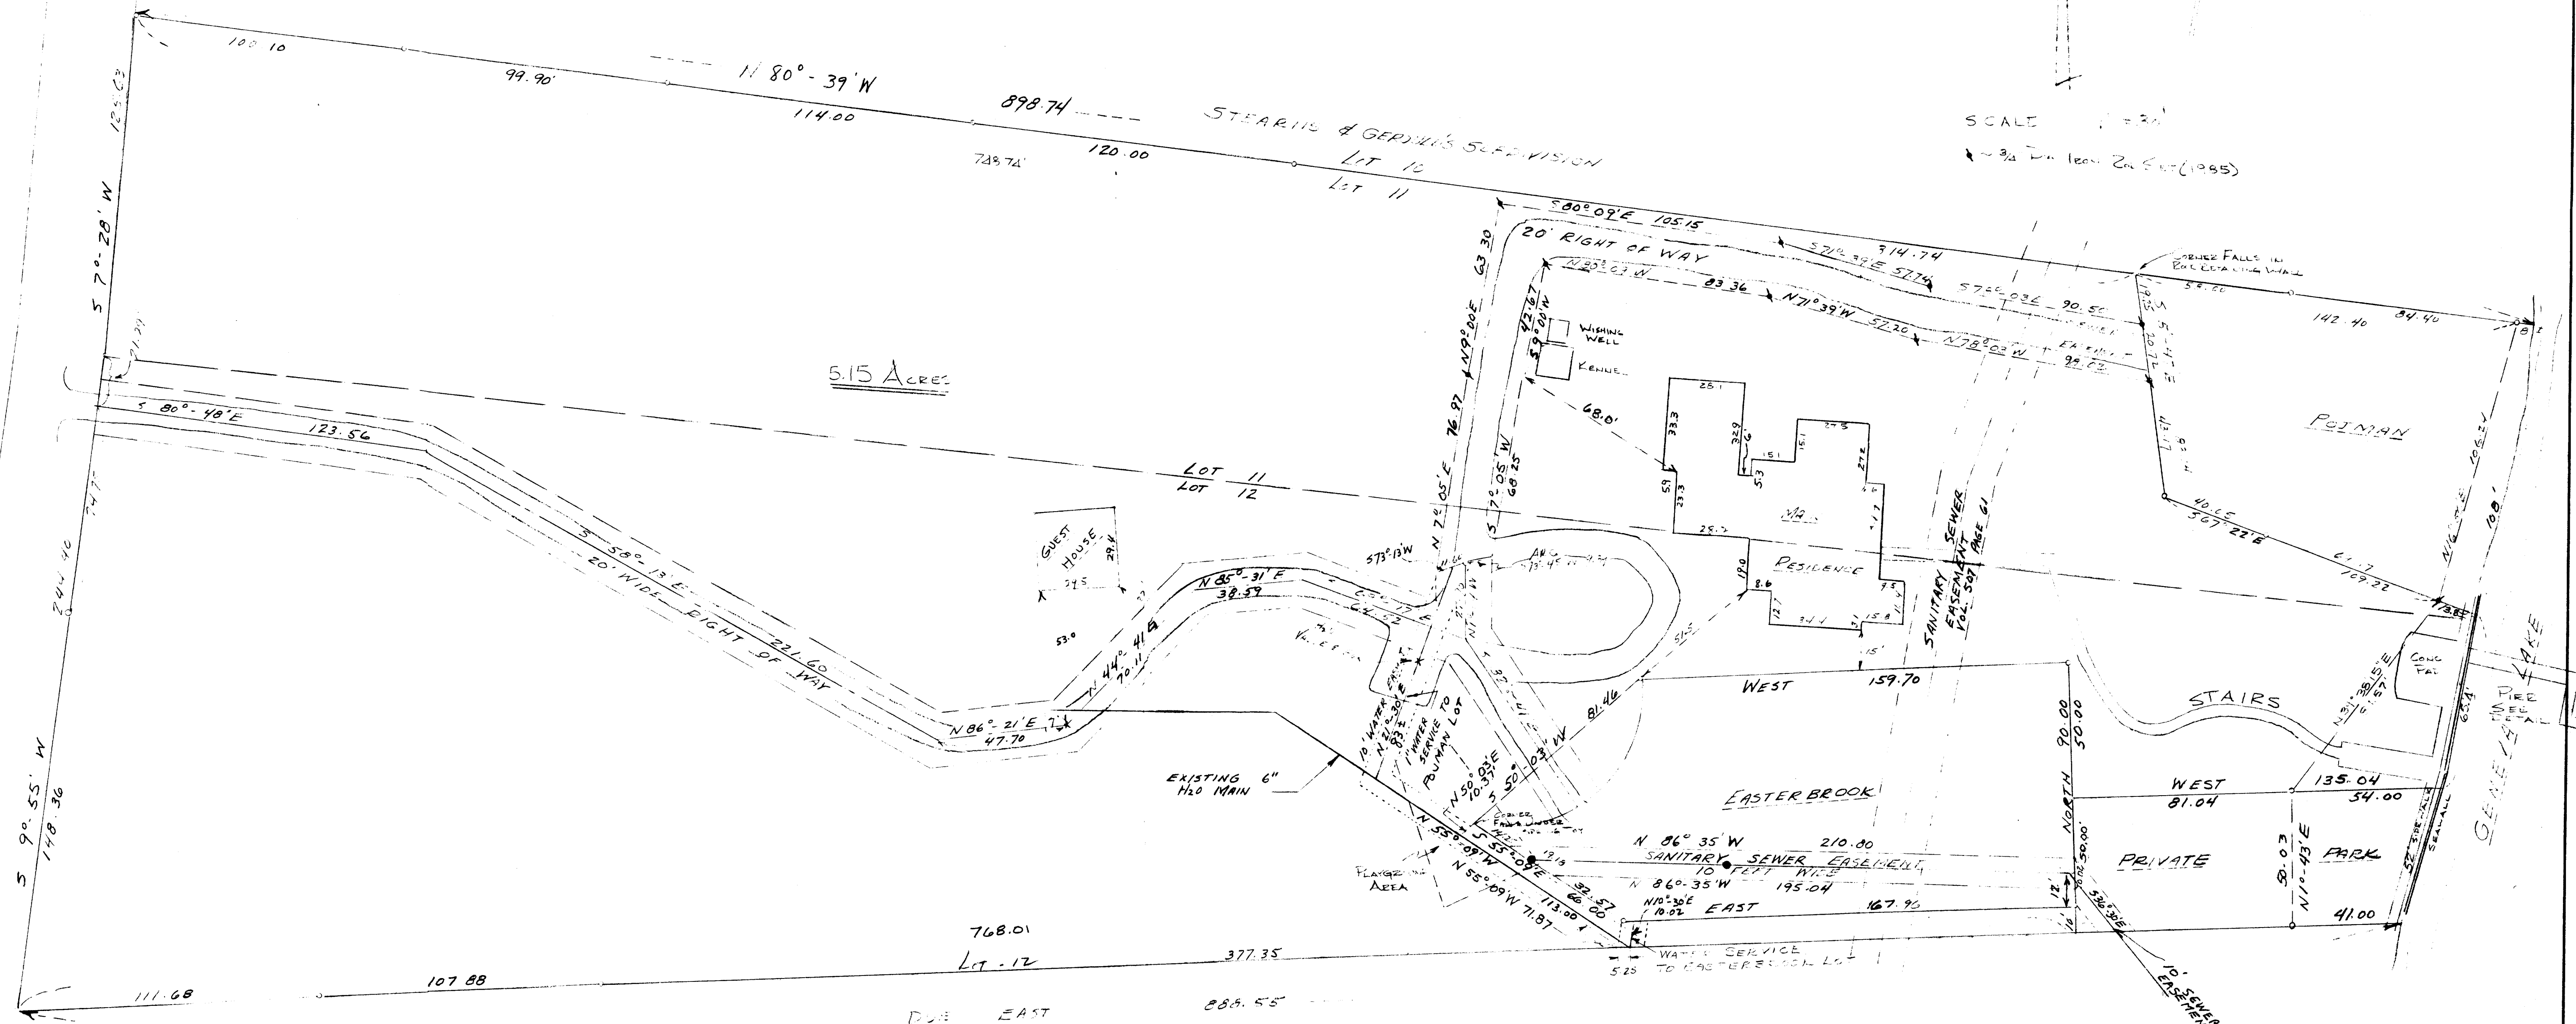

BUENA VISTA SUBDIVISION

WE CERTIFY THAT WE HAVE SURVEYED THE ABOVE DESCRIBED PROPERTY AND THAT THE ABOVE PLAT IS AN ACCURATE SURVEY AND A TRUE REPRESENTATION THEREOF AND CORRECTLY SHOWS THE EXTERIOR BOUNDARY LINES AND LOCATION OF BUILDINGS AND OTHER IMPROVEMENTS, AND ROADS, DRIVEWAYS, AND OTHER APPARENT EASEMENTS ON SAID PROPERTY AND THE CORRECT MEASUREMENTS THEREOF.

DEC. 12, 1967
REVISED 6-7-85 BY JENSEN SURVEYING & MAPPING S.C.
P.O. Box 322 - ELKHORN, WIS. 53121

BY: *[Signature]*
JENSEN & JOHNSON

[Signature]
REVISED 2/14/85

LOTS 11-12 STEARNS & GEROULD'S SUBDIVISION - SW 1/4 SECTION 11 TIN-RIBE WALWORTH COUNTY, WIS		
DRAWN BY CBW	JENSEN & JOHNSON CIVIL ENGINEERS ELKHORN, WIS.	SCALE: 1" = 30'
CHECKED BY <i>[Signature]</i>		REVISED
APPROVED BY		SHEET NO. OF
DATE NOV 8, 1967		5-245