


WALWORTH COUNTY
SURVEYING & MAPPING
LAKE GENEVA, WISCONSIN

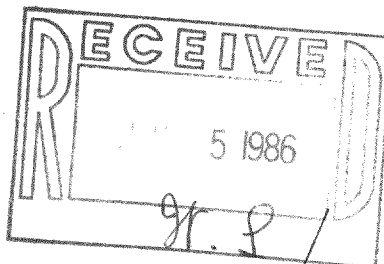


PARCEL "A"

(S88°08'28"E 225.71')
225.86'

87°41'35"

(N0°24'W 195.00')
194.96'

PARCEL "B"
0.899 ACRES

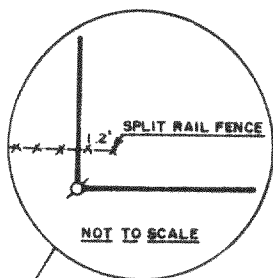

80°39'50"

200.94'
(N89°48'15"W 200.87')

88°45'50"

204°46'25"

68°06'20"

(S23°39'W 63.50')

130.25'
(S0°56'E 130.29')

15'

ROAD

UPPER GARDENS



20'

STEARNS DRIVE

PLAT OF SURVEY OF

PARCEL "B" OF CERTIFIED SURVEY MAP NO. 863,
LOCATED IN THE NORTHWEST 1/4 OF SECTION 11,
T 1 N, R 16 E, VILLAGE OF FONTANA-ON-GENEVA
LAKE, WALWORTH COUNTY, WISCONSIN.

ORDERED BY: KEEFE REAL ESTATE
P. O. BOX 268
WALWORTH, WISCONSIN 53184

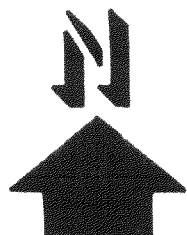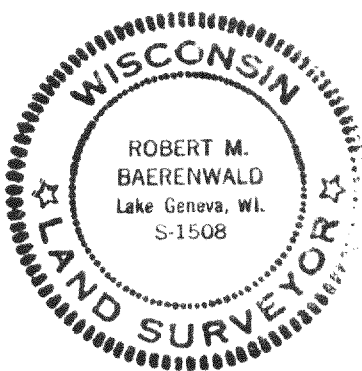

SCALE: 1"=40'

⊙ - IRON PIPE FOUND
() - RECORDED AS

I, ROBERT M. BAERENWALD, DO HEREBY CERTIFY THAT I
HAVE SURVEYED THE PROPERTY HEREON DESCRIBED ACCORDING
TO THE OFFICIAL RECORDS AND THAT THE PLAT HEREON IS A
CORRECT REPRESENTATION OF THE PROPERTY LINES TO THE
BEST OF MY KNOWLEDGE AND BELIEF.

Robert M. Baerenwald
ROBERT M. BAERENWALD
WISCONSIN REGISTERED LAND SURVEYOR, S-1508

DATE March 19, 1986
JOB NO. 0485

5-651✓