


LAND SURVEYING . SUBDIVIDING . LAND PLANNING

LAKE GENEVA, WISCONSIN 53147

DRIVE

000

133.

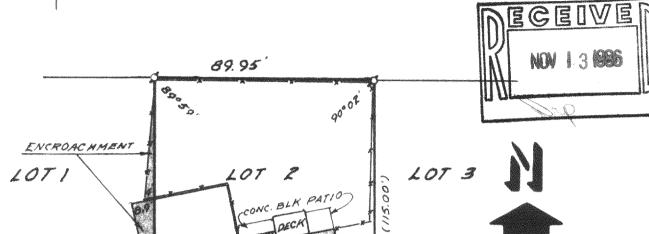

DECH

SCALE: 1"=40'

OVERHEAD UTILITY LINES

ENCROACHMENT OF GRAVE PR.

OVERHEAP OTILITY LINES

DRIVE HILLCREST 50' WIDE

Ø

PLAT OF SURVEY OF

LOT 2, ADDITION "D" TO COUNTRY CLUB ESTATES, VILLAGE OF FONTANA-ON-GENEVA LAKE, WALWORTH COUNTY, WISCONSIN.

JUNE 18, 1986

ORDERED BY: KEEFE REAL ESTATE, INC.

BOX L ABBEY SPRINGS FONTANA, WI. 53125

RELOCATED ALL CORNERS.

Harold HAROLD H. KOLB

ORDERED BY: ANCHOR SAVINGS & LOAN ASSOCIATION 500 E. WALWORTH AVE. DELAVAN, WI. 53115

OWNER: JEFFERY BAKER ROUTE 3, BOX 150C FONTANA, WI. 53125

Margaretti Markette

LEGEND IRON PIPE FOUND Ø FENCE (72') AS RECORDED

I HEREBY CERTIFY THAT I HAVE SURVEYED THE ABOVE DESCRIBED PROPERTY AND THAT THE ABOVE MAP IS A TRUE REPRESENTATION THEREOF AND SHOWS THE SIZE AND LOCATION OF THE PROPERTY ITS EXTERIOR BOUNDARIES, THE LOCATION OF ALL VISIBLE STRUCTURES AND DIMENSIONS OF ALL PRINCIPAL BUILDINGS THEREON, BOUNDARY FENCES APPARENT EASEMENTS, ROADWAYS AND VISIBLE ENCROACHMENTS, IF ANY.

THIS SURVEY IS MADE FOR THE USE OF THE PRESENT OWNERS OF THE PROPERTY, AND ALSO THOSE WHO PURCHASE, MORTGAGE, OR GUARANTEE THE TITLE THERETO WITHIN ONE (1) YEAR FROM THE DATE HEREOF.

HAROLD H. KOLB WISCONSIN REGISTERED LAND SURVEYOR, S- 187

MARCH 30, 1984

REVISED: JUNE 18, 1986

5-67/K FONT-212