

GEORGE T. DUNHAM
SURVEYING & SUBDIVIDING
DELAVER, WISCONSIN

N




Scale - 1" = 20'

● = Concrete Monument

○ = Iron Pipe

GENEVA

BOULEVARD

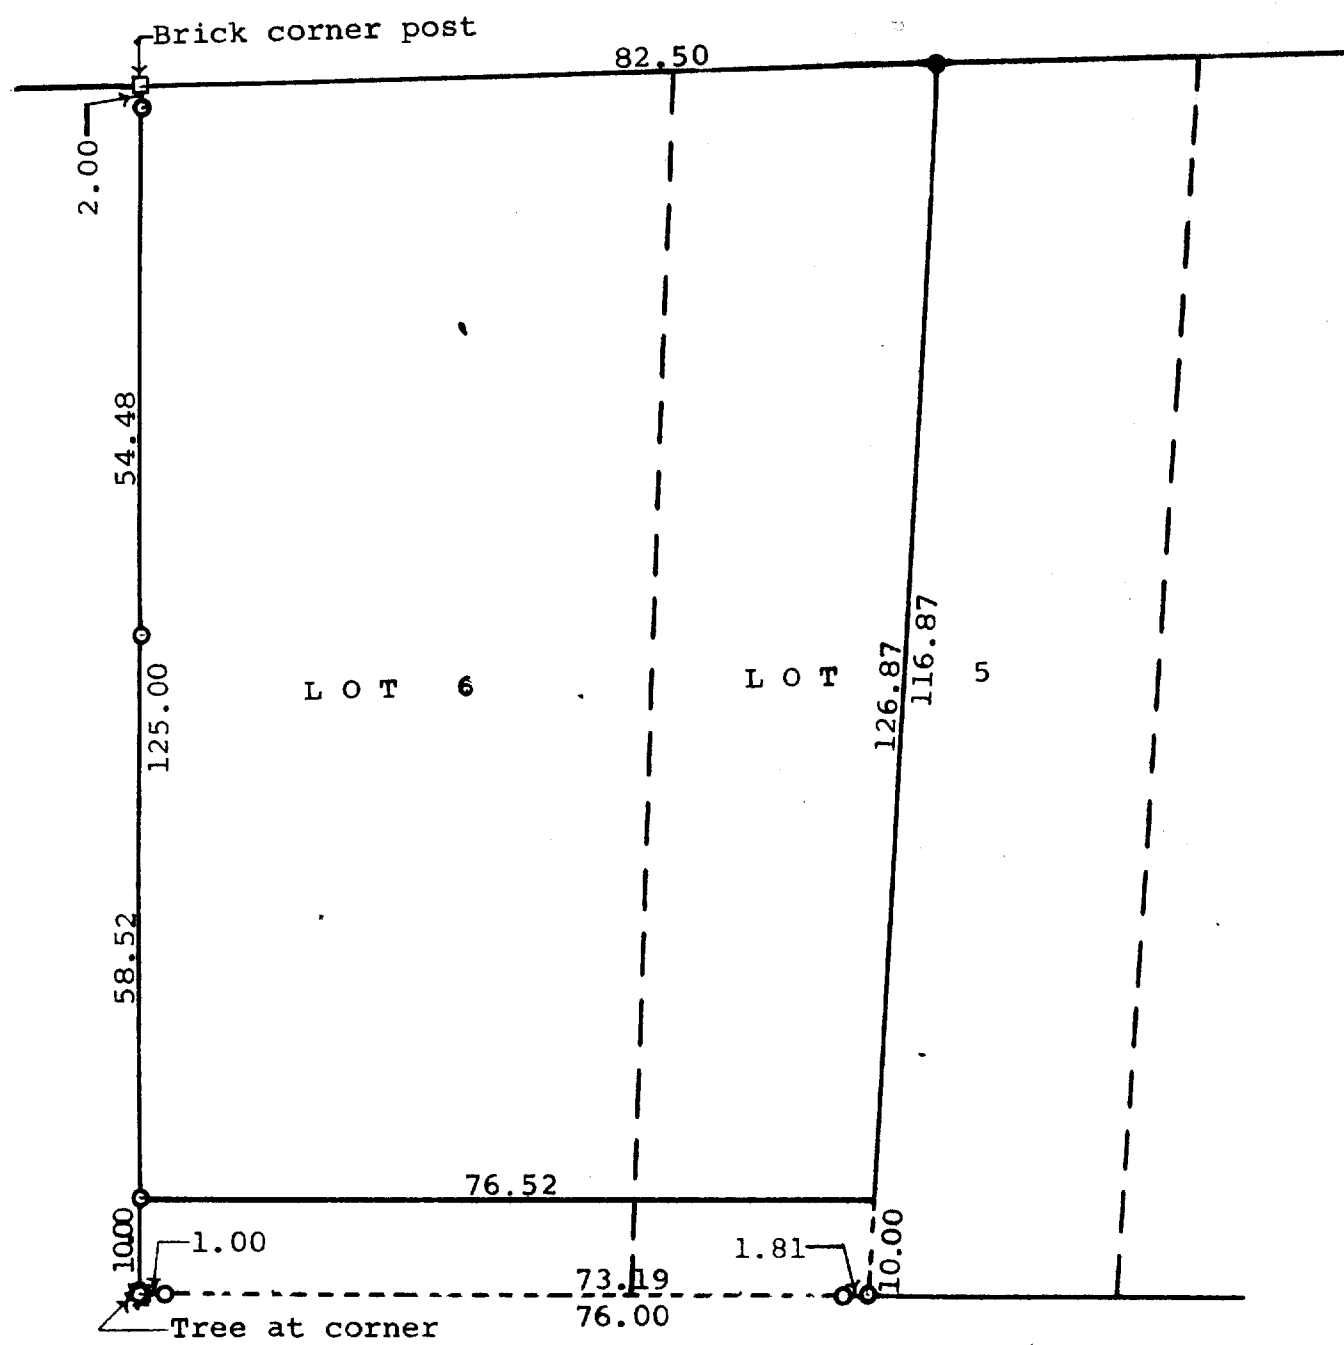

Plat of survey of Lot 6 and the West 1/2 of Lot 5, Blk. 6, Indian Hills
Subdivision, Village of Fontana, Walworth County, Wisconsin, EXCEPTING
therefrom the South 10.00 feet of said Lots.
August 6, 1964
Revised June 2, 1967

George T. Dunham
George T. Dunham, Surveyor