
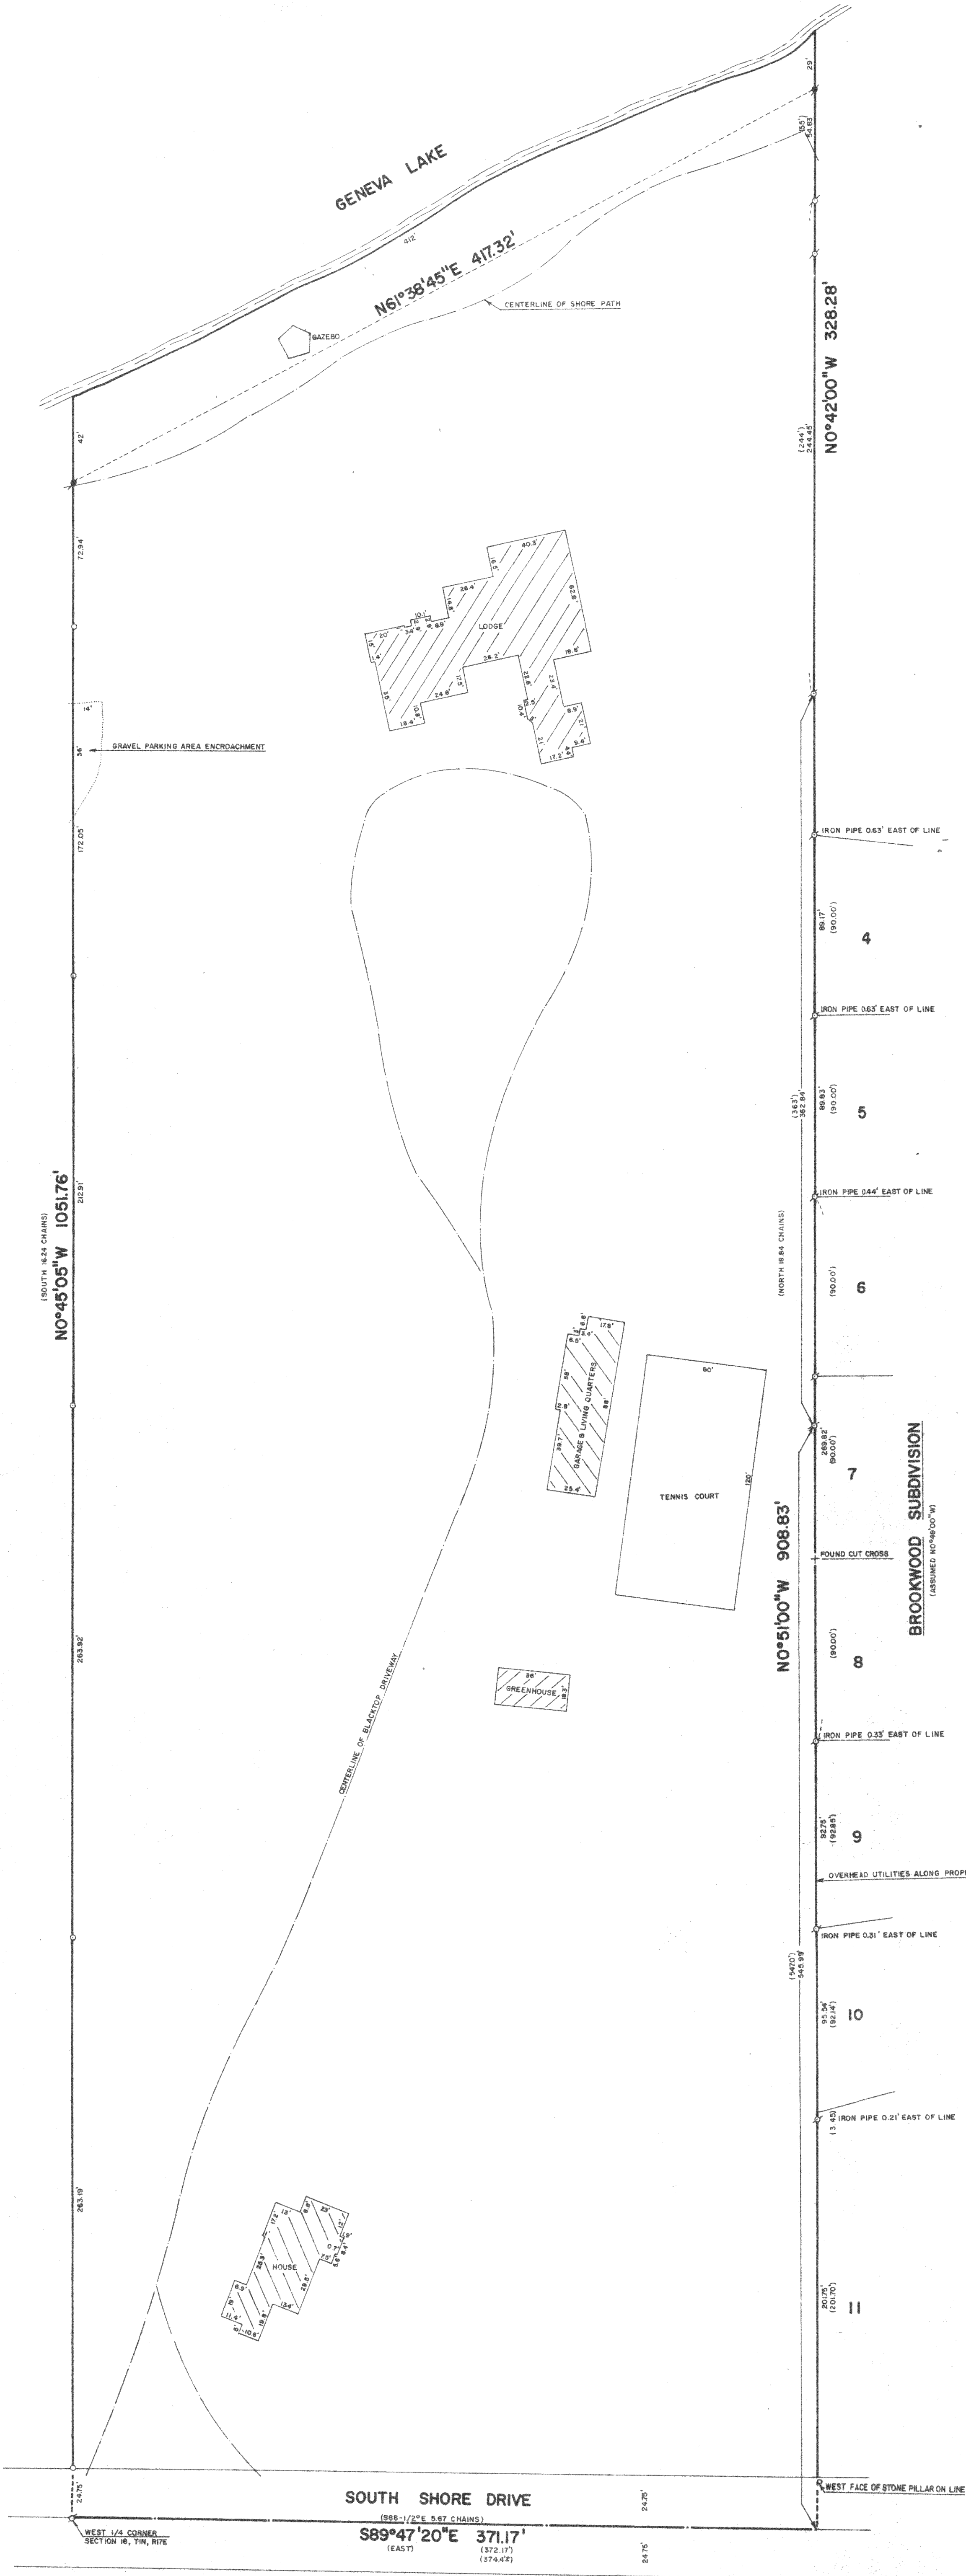


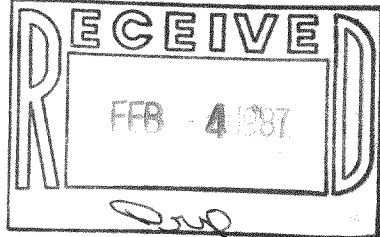

PLAT OF SURVEY OF

ALL THAT CERTAIN PIECE OR PARCEL OF LAND LYING AND BEING IN THE TOWN OF LINN, COUNTY OF WALWORTH AND STATE OF WISCONSIN DESCRIBED AS FOLLOWS, TO-WIT: COMMENCING AT THE LAKE SHORE AT A STAKE ON THE TOWN LINE BETWEEN LINN AND WALWORTH, WHOSE BEARINGS ARE SUGAR 8 INCH DIAMETER S 46° EAST 38 LINKS DISTANT, ALSO ASPEN 10 INCH DIAMETER S 36° WEST 35 LINKS DISTANT; THENCE SOUTH 16 CHAINS AND 24 LINKS TO THE 1/4 POST BETWEEN SECTION 18, T1N, R17E, AND SECTION 13, T1N, R16E, WHOSE BEARINGS ARE WHITE OAK 10 INCH DIAMETER S 42° WEST 61 LINKS DISTANT; THENCE S88 1/2° EAST 5 CHAINS AND 67 LINKS TO A STAKE, WHOSE BEARINGS ARE LYNN 5 INCH DIAMETER N 61° EAST 51 LINKS DISTANT, ALSO SUGAR 8 INCH DIAMETER N 17° WEST 83 LINKS DISTANT; THENCE NORTH 18 CHAINS 84 LINKS TO A STAKE ON THE LAKE SHORE, WHOSE BEARINGS ARE WHITE OAK 12 INCH DIAMETER S 36° EAST 14 LINKS DISTANT; ALSO BLACK OAK 12 INCH DIAMETER S 36° EAST 14 LINKS DISTANT; THENCE WEST ALONG THE LAKE SHORE TO THE PLACE OF BEGINNING. SAID PARCEL BEING THE WEST PART OF THE NW 1/4 OF SECTION 18, T1N, R17E.

ORDERED BY: ESSANESS THEATRES CORPORATION
54 WEST RANDOLPH
CHICAGO, ILLINOIS 60601


NOTE: THE EASTERLY LINE OF THIS PROPERTY WAS SURVEYED USING MONUMENTATION AS DESCRIBED IN VOLUME 210 OF DEEDS, PAGE 60 AS DOCUMENT 278603 AND ALSO AS DESCRIBED IN AN AFFIDAVIT BY CHARLES R. FISCHER, RECORDED JULY 2, 1966 IN VOLUME 664 OF DEEDS ON PAGE 301 AS DOCUMENT NO. 603966.

NOTE: THE EASTERLY LINE OF THIS PROPERTY IS MARKED BY A CHAIN LINK FENCE ON THE PROPERTY LINE.

I HEREBY CERTIFY THAT I HAVE SURVEYED THE ABOVE DESCRIBED PROPERTY AND THAT THE ABOVE MAP IS A TRUE REPRESENTATION THEREOF AND SHOWS THE SIZE AND LOCATION OF THE PROPERTY, ITS EXTERIOR BOUNDARIES, THE LOCATION OF ALL VISIBLE STRUCTURES AND DIMENSIONS OF ALL PRINCIPAL BUILDINGS THEREON, BOUNDARY FENCES, APPARENT EASEMENTS, ROADWAYS AND VISIBLE ENCROACHMENTS, IF ANY.

THIS SURVEY IS CERTIFIED TO THE FOLLOWING:

ESSANESS THEATRES CORPORATION
NORTHERN TRUST COMPANY
CHICAGO TITLE INSURANCE COMPANY
Robert M. Baerwald
ROBERT M. BAERWALD
WISCONSIN REGISTERED LAND SURVEYOR, S-1508
DATE Dec. 22, 1936 JOB NO. 0856

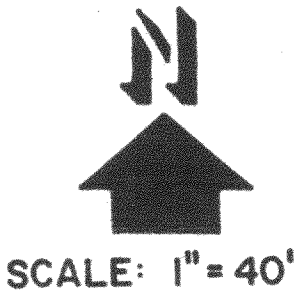

SCALE: 1" = 40'

□ - IRON PIPE FOUND
■ - CONCRETE MONUMENT FOUND
○ - IRON ROD PLACED
() - RECORDED AS