



DUNHAM SURVEYING, S.C.
SURVEYING & SUBDIVIDING
DELAVER, WISCONSIN 53115

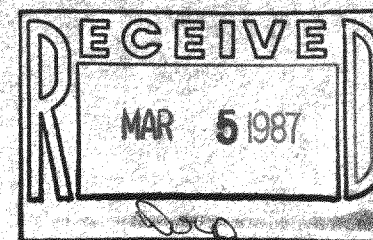

PONTANA

AVENUE

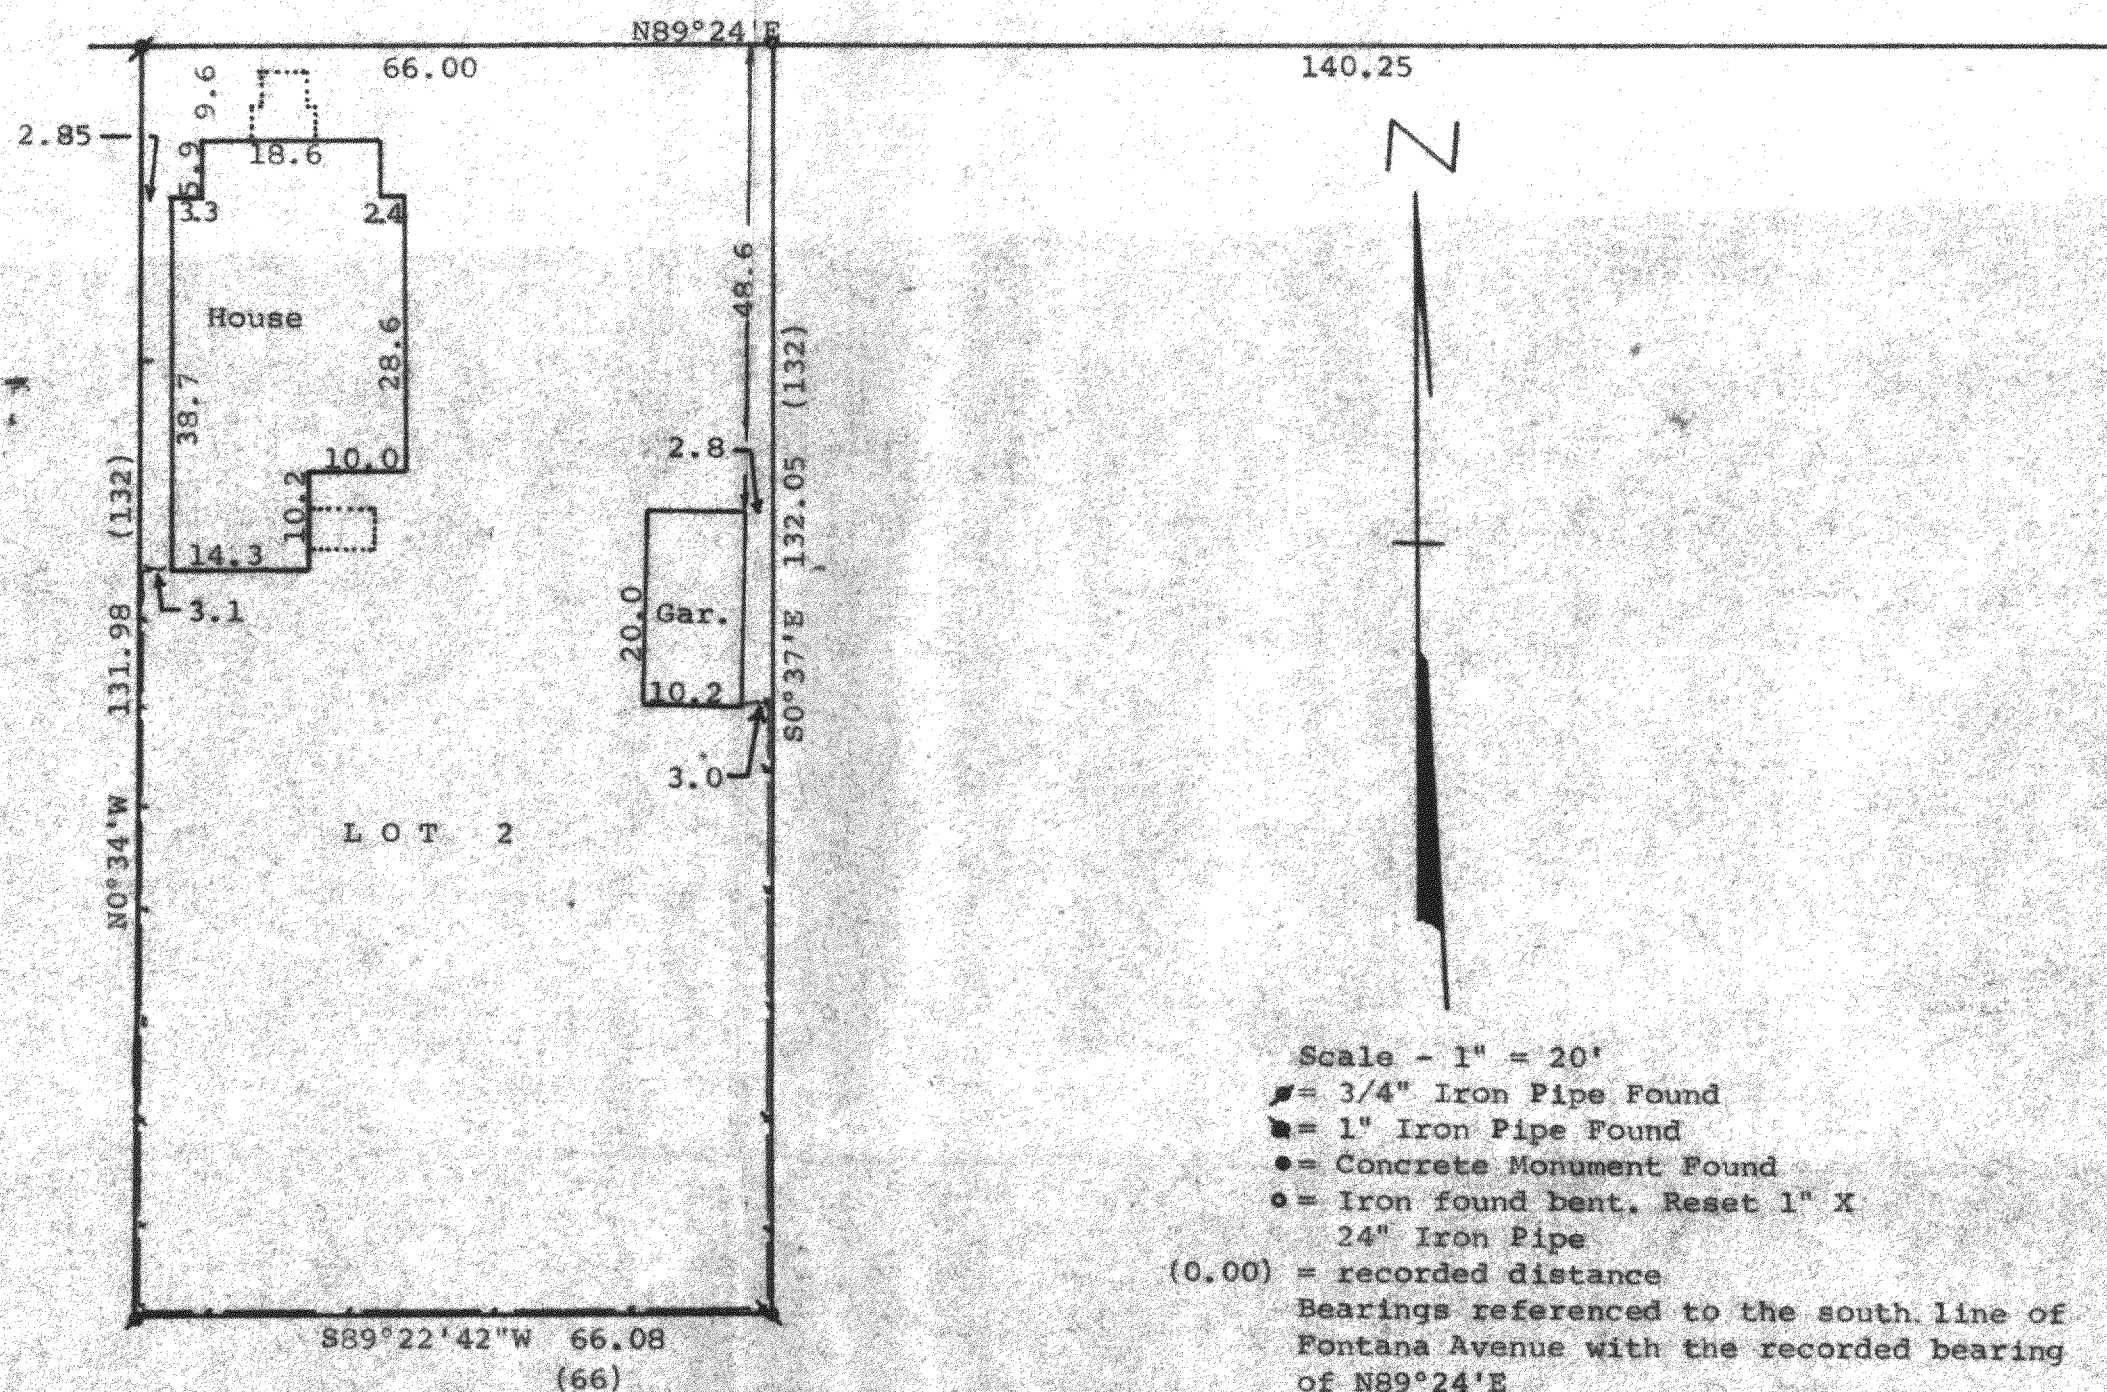

Scale - 1" = 20'
 3/4" Iron Pipe Found
 1" Iron Pipe Found
 Concrete Monument Found
 Iron found bent. Reset 1" X 24" Iron Pipe
 (0.00) = recorded distance
 Bearings referenced to the south line of Pontana Avenue with the recorded bearing of N89°24'E
 Survey ordered by: Churchill Real Estate
 322 Park
 Walworth, WI 53184
 --- Fence Line

STATE OF WISCONSIN) ss
COUNTY OF WALWORTH)

I, George T. Dunham, Surveyor, certify that I have surveyed the property described as follows:
 Lot 2, Block 5 of Assessor's Plat No. 1, C.L. Douglass Addition to the Village of Pontana, Walworth County, Wisconsin, and that the map shown hereon is a true representation thereof and shows the size and location of the property, its exterior boundaries, the location of all visible structures and dimensions of all principal buildings thereon, boundary fences, apparent easements, roadways and visible encroachments, if any, and that I have surveyed the property hereon described according to the official records, to the best of my knowledge and belief.
 August 28, 1986.

George T. Dunham
George T. Dunham, Surveyor

