


LOT 99

LOT 98

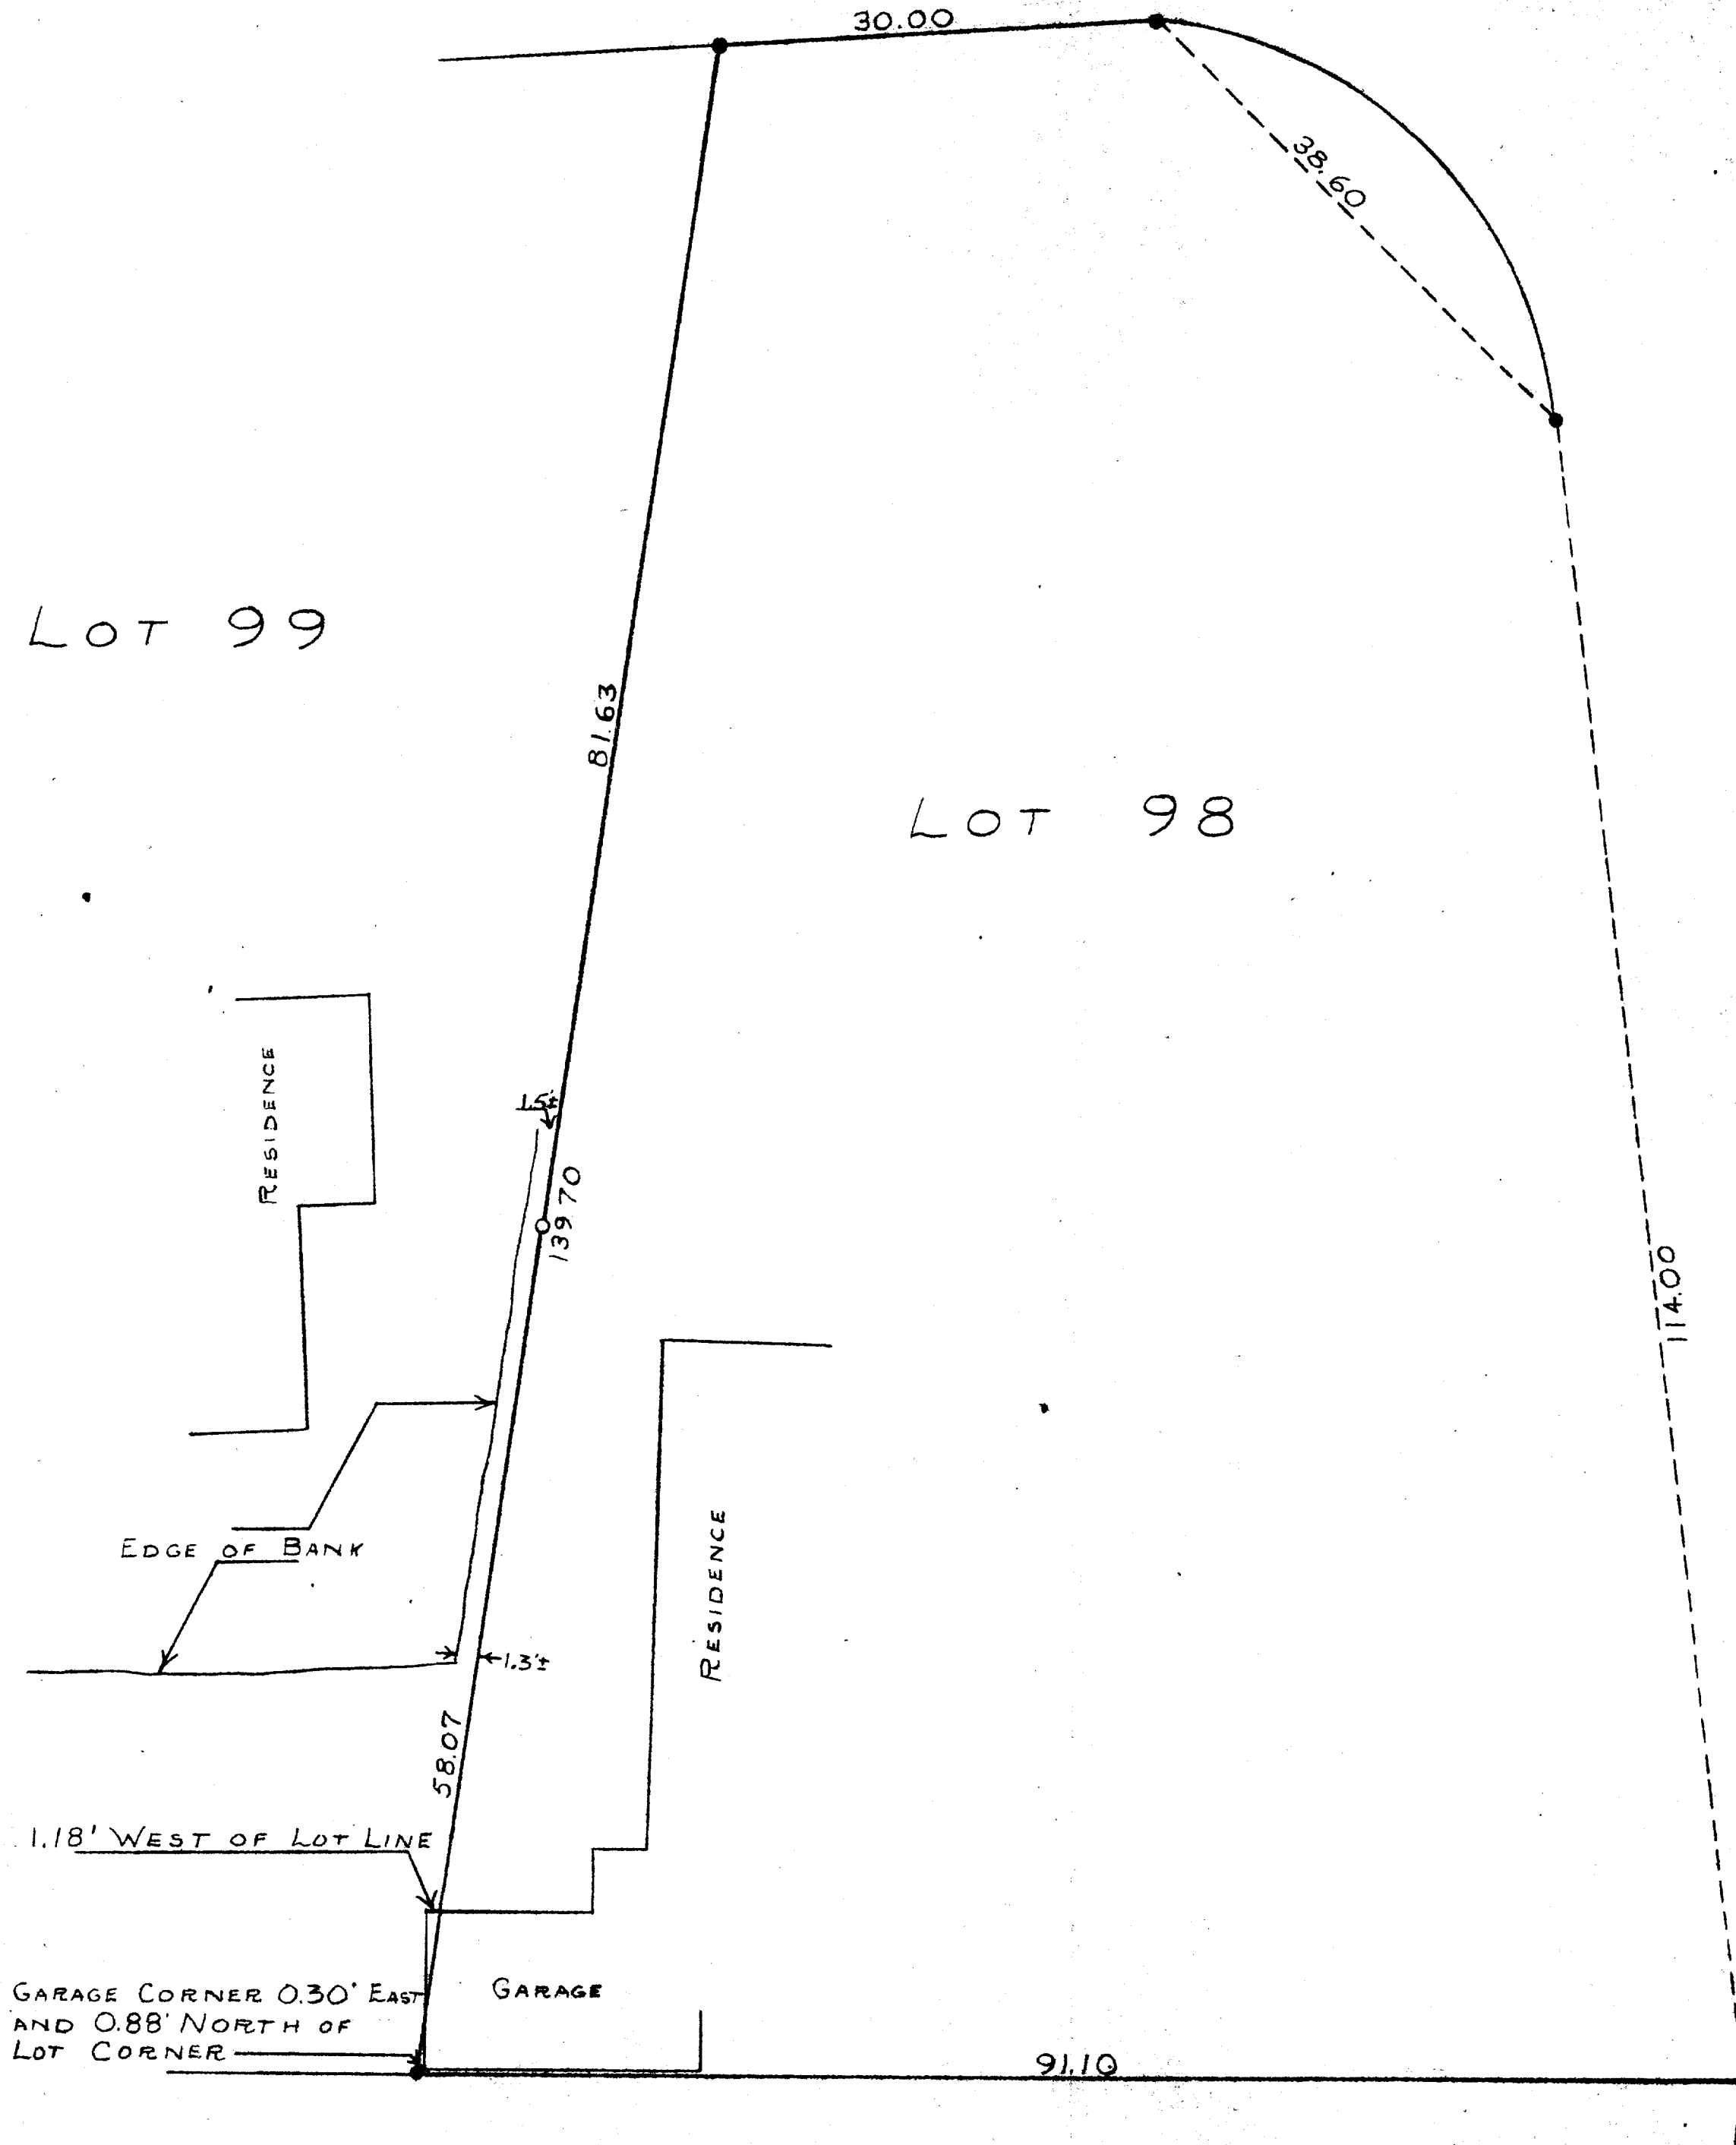

SCALE-1"=10'
●=CONC. MONU.
○=IRON PIPE

PLAT OF SURVEY OF LOT 98 LOCATED IN COUNTRY CLUB
ESTATES UNIT NO. 2 OF FONTANA ON GENEVA LAKE,
WALWORTH COUNTY, WISCONSIN
OCTOBER, 1952

George T. Blumhagen
SURVEYOR

5-7

SC02-92