
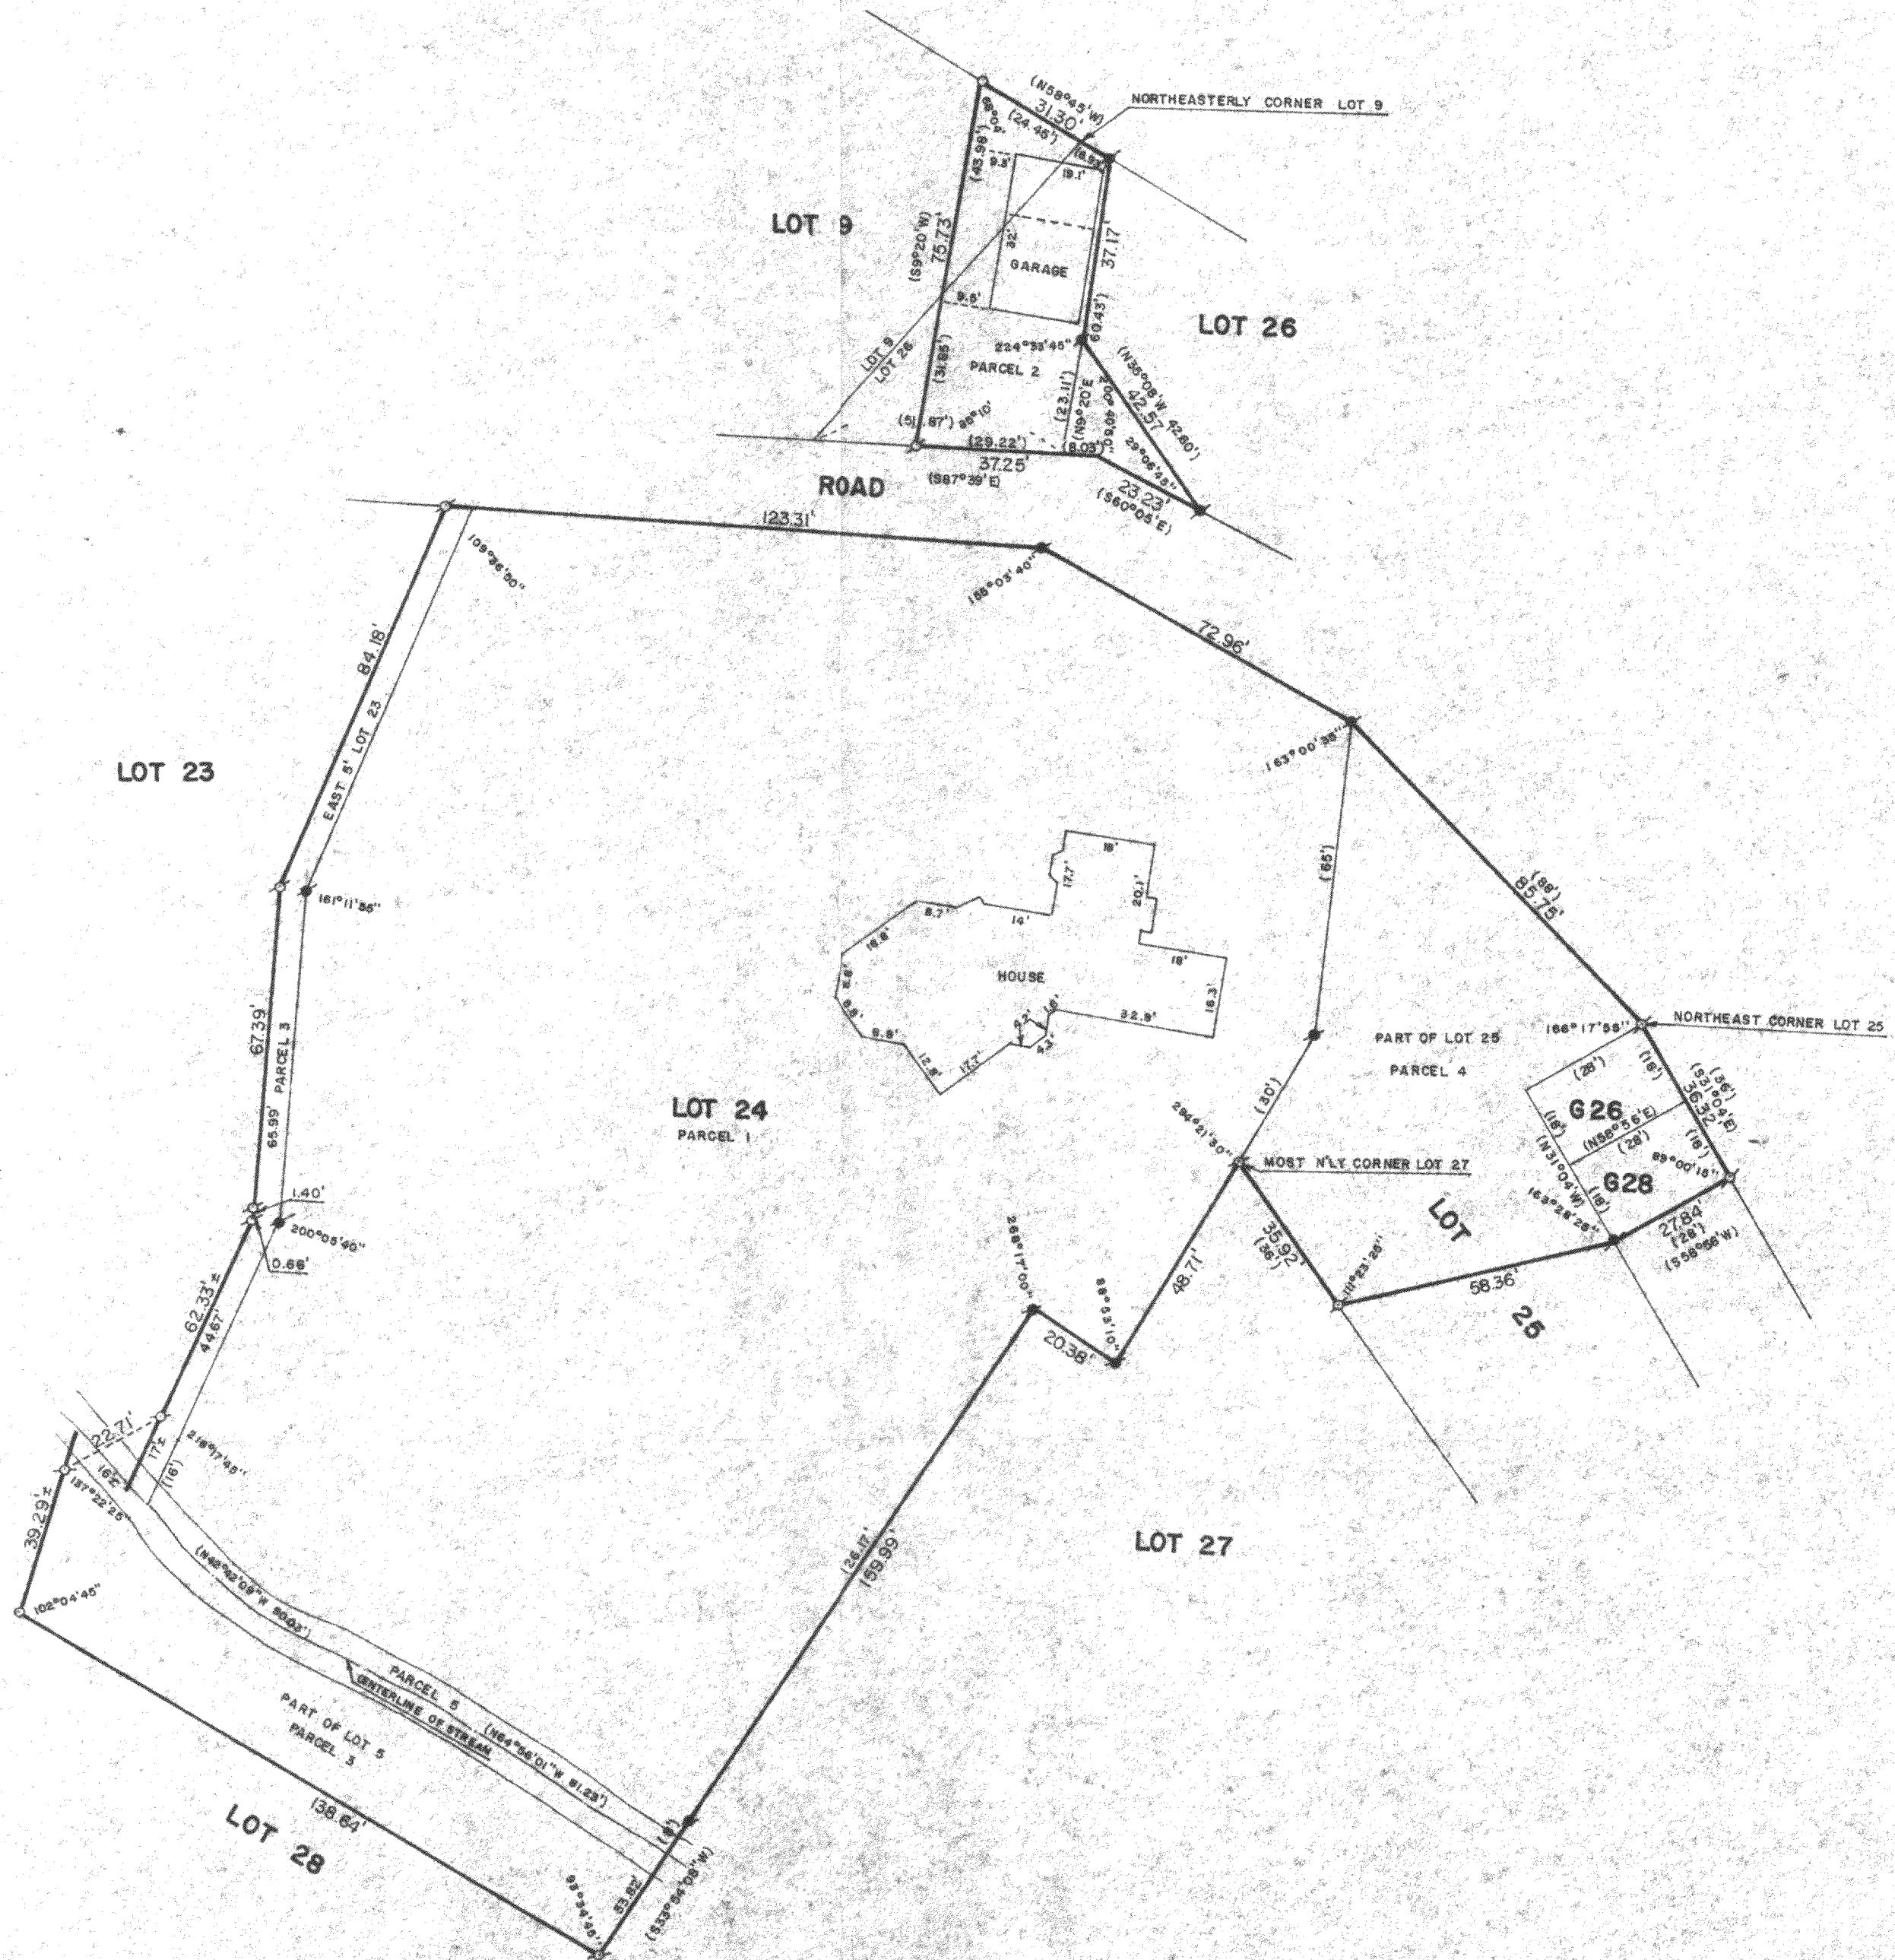


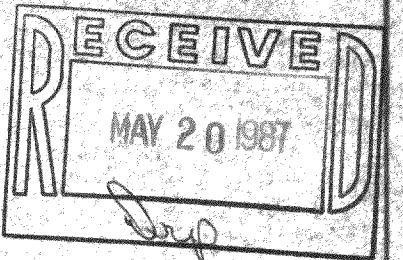

PLAT OF SURVEY OF

LOT 24, PART OF LOTS 5, 9, 23, 25, 26, ALL OF LOT G26 AND G28
OF THE REVISED PLAT OF "THE GARDENS" SUBDIVISION, LOCATED IN
SECTION 11, T 1 N, R 16 E, VILLAGE OF FONTANA-CN-GENEVA LAKE,
WALWORTH COUNTY, WISCONSIN.

ORDERED BY: LAKELAND REAL ESTATE
BOX 323
FONTANA, WISCONSIN

NOTE: PARCEL NUMBERS ON THIS PLAT REFER TO PARCEL NUMBERS AS
AS SHOWN IN THE DEED DESCRIPTION, DOCUMENT NO. 05978.



SCALE: 1"=30'

⊕ - IRON PIPE FOUND
* - CONCRETE MONUMENT FOUND
○ - IRON ROD PLACED
() - RECORDED AS

I, ROBERT M. BAERENWALD, DO HEREBY CERTIFY THAT I
HAVE SURVEYED THE PROPERTY HEREON DESCRIBED ACCORDING
TO THE OFFICIAL RECORDS AND THAT THE PLAT HEREON IS A
CORRECT REPRESENTATION OF THE PROPERTY LINES TO THE
BEST OF MY KNOWLEDGE AND BELIEF.

Robert M. Baerenwald
ROBERT M. BAERENWALD
WISCONSIN REGISTERED LAND SURVEYOR, S-1508

DATE *May 3, 1987* JOB NO. 1003