


DUNHAM SURVEYING, S.C.
SOUTHERN LAKES REAL ESTATE INVESTMENTS
FONTANA, WISCONSIN 53125

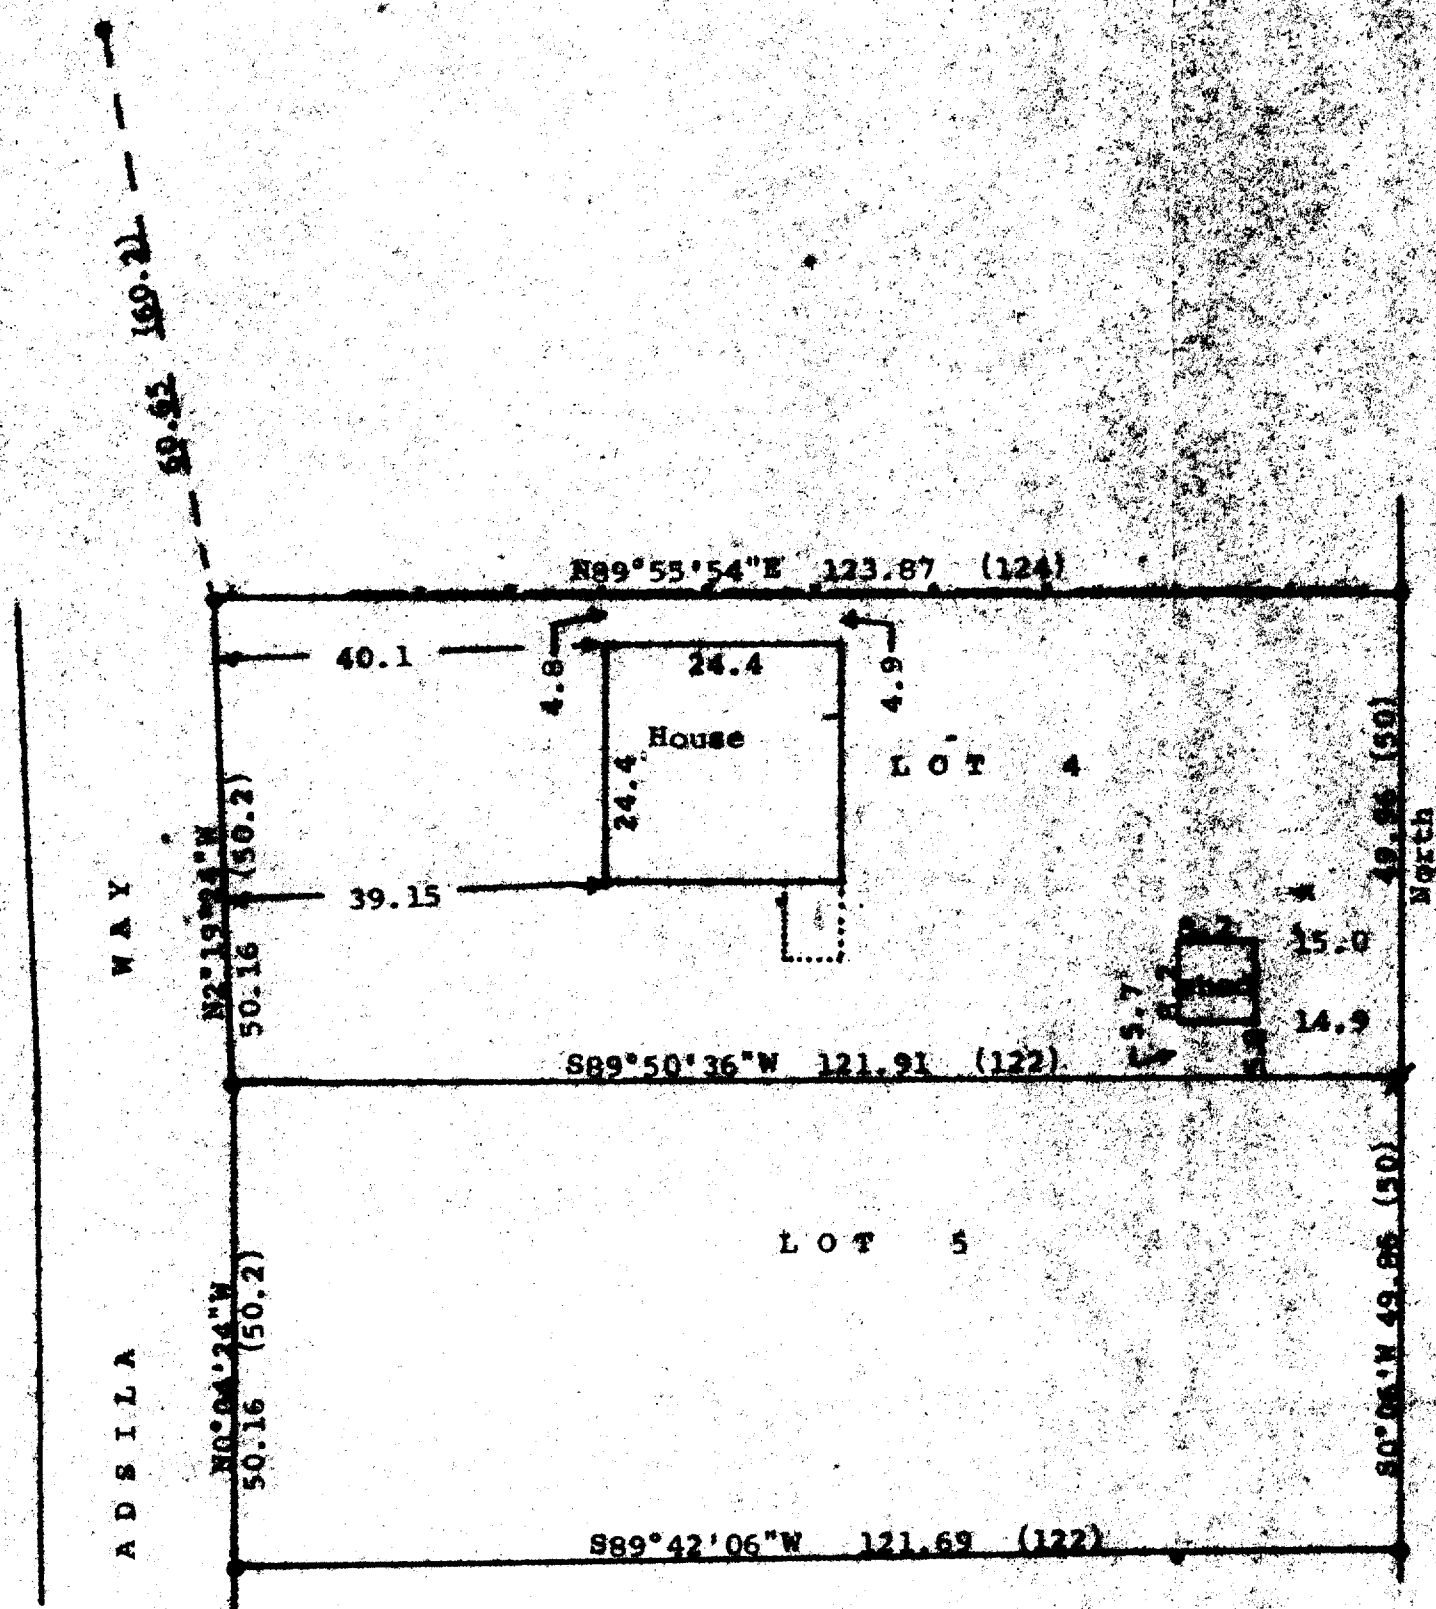

Scale - 1" = 20'
 o = 3/4" Iron Pipe Found
 p = 1" Iron Pipe Found
 e = 1 1/4" Iron Pipe Found
 (00.0) = recorded distance
 - - - = fence line
 Bearings referenced to the assumed bearing of North along the east line of Lot 4
 Survey ordered by:
 Southern Lakes Real Estate Investments
 P.O. Box 52
 Fontana, WI 53125

STATE OF WISCONSIN)
 COUNTY OF WALWORTH)

I, George T. Dunham, Surveyor, certify that I have surveyed the property described as follows:
 Lots 4 and 5 in Block 7 of Indian Hills 1st Addition to the Village of Fontana, Geneva Lake, Walworth County, Wisconsin, and that the map shown hereon is a correct representation thereof and shows the size and location of the property, its exterior boundaries, the location of all visible structures and dimensions of all principal buildings thereon, boundary fences, apparent easements, roadways and visible encroachments, if any, and that I have surveyed the property hereon described, according to the official records, to the best of my knowledge and belief.
 July 9, 1987

George T. Dunham
 George T. Dunham, Surveyor

