


GENEVA LAKE

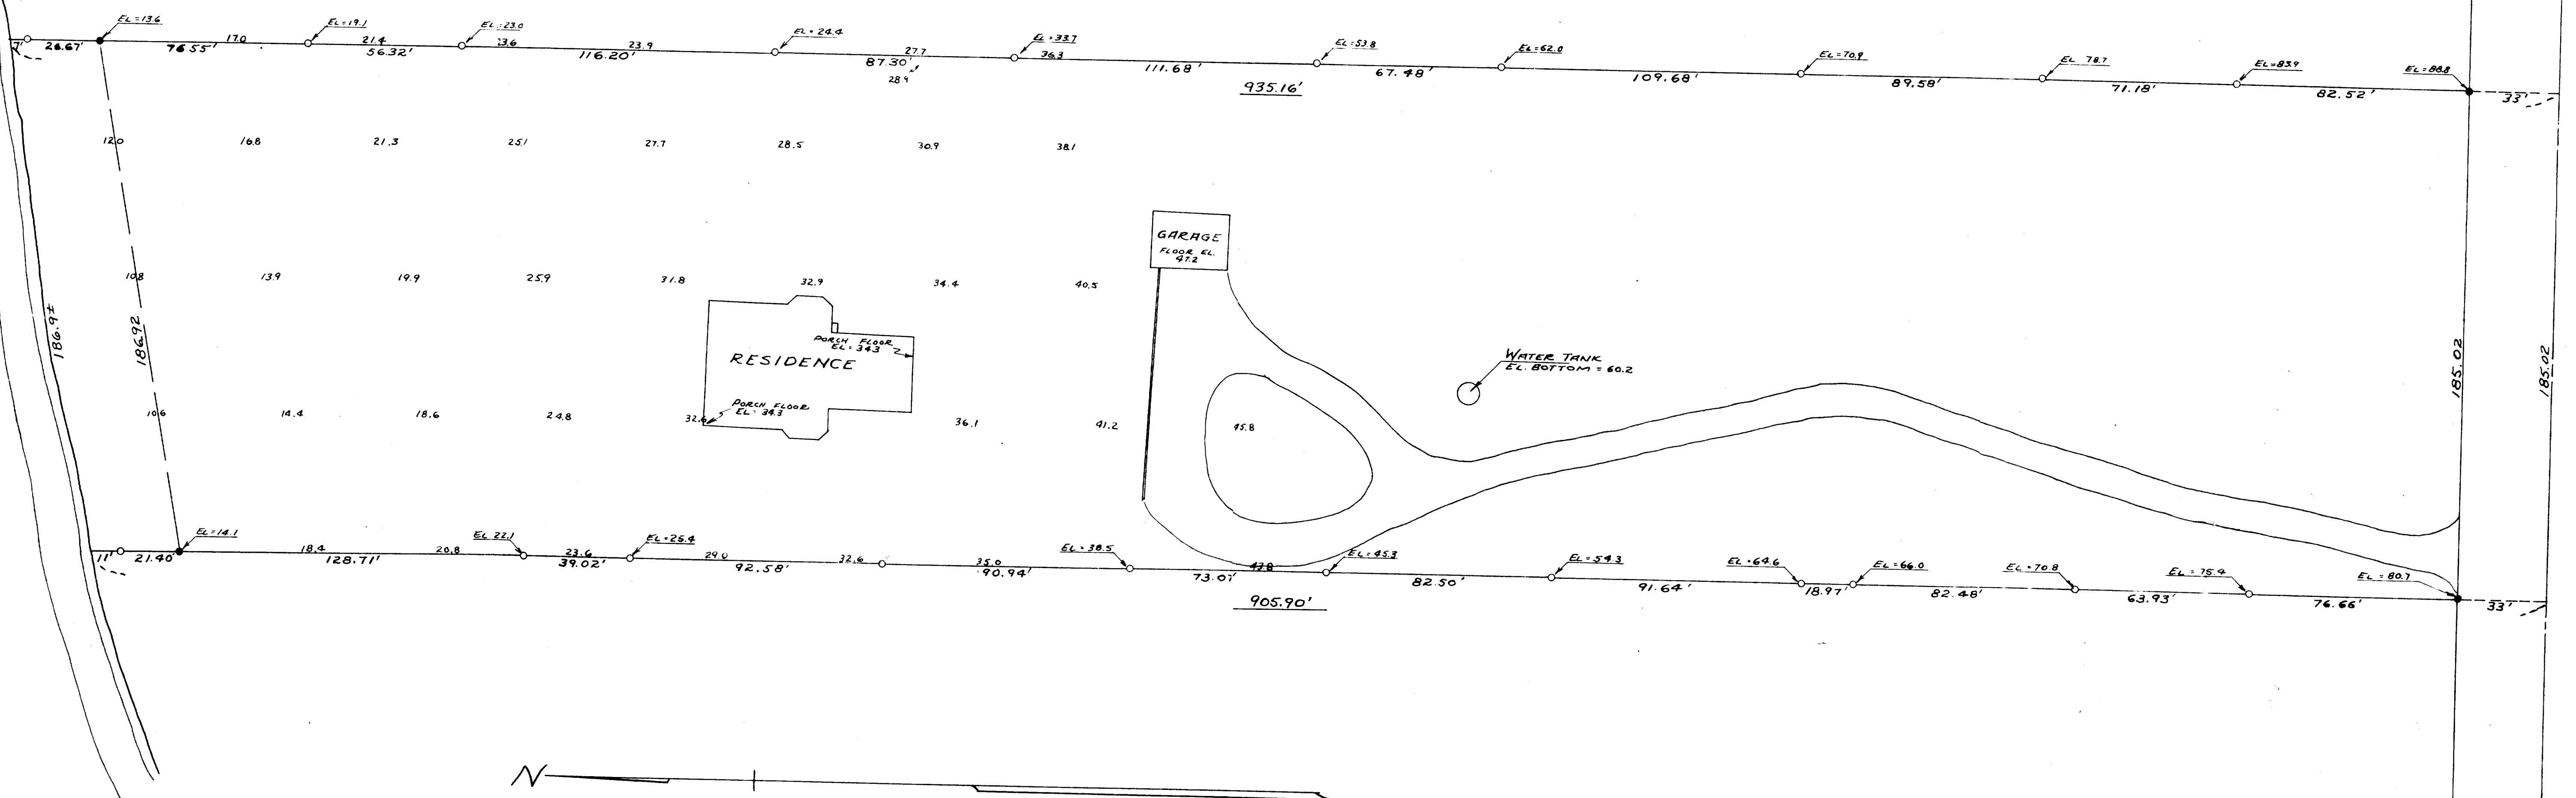

SCALE - 1" = 30'
 O = IRON PIPE
 • = CONCRETE MONUMENT
 NOTE: ALL ELEVATIONS ARE OF THE GROUND
 UNLESS OTHERWISE NOTED, AND ARE SHOWN
 IN FEET ABOVE THE LAKE LEVEL AS OF
 JULY 19, 1949.
 THE ELEVATION OF THE SHOWER IN THE
 2ND FLOOR BATH IS 51.2' ABOVE LAKE LEVEL

EAST 1/4 SECTION CORNER OF
 SECTION 13, TINRIGE

EAST LINE OF SECTION 13,
 TINRIGE, WALWORTH CO., WIS.

EAST-WEST 1/4 SECTION LINE
 OF SECTION 13, TINRIGE

ROAD

PUBLIC

PROPERTY OWNED BY ROBERT M. HENOLD LOCATED IN THE NE 1/4 OF SECTION 13, TINRIGE IN FONTANA- ON GENEVA LAKE, WALWORTH COUNTY, WIS.		
PLAT OF SURVEY		
DRAWN BY R. LYNEIS	JENSEN & JOHNSON CIVIL ENGINEERS ELKHORN, WIS.	SCALE: 1" = 30'
CHECKED BY J.R. BIRCH		AUGUST, 1949
APPROVED BY R.E. Johnson		SHEET NO. 1 OF 1