
WALWORTH COUNTY SURVEYING & MAPPING LAKE GENEVA, WISCONSIN

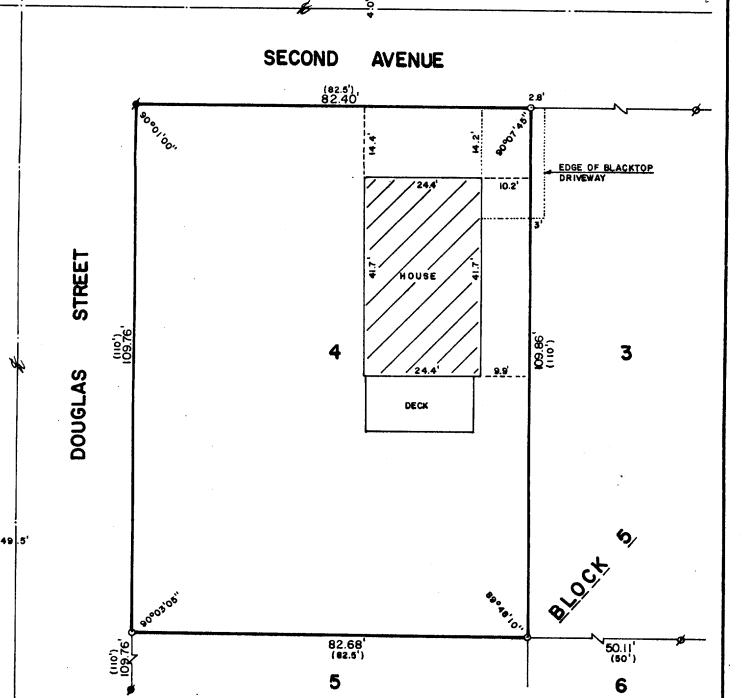

PLAT OF SURVEY OF

LOT 4, BLOCK 5 OF THE ORIGINAL PLAT OF THE VILLAGE OF FONTANA-ON-GENEVA LAKE, WALWORTH COUNTY, WISCONSIN.

ORDERED BY: CICIO

1526 WILLIAMS STREET RIVER FOREST, ILLINOIS 60305



SCALE: 1"=20'

ø - IRON ROD FOUND

☞ -CONCRETE MONUMENT FOUND

o - IRON ROD PLACED

()-RECORDED AS

I, ROBERT M. BAERENWALD, DO HEREBY CERTIFY THAT I HAVE SURVEYED THE PROPERTY HEREON DESCRIBED ACCORDING TO THE OFFICIAL RECORDS AND THAT THE PLAT HEREON IS A CORRECT REPRESENTATION OF THE PROPERTY LINES TO THE BEST OF MY KNOWLEDGE AND BELIEF.

ROBERT M. BAERENWALD

WISCONSIN REGISTERED LAND SURVEYOR, S-1508

DATE JOB NO. 0726

NOTE: THIS IS NOT A CERTIFIED COPY UNLESS SEALED.

50P-30