

NEWPORT PLACE

BLOCK 14

3

22'

(95')
95.04'

59.1'

22.8'

24.8'

24.8'

22.8'

GARAGE

4

CONCRETE DRIVEWAY

90°22'29"

5

HOUSE

52.2'

28.7'

28.7'

21.6'

23.7'

5.9'

3.6'

3.6'

6.9'

10.2'

9.9'

40.5'

80.24' (80')

9.4'

80.53' (80')

6.3'

80°22'29"

5.8'

1.4'

75.7'

95.18' (95')

2.6'

2.6'

4.3'

4.08'

90°24'50"

DECK

WOOD RETAINING WALL

SOUTH FACE OF 1.2' WIDE STONE RETAINING WALL


EAST FACE OF STONE RETAINING WALL

LINDEN AVENUE

(30')

6

LOTS 4 AND 5, BLOCK 14 OF GLENWOOD
SPRINGS, LOCATED IN THE VILLAGE OF
FONTANA-ON-GENEVA LAKE, WALWORTH
COUNTY, WISCONSIN.

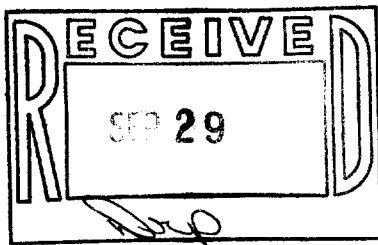

♂ - IRON PIPE FOUND
 ♀ - CONCRETE MONUMENT FOUND
 ○ - IRON ROD PLACED
 () - RECORDED AS

Robert M. Baerenwald
ROBERT M. BAERENWALD
WISCONSIN REGISTERED LAND SURVEYOR, S-1508

DATE JOB NO. 1222

NOTE: THIS IS NOT A CERTIFIED COPY UNLESS SEALED.