


KOLB LAND CONSULTING, INC.
LAND SURVEYING • SUBDIVIDING • LAND PLANNING

929 WILLIAMS STREET

LAKE GENEVA, WISCONSIN 53147

414-248-3697

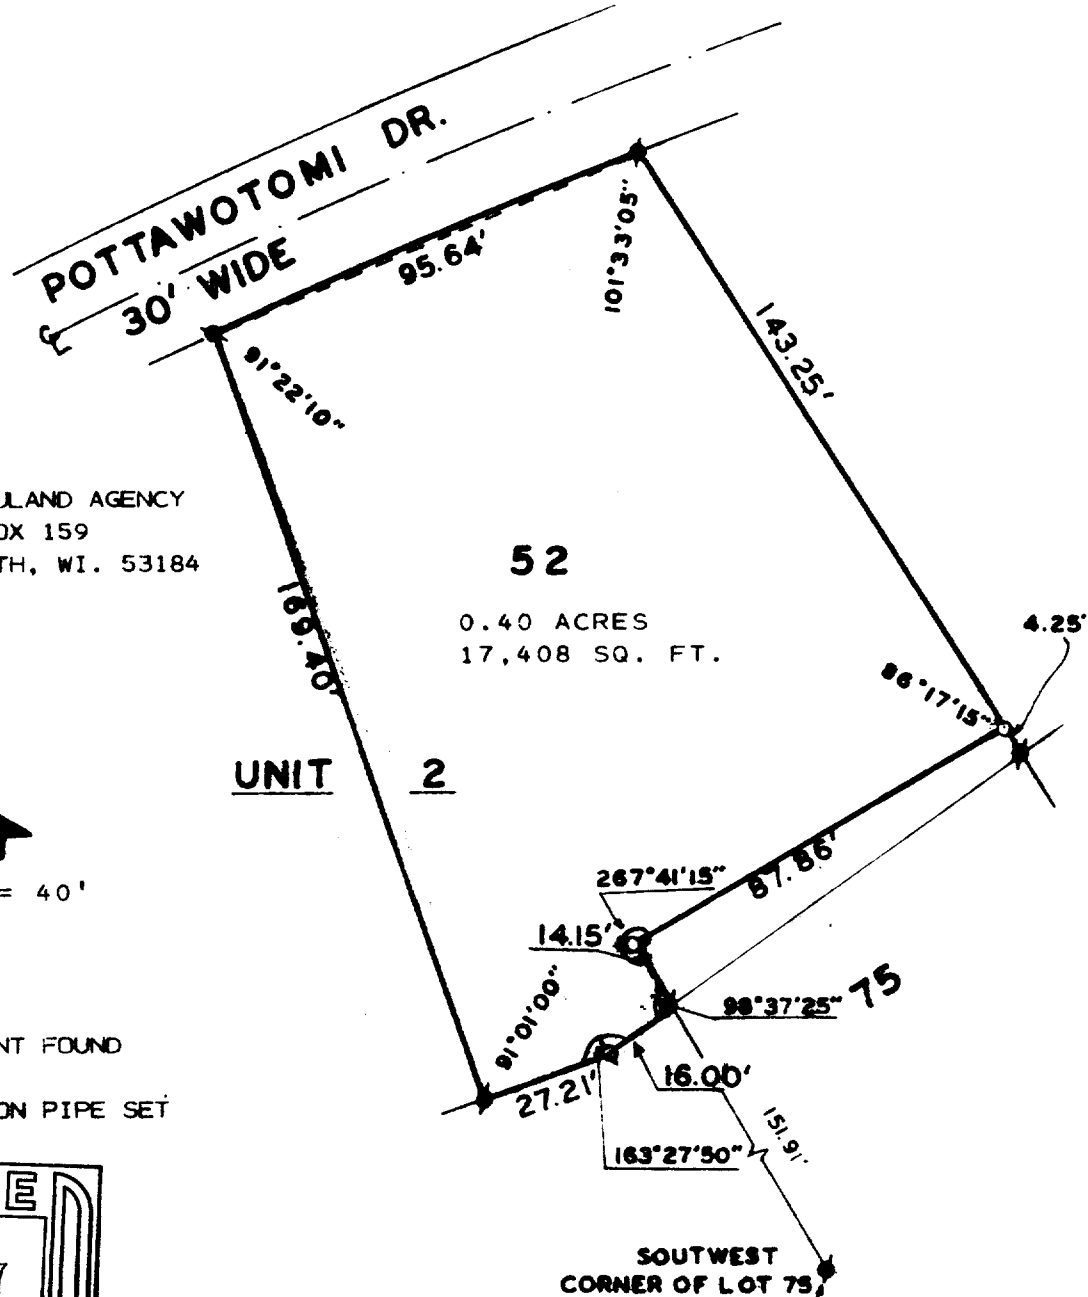


ORDERED BY: THE RAULAND AGENCY
P.O. BOX 159
WALWORTH, WI. 53184




SCALE: 1" = 40'

LEGEND

- - CONCRETE MONUMENT FOUND
- - IRON PIPE FOUND
- - 1 1/4" X 24" IRON PIPE SET

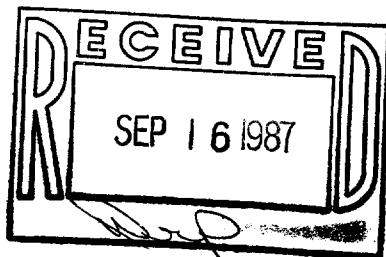

I, HAROLD H. KOLB, DO HEREBY CERTIFY THAT I HAVE SURVEYED THE PROPERTY HEREON DESCRIBED ACCORDING TO THE OFFICIAL RECORDS, AND THAT THE PLAT HEREON IS A CORRECT REPRESENTATION OF THE LOT LINES TO THE BEST OF MY KNOWLEDGE AND BELIEF.

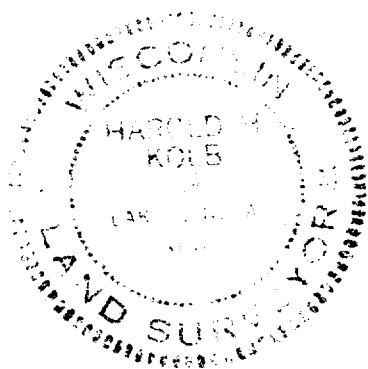

Harold H. Kolb

HAROLD H. KOLB

WISCONSIN REGISTERED LAND SURVEYOR, 'S-187

DATE OCTOBER 18, 1985

REVISED APRIL 24, 1986

REVISED