


RECEIVED
JAN 12 1963

JAN 1 2 1963

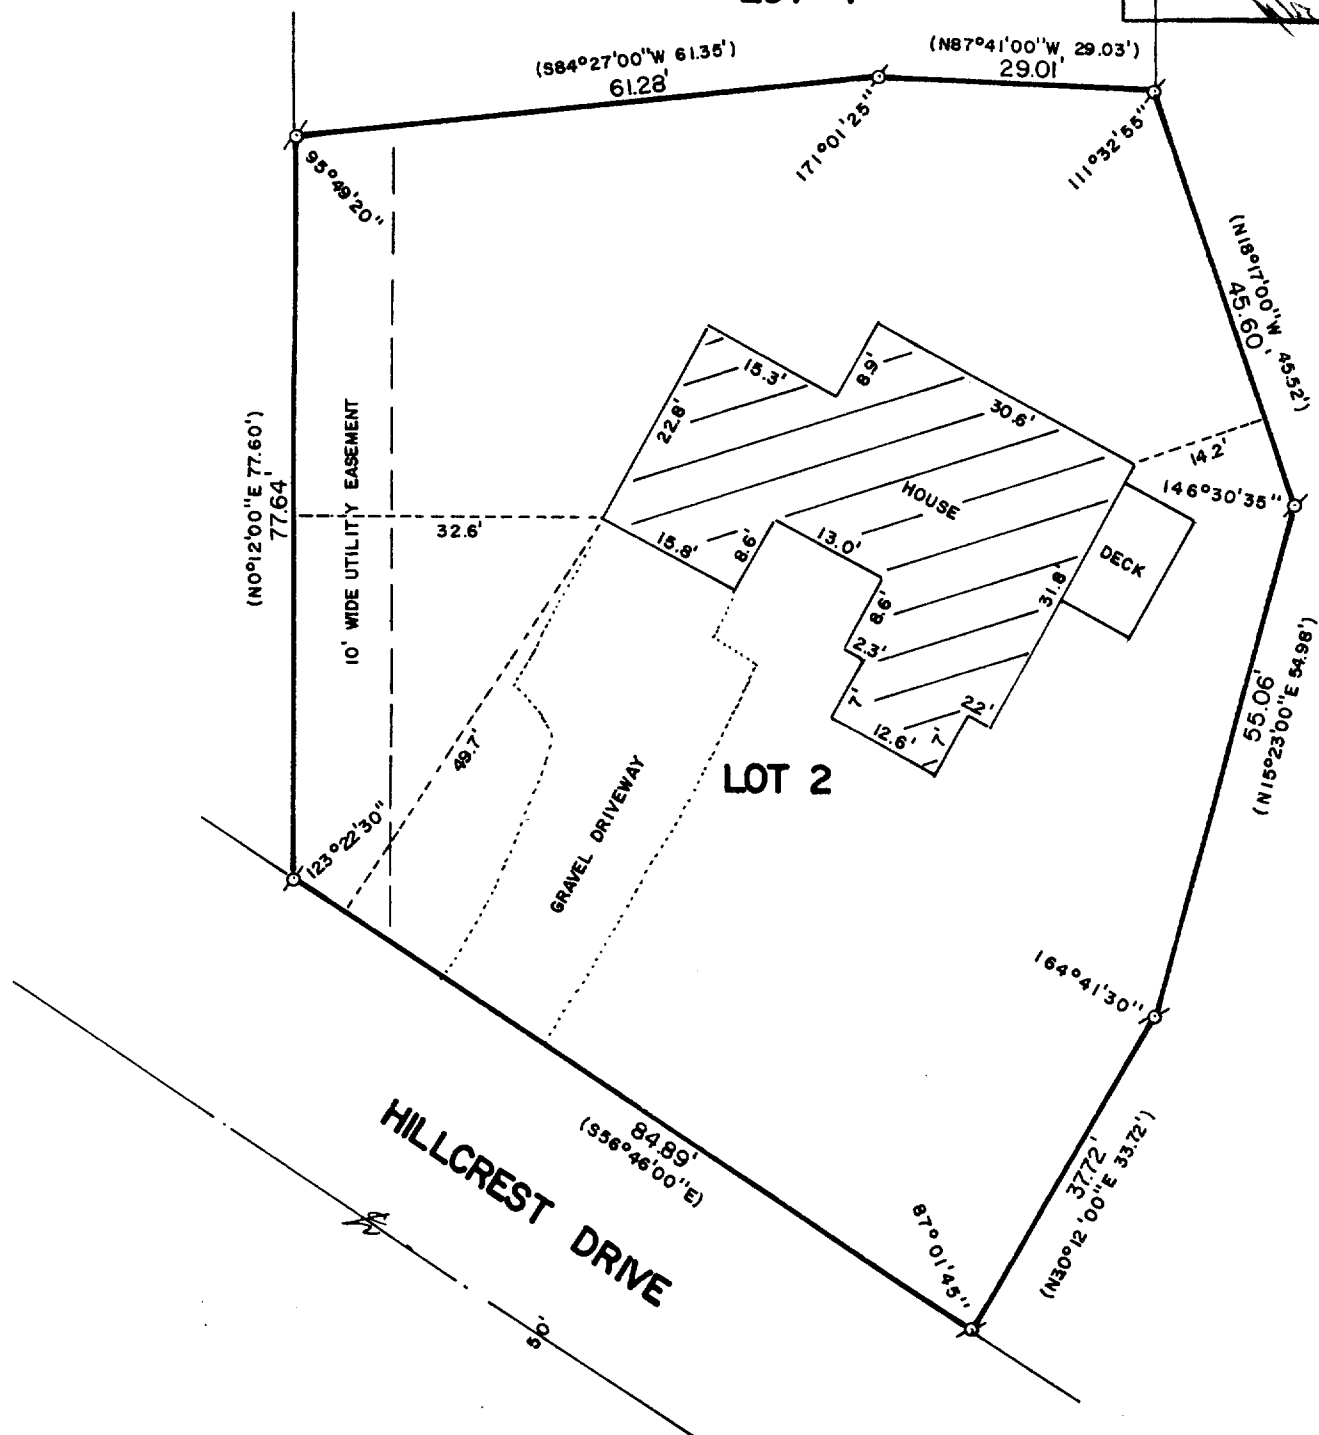

LOT 2 OF CERTIFIED SURVEY MAP NO. 1110,
LOCATED IN THE VILLAGE OF FONTANA-ON-
GENEVA LAKE, WAIWORTH COUNTY, WISCONSIN.

ORDERED BY: KEEFE REAL ESTATE
P. O. BOX 266
WALWORTH, WISCONSIN



I, ROBERT M. BAERENWALD, DO HEREBY CERTIFY THAT I HAVE SURVEYED THE PROPERTY HEREON DESCRIBED ACCORDING TO THE OFFICIAL RECORDS AND THAT THE PLAT HEREON IS A CORRECT REPRESENTATION OF THE PROPERTY LINES TO THE BEST OF MY KNOWLEDGE AND BELIEF.

Robert M. Baerenwald
ROBERT M. BAERENWALD
WISCONSIN REGISTERED LAND SURVEYOR, S-1508

DATE Oct. 7, 1987 JOB NO. 1023

NOTE: THIS IS NOT A CERTIFIED COPY UNLESS SEALED.