

ABELL SURVEYING & MAPPING DELAVAN, WISCONSIN 53115 414-728-6737

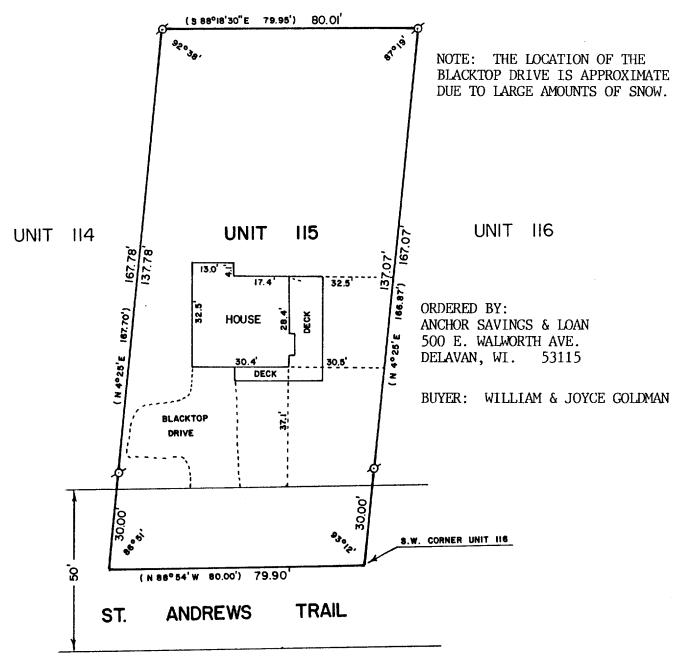

PLAT OF SURVEY OF

UNIT 115 OF ABBEY SPRINGS

A PARCEL OF LAND LOCATED IN THE SOUTHWEST 1/4 OF THE SOUTHWEST 1/4 OF SECTION 18, TOWN 1 NORTH, RANGE 17 EAST, VILLAGE OF FONTANA-ON-GENEVA LAKE, WALWORTH COUNTY, WISCONSIN, BEING MORE PARTICULARLY DESCRIBED AS FOLLOWS: BEGINNING AT THE SOUTHWEST CORNER OF UNIT 116 OF ABBEY SPRINGS; THENCE N 88°54' W 80.00 FEET; THENCE N 4°25' E 167.70 FEET; THENCE S 88°18'30" E 79.95 FEET; THENCE S 4°25' W 166.87 FEET TO THE PLACE OF BEGINNING, CONTAINING 0.3067 ACRES MORE OR LESS.

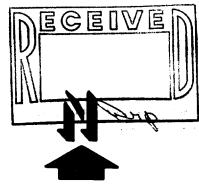

1"=30' SCALE

LEGEND Ø - IRON PIPE FOUND ()- RECORDED AS

I, DAVID F. ABELL, DO HEREBY CERTIFY THAT I HAVE SURVEYED THE PROPERTY HEREON DESCRIBED ACCORDING TO THE OFFICIAL RECORDS AND THAT THE PLAT HEREON IS A CORRECT REPRESENTATION OF THE PROPERTY LINES TO THE BEST OF MY KNOWLEDGE AND BELIEF.

Navid 7. abell
DAVID F. ABELL

WISCONSIN REGISTERED LAND SURVEYOR, S-1596

1988 DATE

JOB NUMBER -88012 THIS IS NOT A CERTIFIED COPY UNLESS SEALED. 5-814 NOTE: