


RECEIVED  
MAY 9 1968  
*[Signature]*

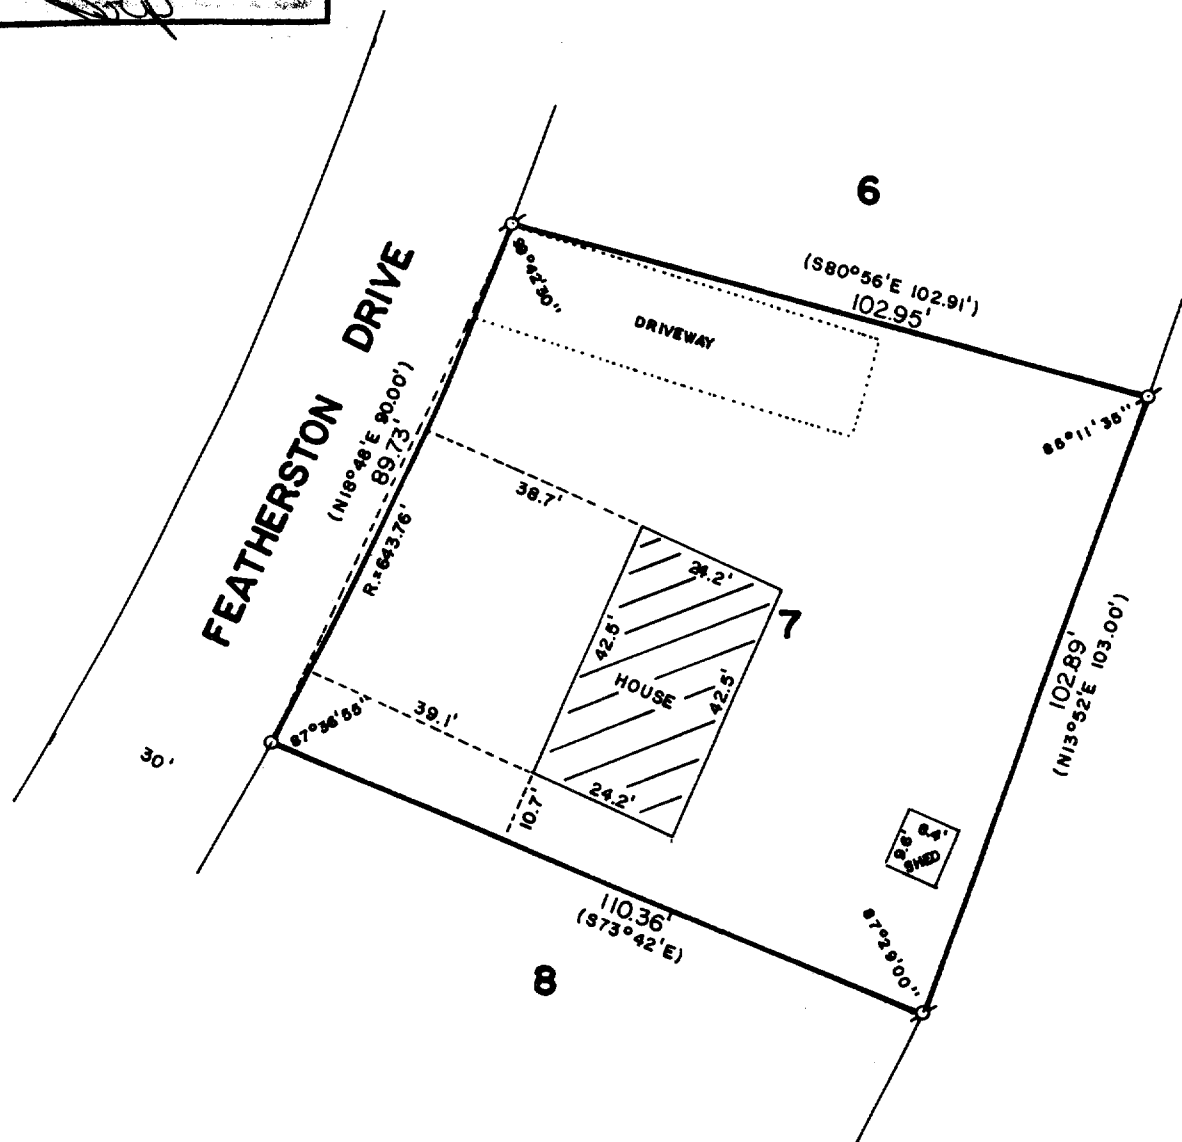

LOT 7 OF ADDITION "A" TO COUNTRY CLUB  
ESTATES, LOCATED IN THE VILLAGE OF  
FONTANA-ON-GENEVA LAKE, WALWORTH COUNTY,  
WISCONSIN.

♂ - IRON PIPE FOUND  
○ - IRON ROD PLACED  
( ) - RECORDED AS

Robert M. Baerenwald  
ROBERT M. BAERENWALD  
WISCONSIN REGISTERED LAND SURVEYOR, S-1508

DATE Feb. 9, 1988 JOB NO. 1415

NOTE: THIS IS NOT A CERTIFIED COPY UNLESS SEALED.

SC-TA-7