


  
 SCALE 1"=20'  
 1"=100.00'  
 • = CORNER MONUMENT

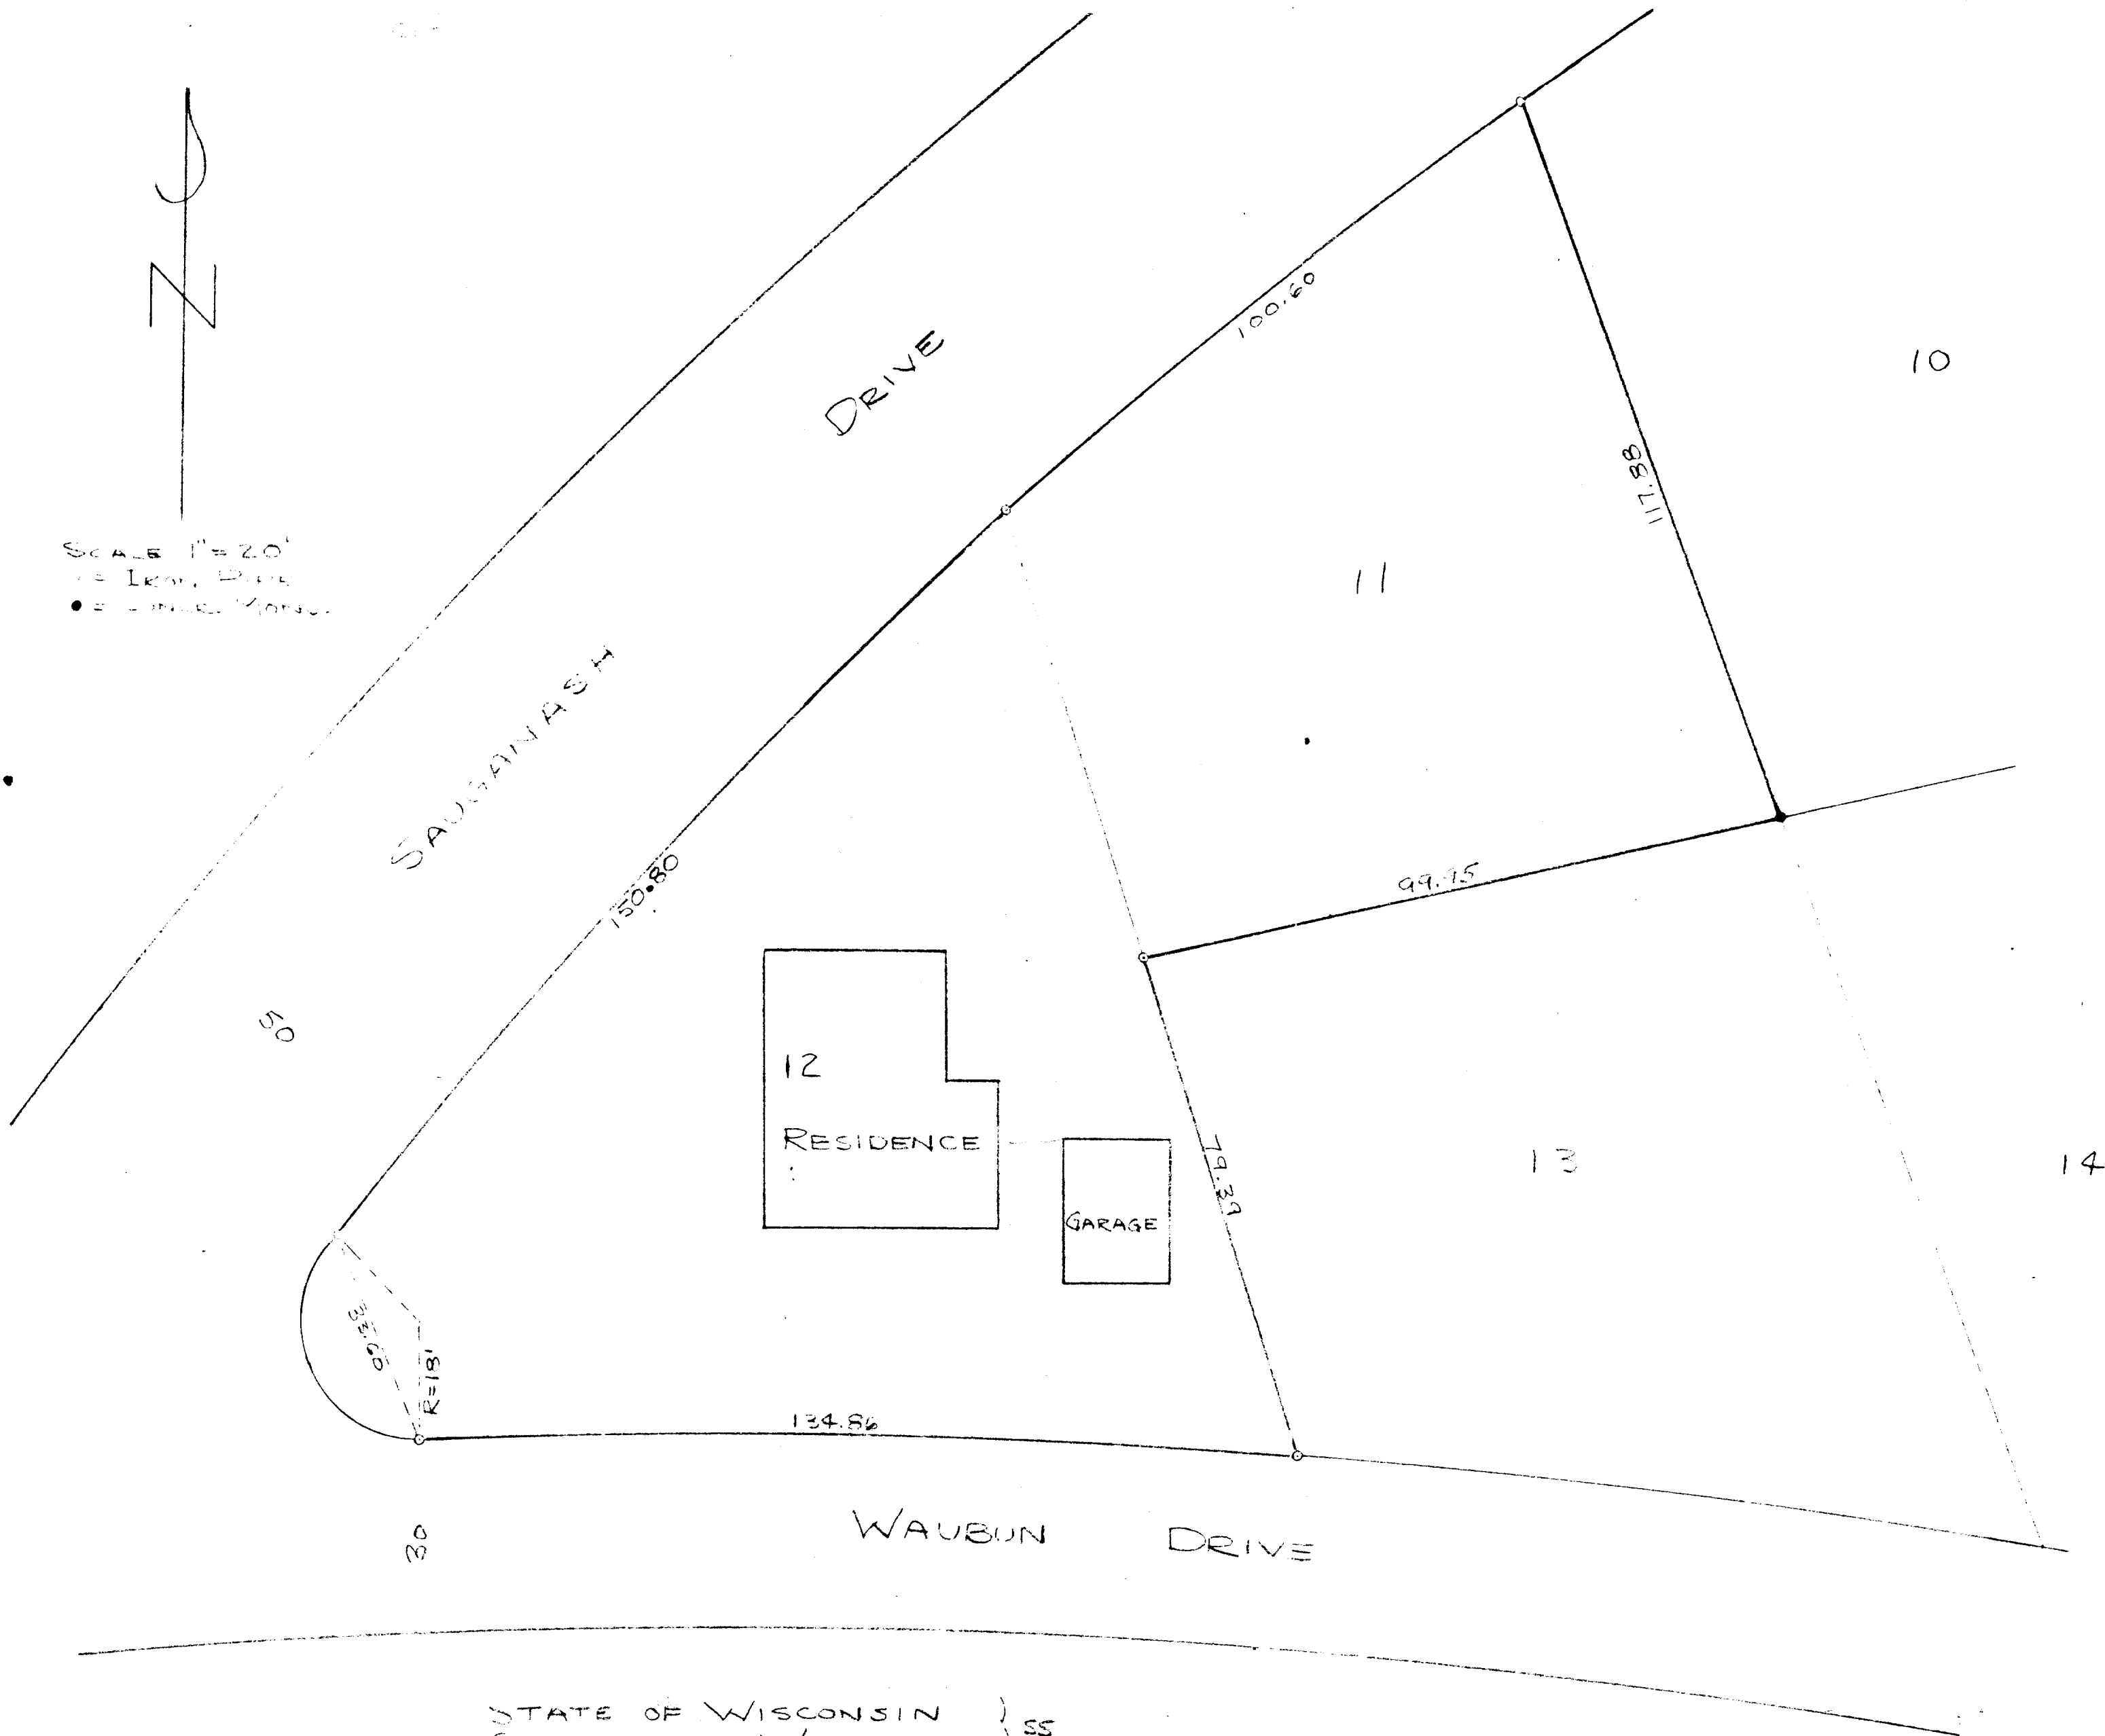

STATE OF WISCONSIN )  
 COUNTY OF WALWORTH ) SS

I, LLOYD L. JENSEN, DO HEREBY CERTIFY THAT I HAVE SURVEYED THE PROPERTY DESCRIBED, ACCORDING TO THE OFFICIAL RECORDS, AS FOLLOWS:

LOTS 11 & 12 OF UNIT 2 OF COUNTRY CLUB  
 ESTATES, A SUBDIVISION IN FONTANA-ON GENEVA  
 LAKE, WALWORTH COUNTY, WISCONSIN,  
 AND THAT THE PLAT SHOWN ABOVE IS A CORRECT REPRESENTATION OF THE LOT LINES AND THE PRINCIPAL LINES OF BUILDINGS TO BE LOCATED THEREON.

MAY 2, 1951

*Lloyd L. Jensen*  
 COUNTY SURVEYOR