


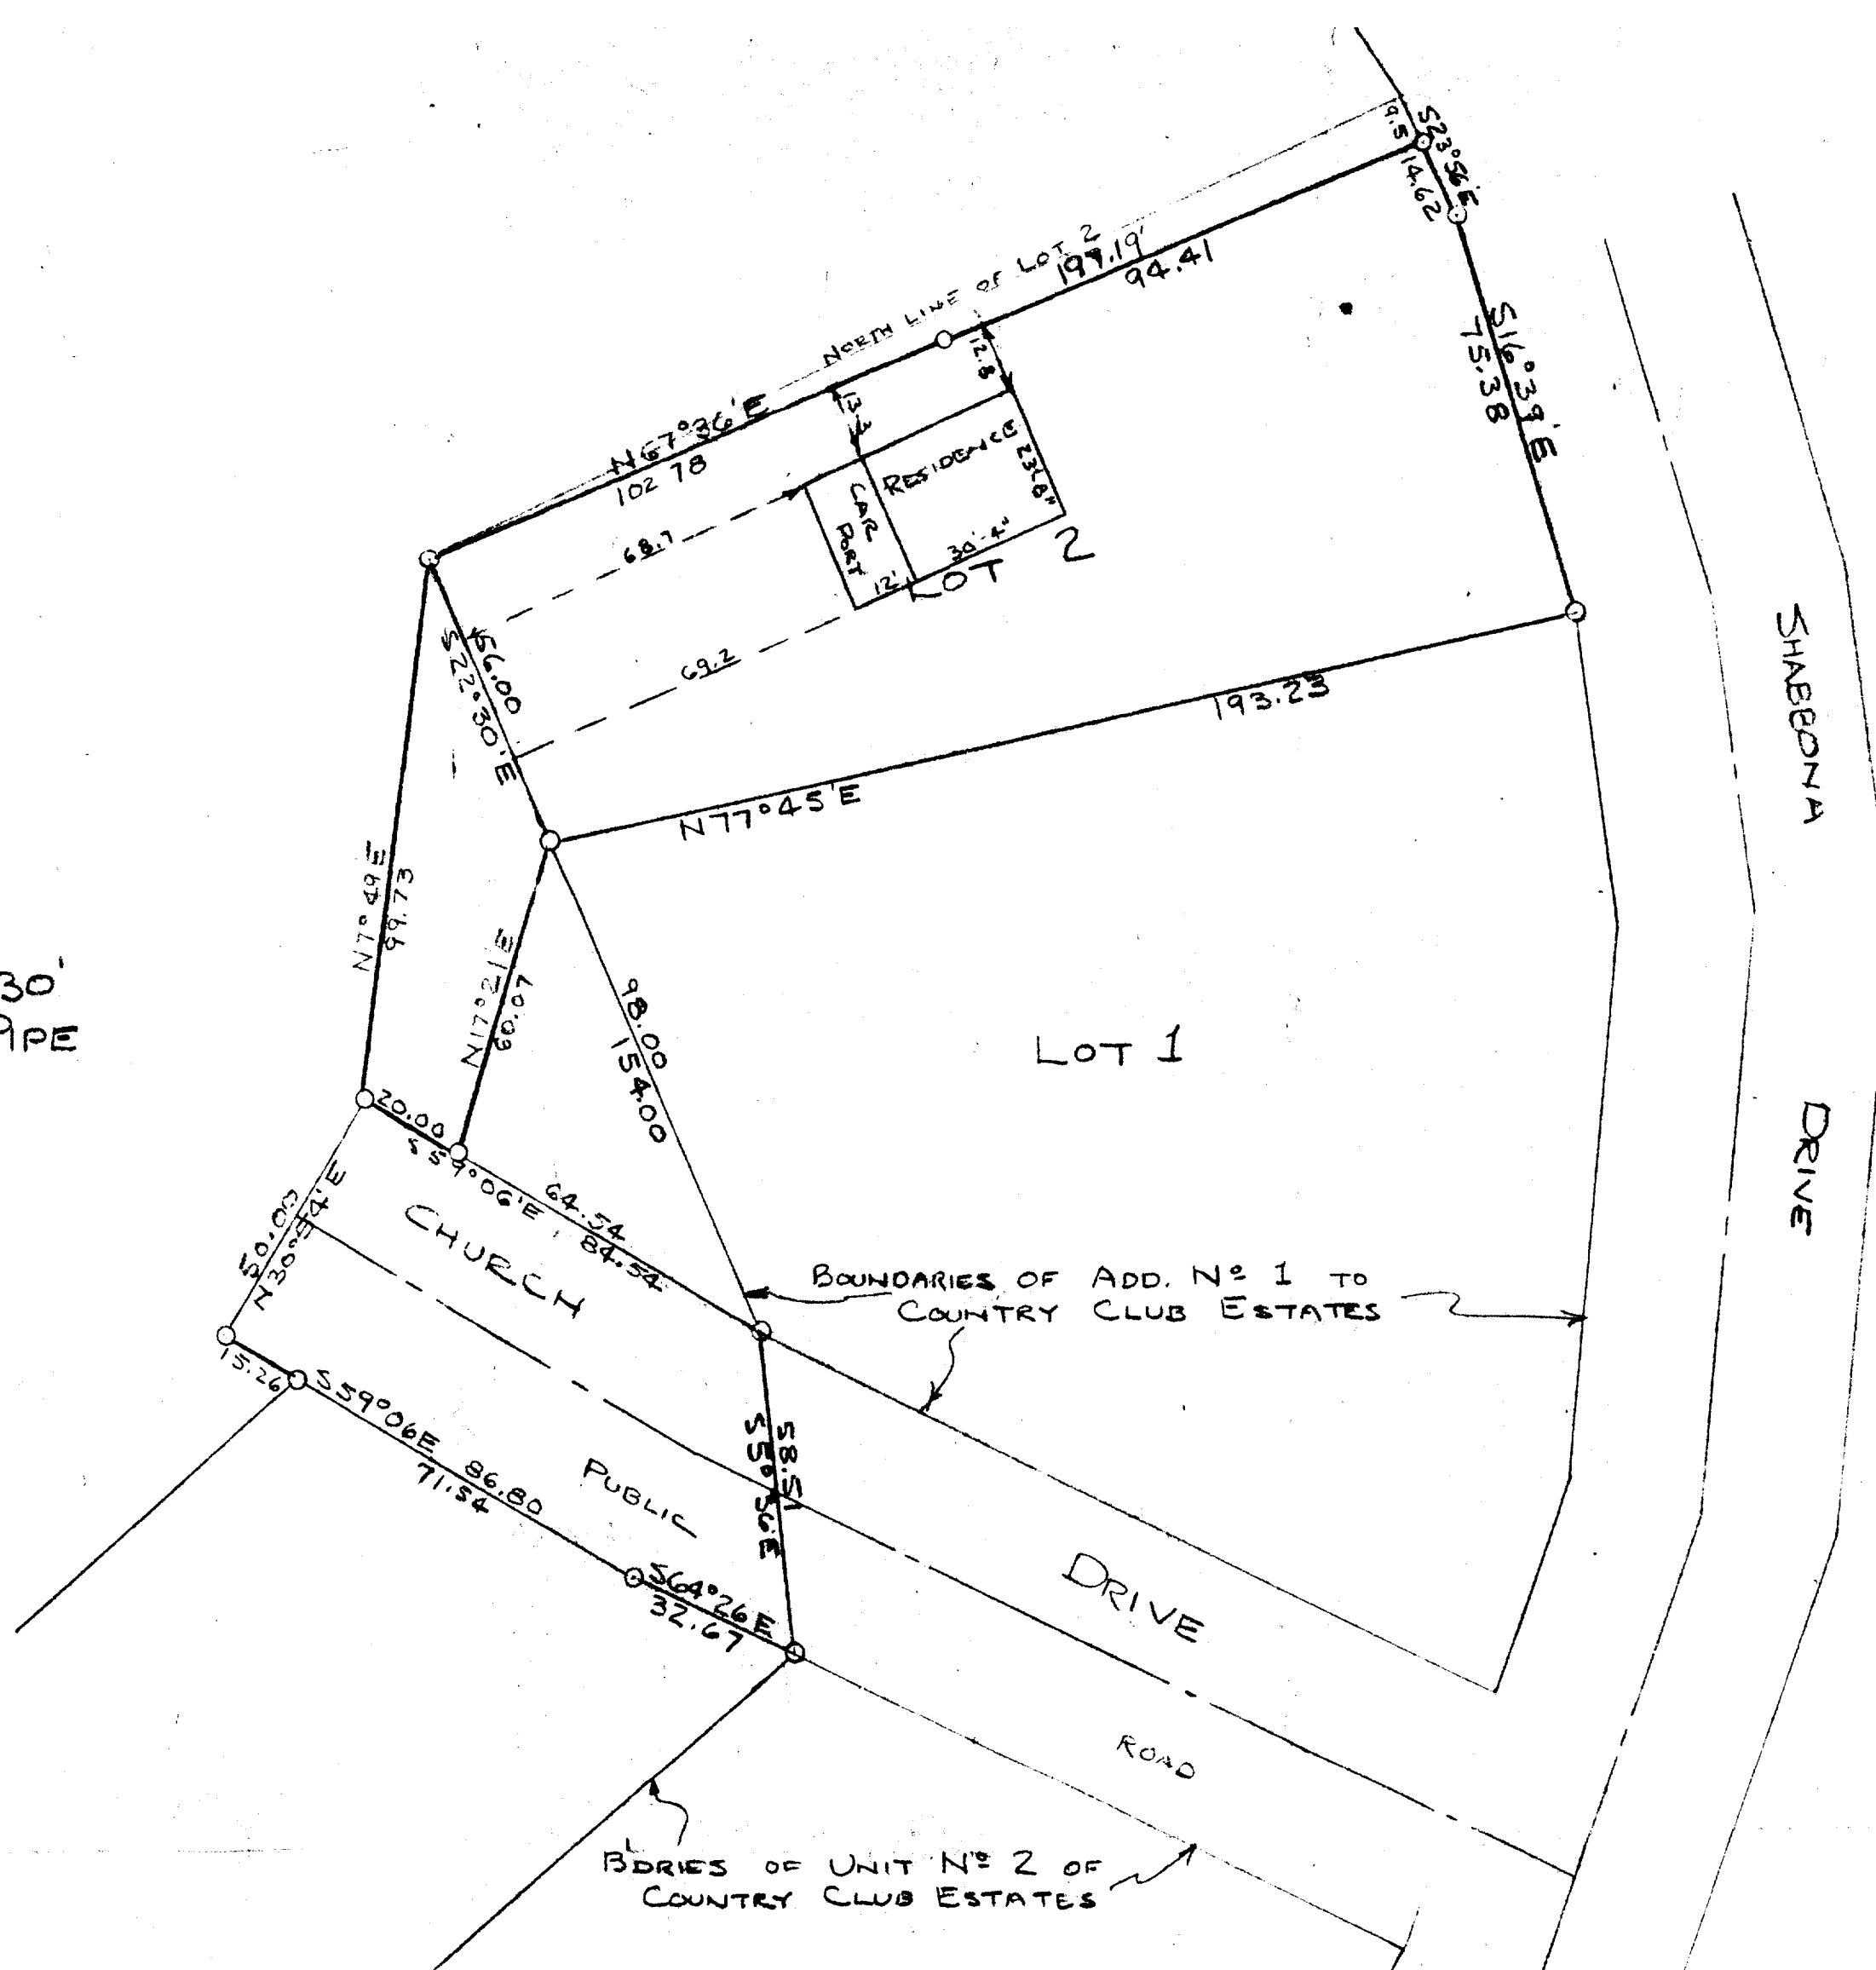

Lloyd L. Jensen
COUNTY SURVEYOR