


DUNHAM SURVEYING, S.C.
SURVEYING & SUBDIVIDING
DELAVER, WISCONSIN 53115



Scale - 1" = 20'

- = Broken concrete monument found and reset
- = 1/2" Iron Rod Found
- = 1 1/4" Iron Pipe Found
- = 1/2" Iron Pipe Found
- = 1" X 24" Iron Pipe Set
- = 1/2" X 24" Iron Pipe Set
- = 3/4" X 24" Iron Pipe Set

Bearings referenced to the southwesterly line of the roadway with the assumed bearing of S55°30'E
Survey ordered by: The Rauland Agency
118 Kenosha
Walworth, WI 53184

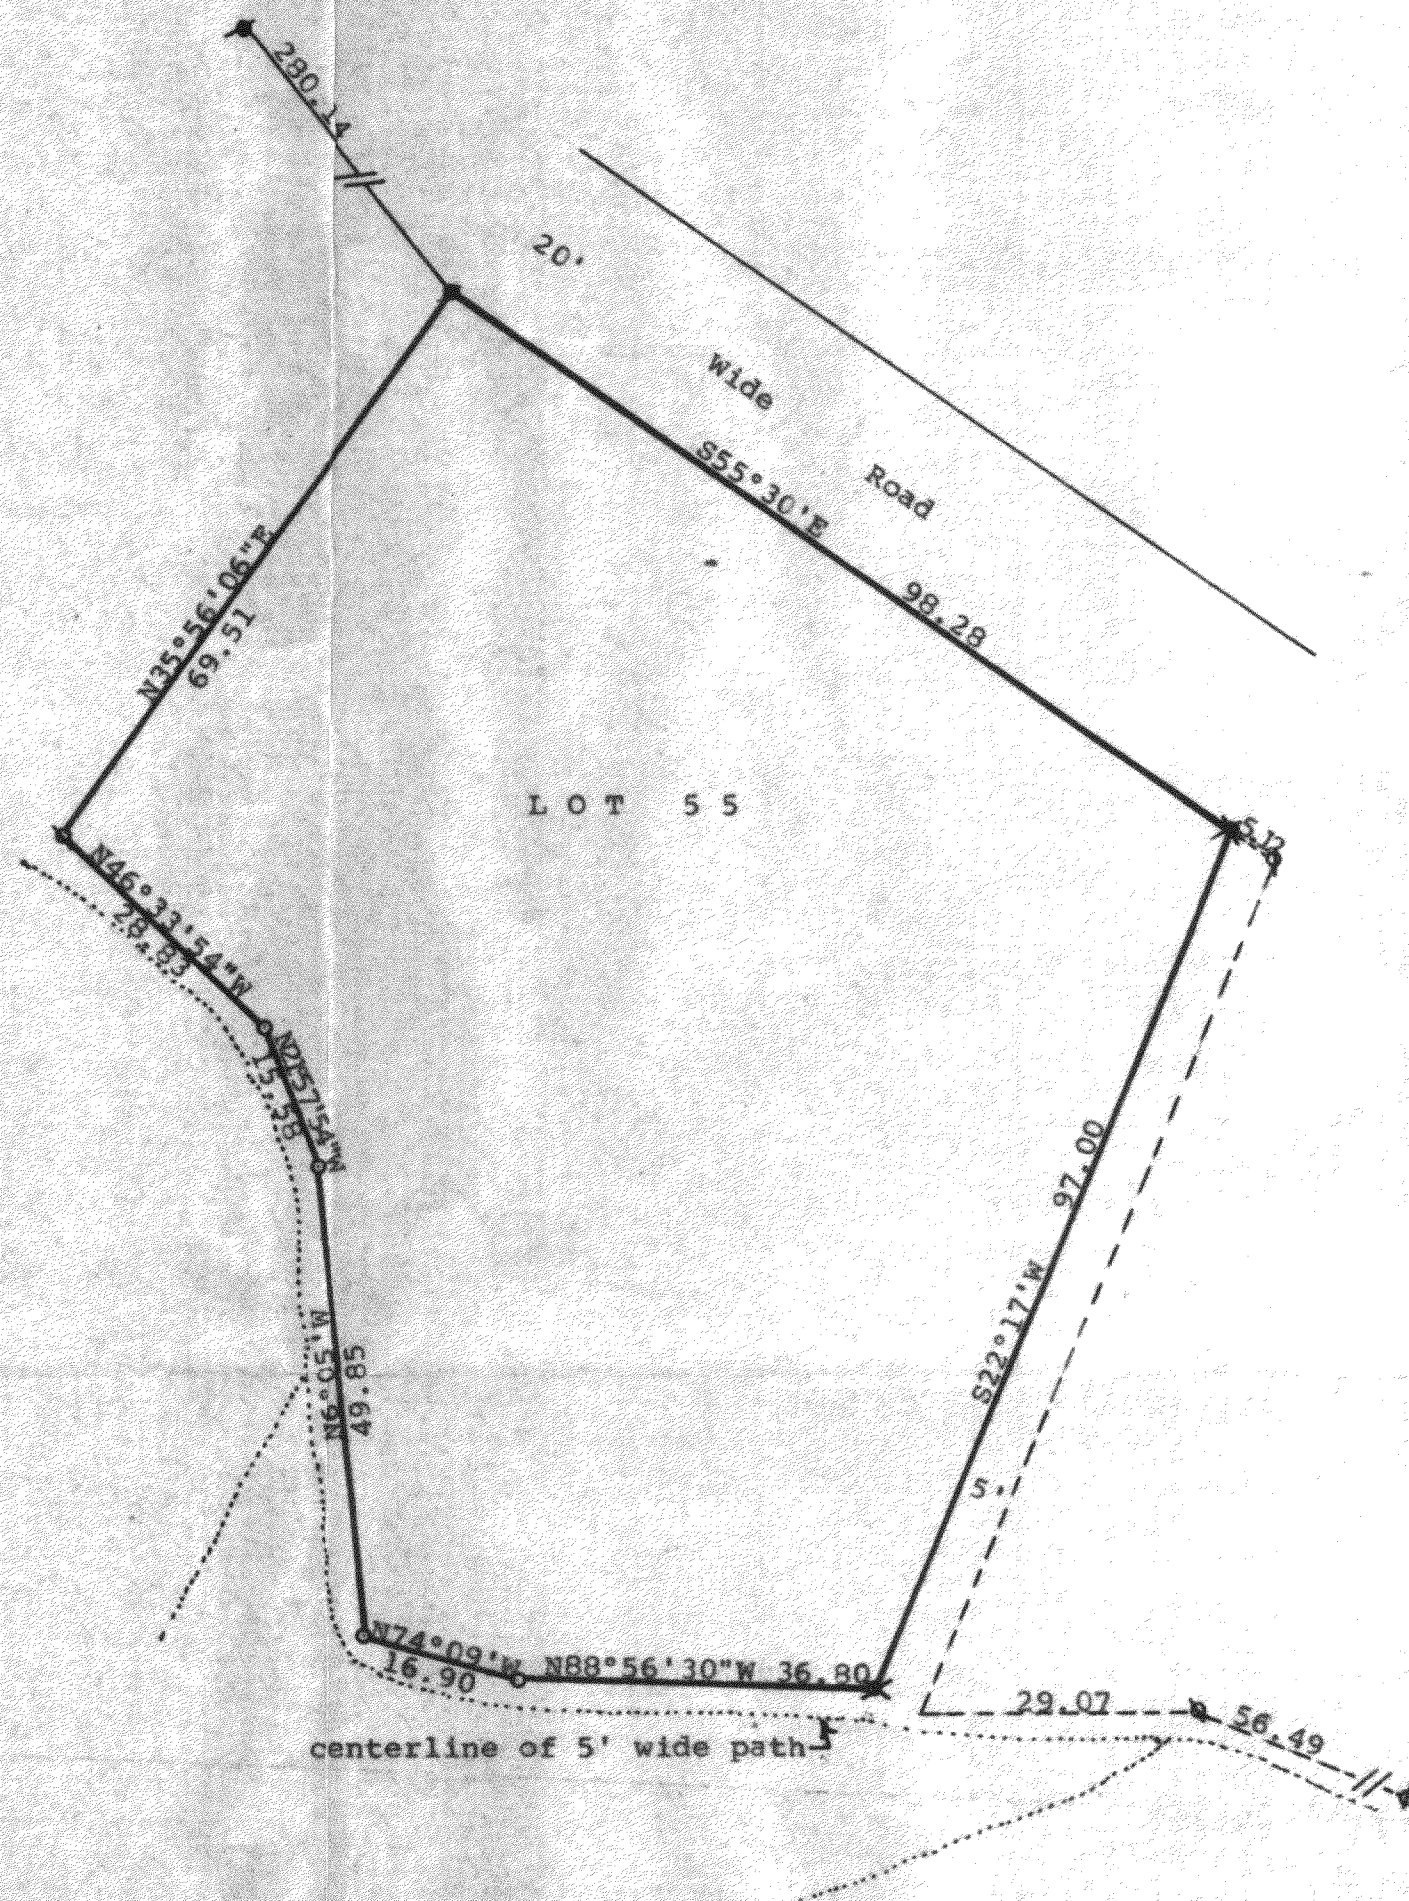


STATE OF WISCONSIN) SS
COUNTY OF WALWORTH)

I, George T. Dunham, Surveyor, certify that I have surveyed the property described as follows:

Lot 55 of the Revised Plat of The Gardens, a subdivision located in the Village of Fontana-on-Geneva Lake, Walworth County, Wisconsin, and that the plat shown hereon is a correct representation thereof and shows the size and location of the property, its exterior boundaries, the location of all visible structures and dimensions of all principal buildings thereon, boundary fences, apparent easements, roadways and visible encroachments, if any, and that I have surveyed the property hereon described according to the official records, to the best of my knowledge and belief.

April 19, 1988

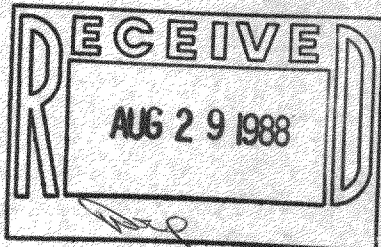

George T. Dunham
George T. Dunham, Surveyor

