

PLAT OF SURVEY

Unit 2 of CLEAR SKY LODGE, a Condominium
located in Government Lot 4, Section 18,
T 1 N, R 17 E, Village of Pontona-on-Geneva
Lake, Walworth County, Wisconsin

ORDERED BY: David Lowell
148 N. Walworth Ave.
Williams Bay, WI 53191
245-9444

Bearings
referenced to
Condominium Plat

SCALE: 1" = 40'

Note: This survey plat is not
certified unless signed
and sealed in red ink.

Curve	Delta	Radius	Arc	Chord	Chord Bearing
7	45°21'20"	30.00	23.75	23.13	S89°47'22"E
8	83°54'00"	30.00	47.93	40.11	N53°22'07"E

LEGEND

- Found iron nail
- Manhole
- Catch Basin
- Water signal
- Pipe

Mapping Into: November 18, 1988

Copyright © 1988 by Jensen Surveying & Mapping S.C.

All rights reserved. No part of this survey plat may be reproduced or transmitted in any form by any means - graphic, electronic, or mechanical, including photocopying, tracing, or information storage and retrieval systems - without permission in writing from Thomas P.A. Jensen, Jensen Surveying & Mapping S.C.

I hereby certify that I have surveyed the above described property and that the map hereon is a true representation thereof and shows the size and location of the property, its exterior boundaries, the location of all visible structures and dimensions of all principal buildings thereon, boundary fences, apparent easements, roadways and visible encroachments, if any.

This survey is made for the use of the present owners of the property and also those who purchase, mortgage, or guarantee the title thereto within one year from date hereof.


I, Thomas P.A. Jensen, Wisconsin Registered Land Surveyor, do hereby certify that this survey was performed by me, or under my direction, in full compliance with the owner's agent's instructions and Chapter 4-E 7 of the Wisconsin Administrative Code "Minimum Standards For Property Surveys"; and that this map is an accurate representation thereof to the best of my knowledge and belief.

Thomas P.A. Jensen R.L.S.-1084
Jensen Surveying & Mapping S.C.

[Signature]

5-926

1988.130 X

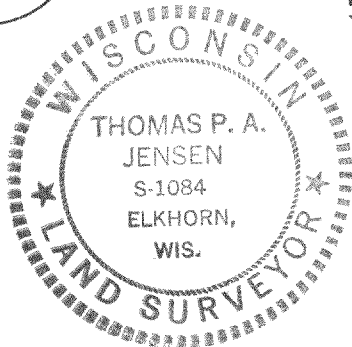

SC-2

