


Sketch of Lot 10 of Addition No. 1 to Country Club Estates,
located in the Southeast $\frac{1}{4}$ of the Southwest $\frac{1}{4}$ and the South-
west $\frac{1}{4}$ of the Southwest $\frac{1}{4}$ of Section 14, Town 1 North, Range
16 East, Walworth County, Wisconsin.

Surveyed for: James Kost
90 North Potawotami
Williams Bay, Wisconsin. 53191

Surveyed by: Jensen Surveying & Mapping S.C.
45 South Wisconsin Street
Elkhorn, Wisconsin. 53121

Mapping date: January 6, 1989



Scale: 1"=50'

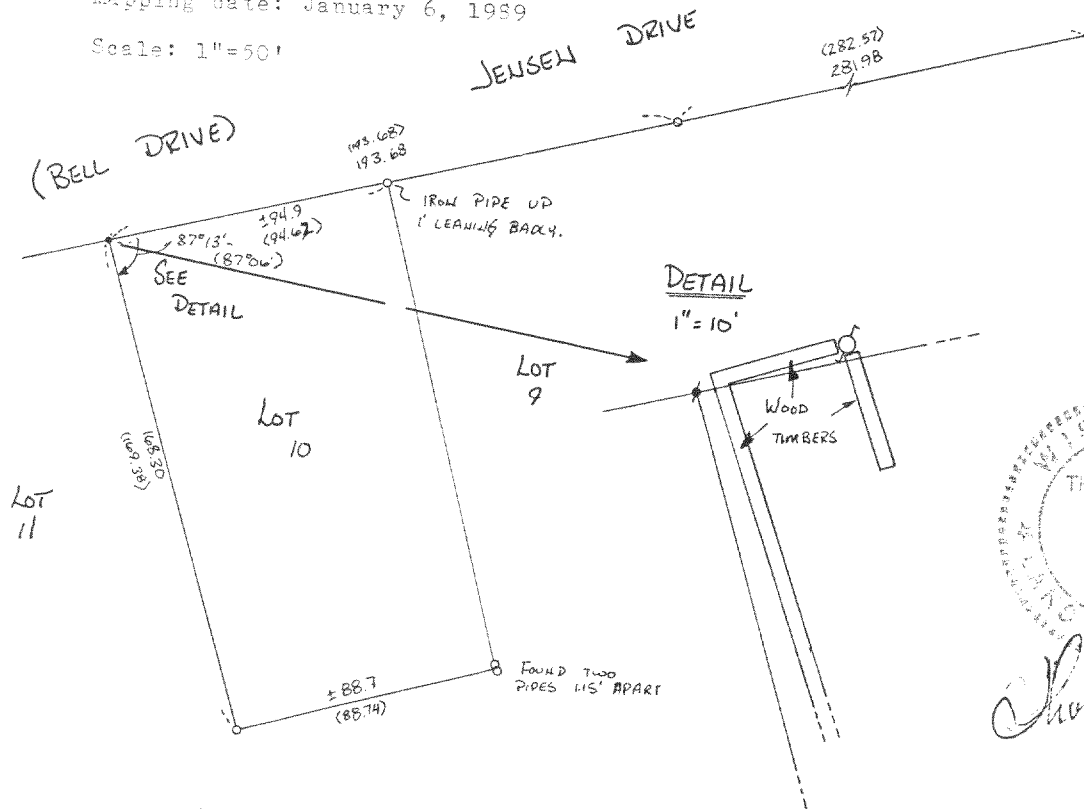

LEGEND

- o ~ Found iron pipe
- * ~ Set spike
- o ~ Utility pole

NOTE: This is only a sketch. This survey was never completed as per the instructions of client.

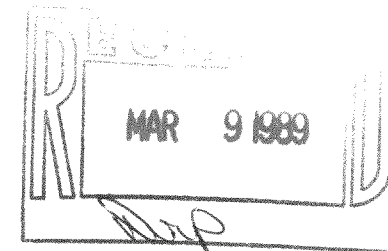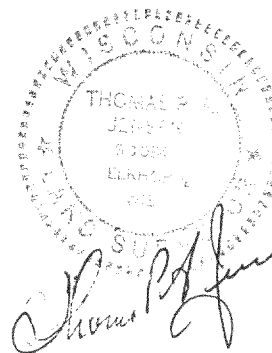

1989.001
5-927