


GEORGE T. DUNHAM
SURVEYING & SUBDIVIDING
DELAVAN, WISCONSIN

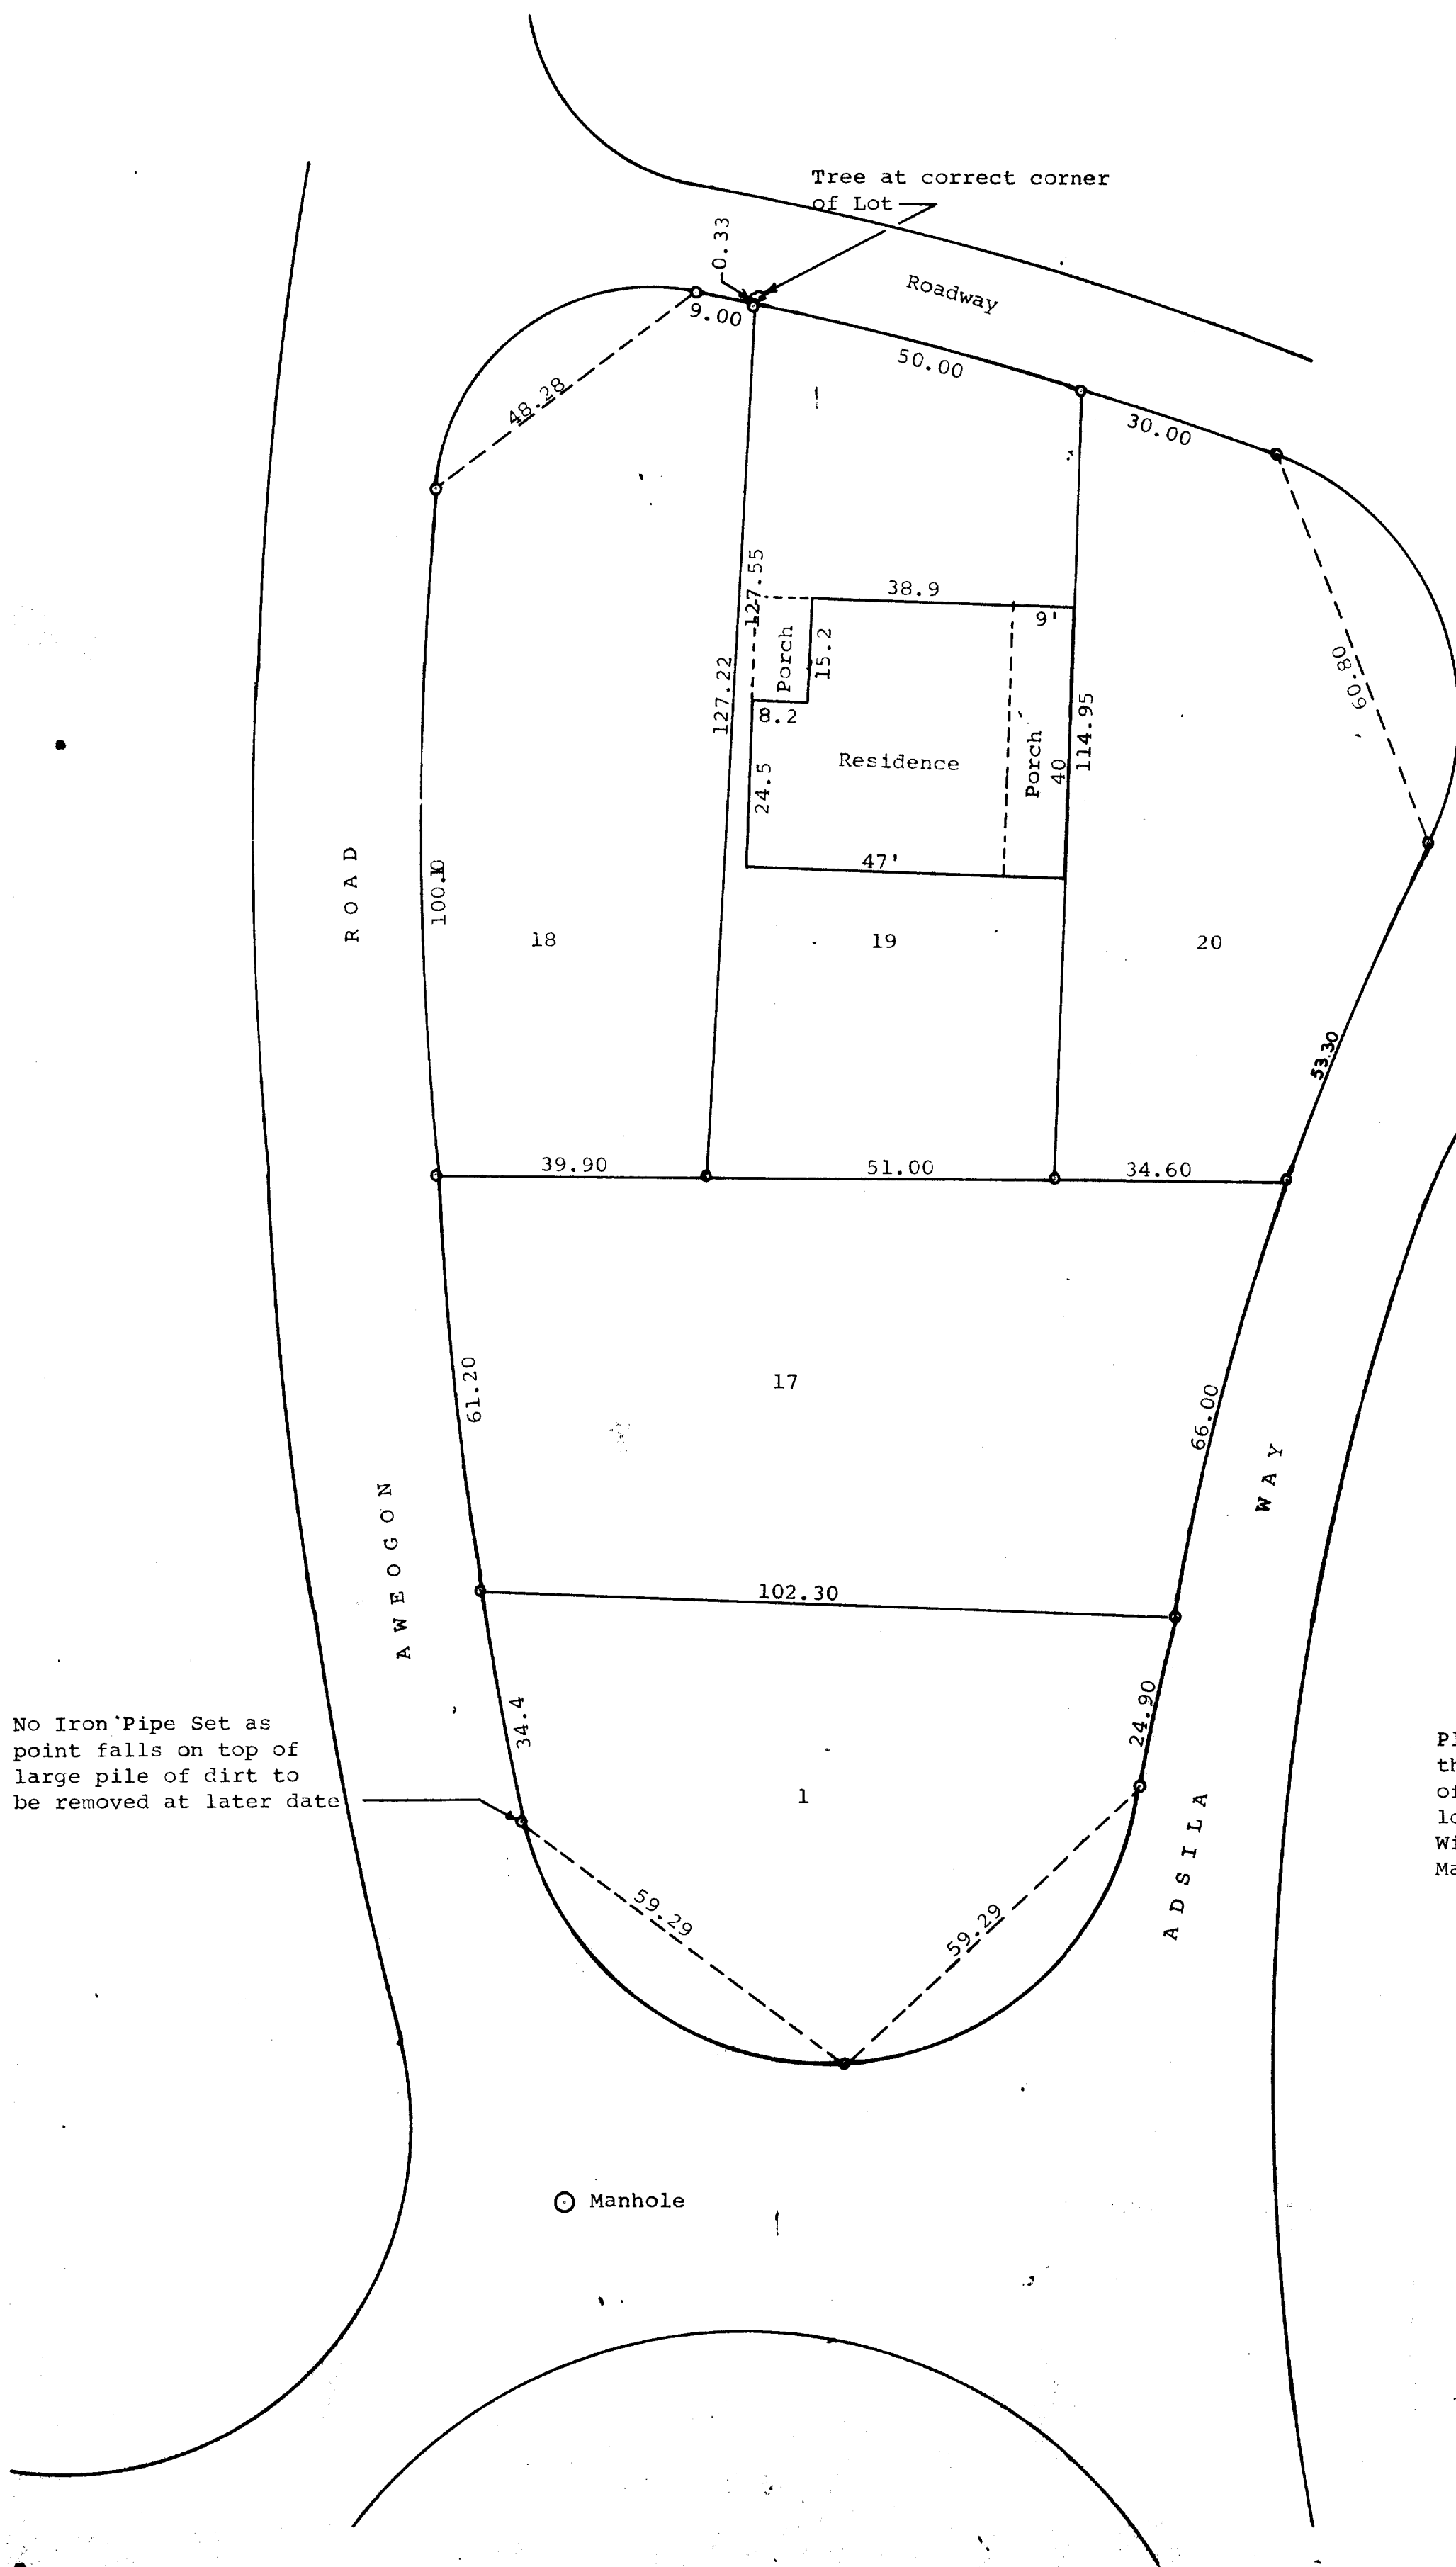

Scale - 1" = 20'
○ = Iron Pipe

Plat of survey of Lots 17, 18, 19, and 20 of the Subdivision Of Block 6 of Indian Hills and of Lot 1, Block 2 of Indian Hills 1st Addition located in the Village of Fontana, Walworth County, Wisconsin.
March 9, 1966

George T. Dunham
George T. Dunham, Surveyor