



WALWORTH COUNTY
SURVEYING & MAPPING
LAKE GENEVA, WISCONSIN

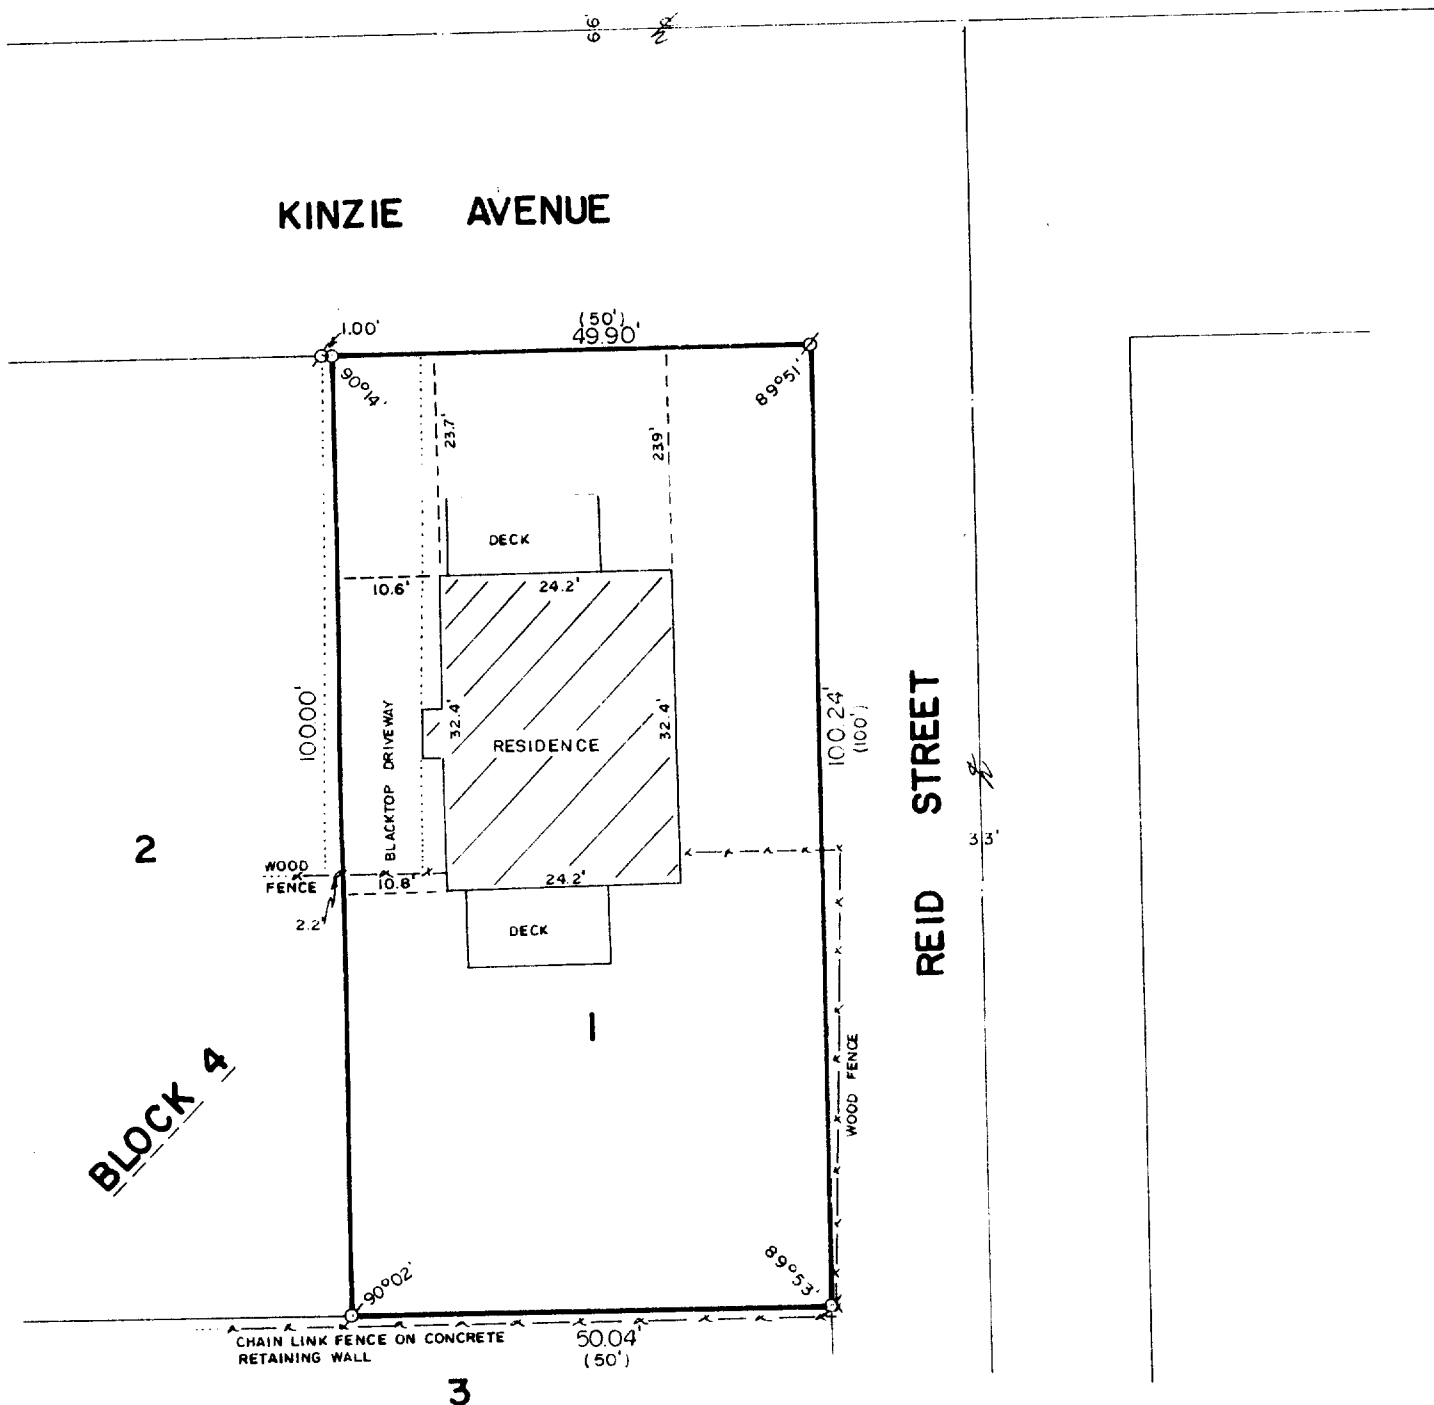

STATE OF WISCONSIN

TO BE A PART OF THE RECORDS OF THE
RECORDS OF THE COUNTY OF WALWORTH
IN THE VILLAGE OF
PONTIAC, WISCONSIN, WALWORTH COUNTY,
WISCONSIN.

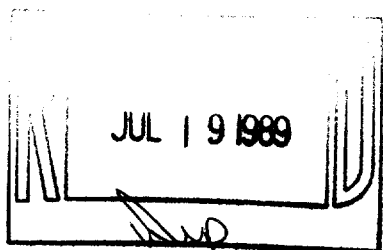

WALWORTH COUNTY
RECORDS OF THE COUNTY OF WALWORTH
IN THE VILLAGE OF
PONTIAC, WISCONSIN, WALWORTH COUNTY,
WISCONSIN.



SCALE: 1" = 100'

Ø - IRON PIER FOUND
Ø - IRON ROD FOUND
O - IRON ROD PLACED
(HARD COPY)

I HEREBY CERTIFY THAT I HAVE SURVEYED THE ABOVE DESCRIBED PROPERTY AND THAT THE ABOVE
MAP IS A TRUE REPRESENTATION THEREOF AND SHOWS THE SIZE AND LOCATION OF THE PROPERTY,
ITS EXTERIOR BOUNDARIES, THE LOCATION OF ALL VISIBLE STRUCTURES AND DIMENSIONS OF ALL
PRINCIPAL BUILDINGS THEREON, BOUNDARY FENCES, APPARENT EASEMENTS AND ROADWAYS AND
VISIBLE ENCROACHMENTS, IF ANY.

THIS SURVEY IS MADE FOR THE EXCLUSIVE USE OF THE PRESENT OWNERS OF THE PROPERTY, AND
ALSO THOSE WHO PURCHASE, MORTGAGE, OR GUARANTEE THE TITLE THERE TO WITHIN ONE (1) YEAR
FROM DATE HEREOF.

Robert M. Baerenwald
ROBERT M. BAERENWALD
WISCONSIN REGISTERED LAND SURVEYOR, S-1508

DATE *April 12, 1989* JOB NO. *11*

NOTE: THIS IS NOT A CERTIFIED COPY UNLESS SEALED.

SRA-21

5-971