


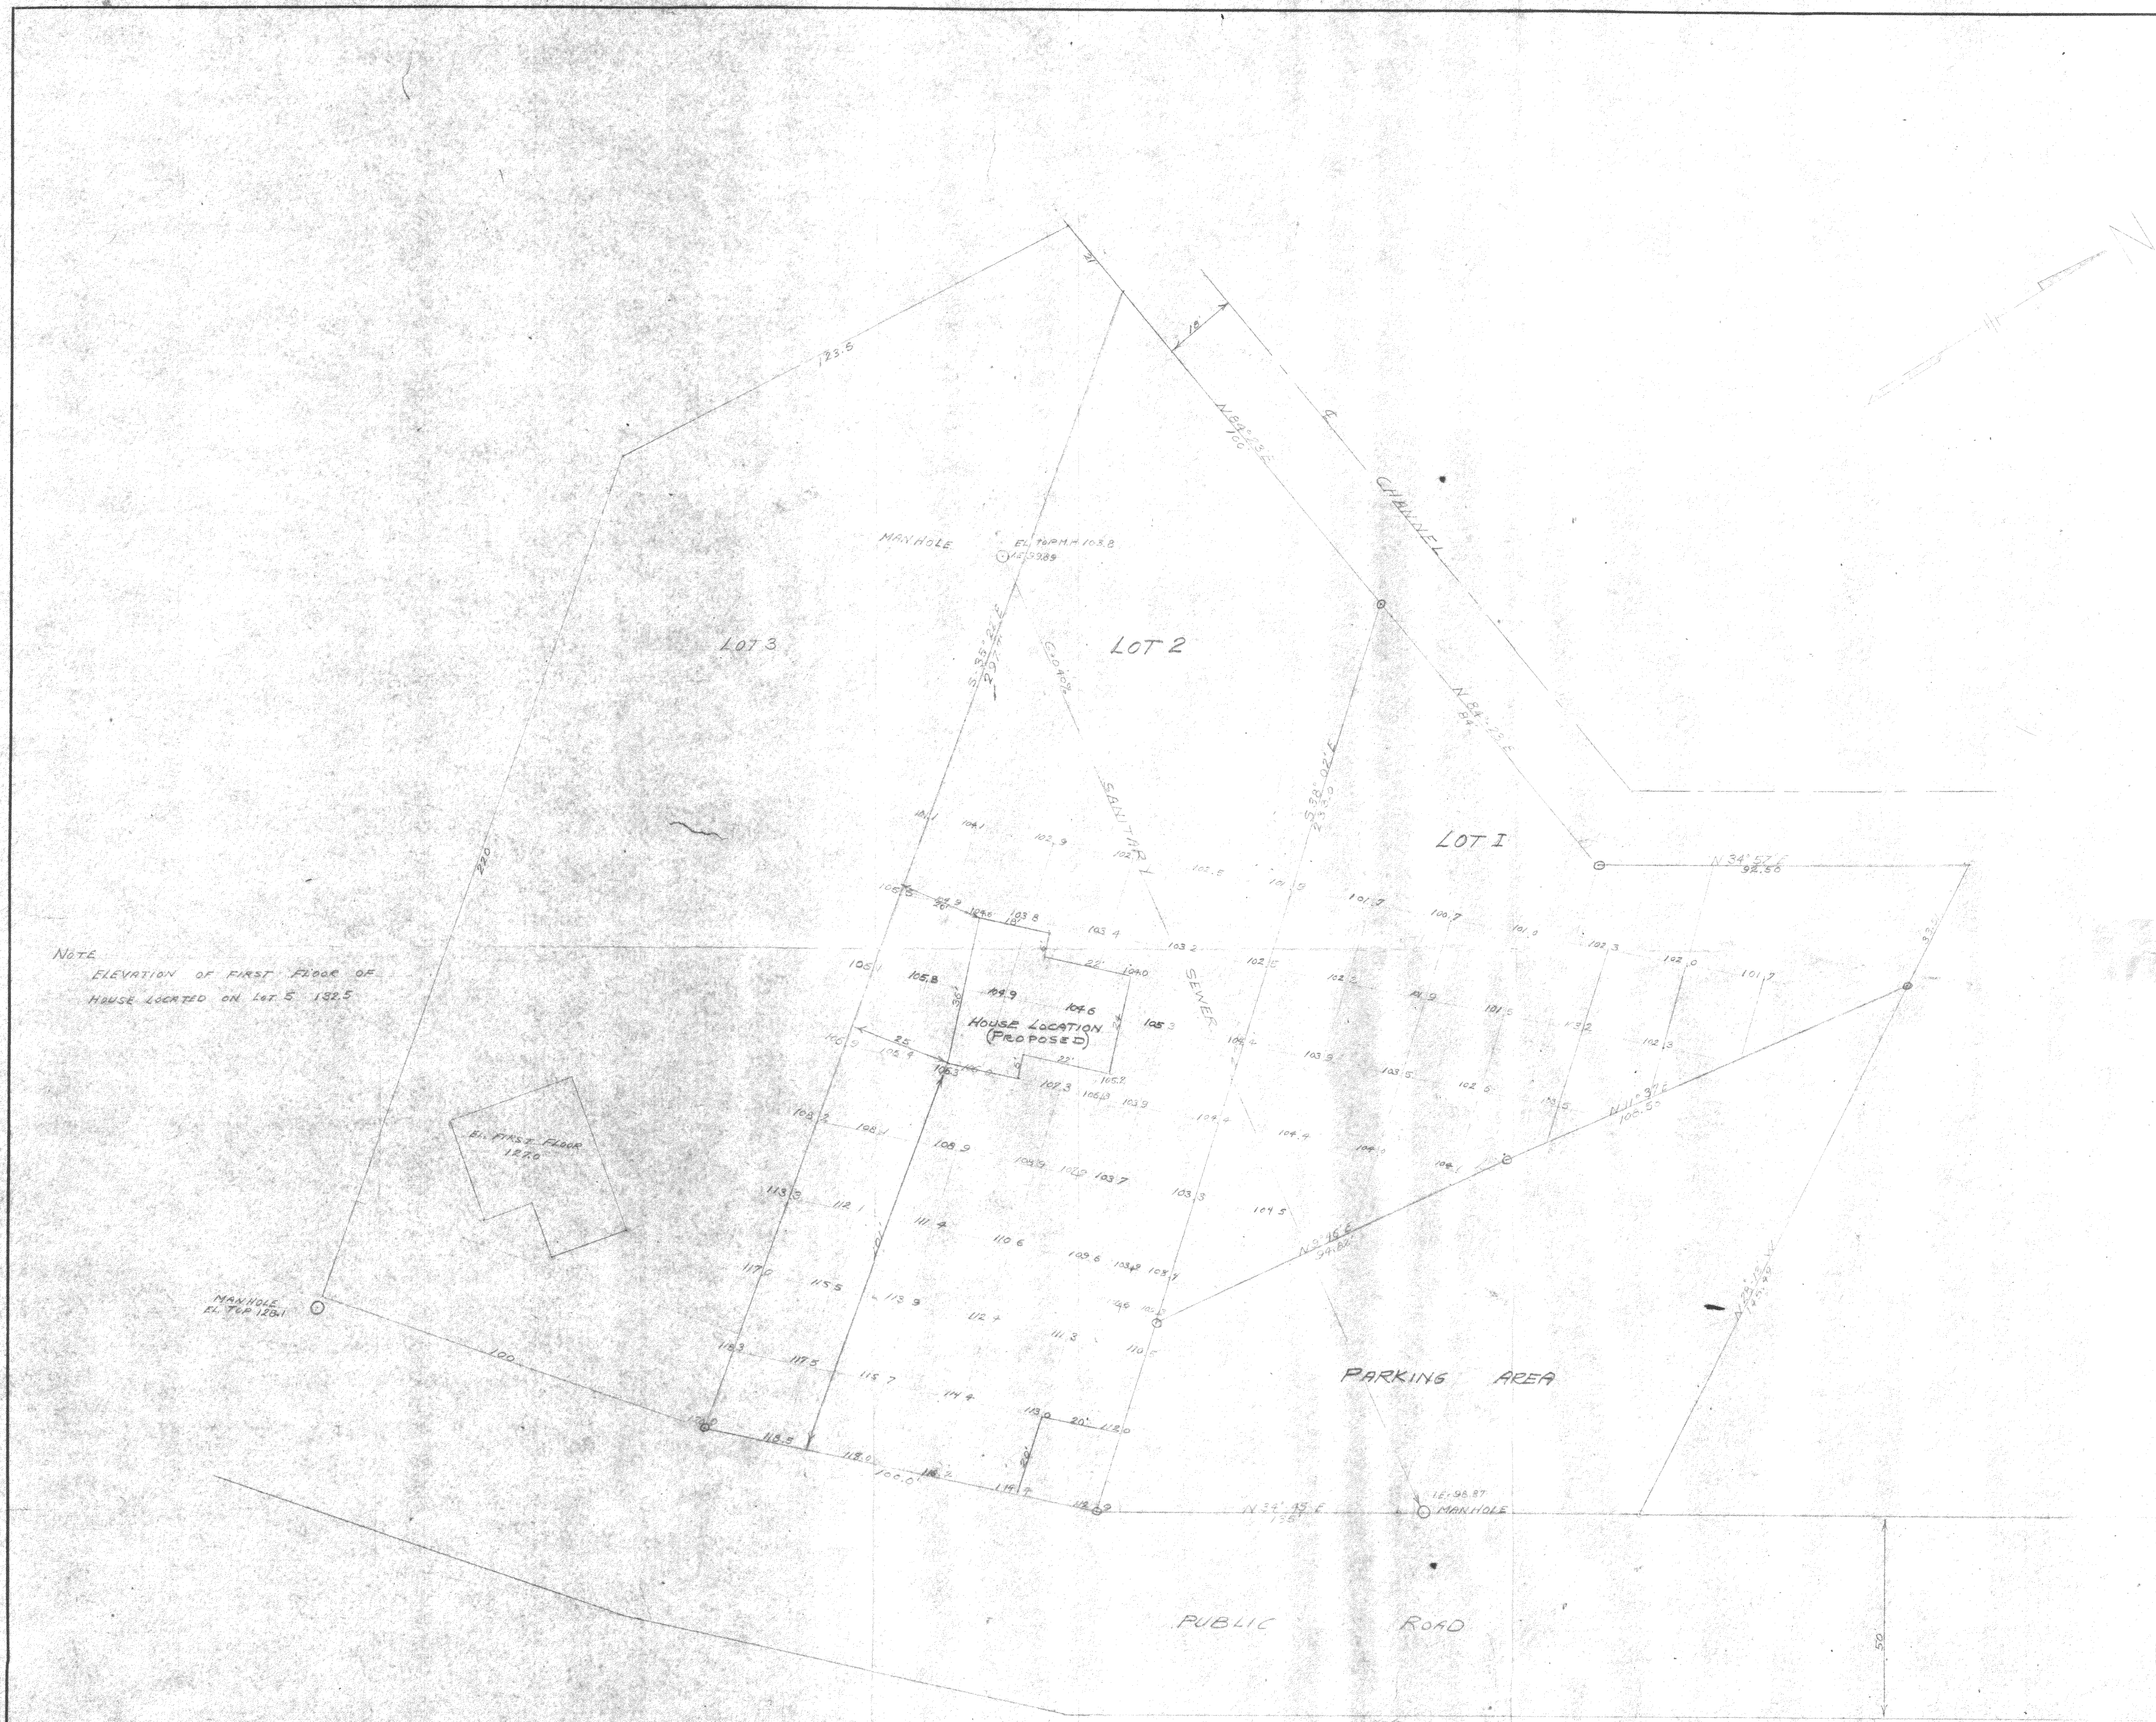

CONCRETE
12" DIA. PIPE
E.M.F. 100.00
SOUTH WEST CORNER
OF LINDER PASS FLOOR

LINE ELEVATION 99.7 SEPT. 1, 1956
O-IRON PIPE

ELEVATIONS AND HOUSE LOCATION LOTS 1 & 2 OF UNIT NO. 1 COUNTRY CLUB ESTATES VILLAGE OF FONTANA WALWORTH COUNTY WISCONSIN		
DRAWN BY J.J.H.	JENSEN & JOHNSON CIVIL ENGINEERS ELKHORN, WIS. DATE SEPT. 1956	SCALE: 1"=20'
CHECKED BY <i>Coyd Jensen</i>		REVISED
APPROVED BY		SHEET NO. 1 OF 1