
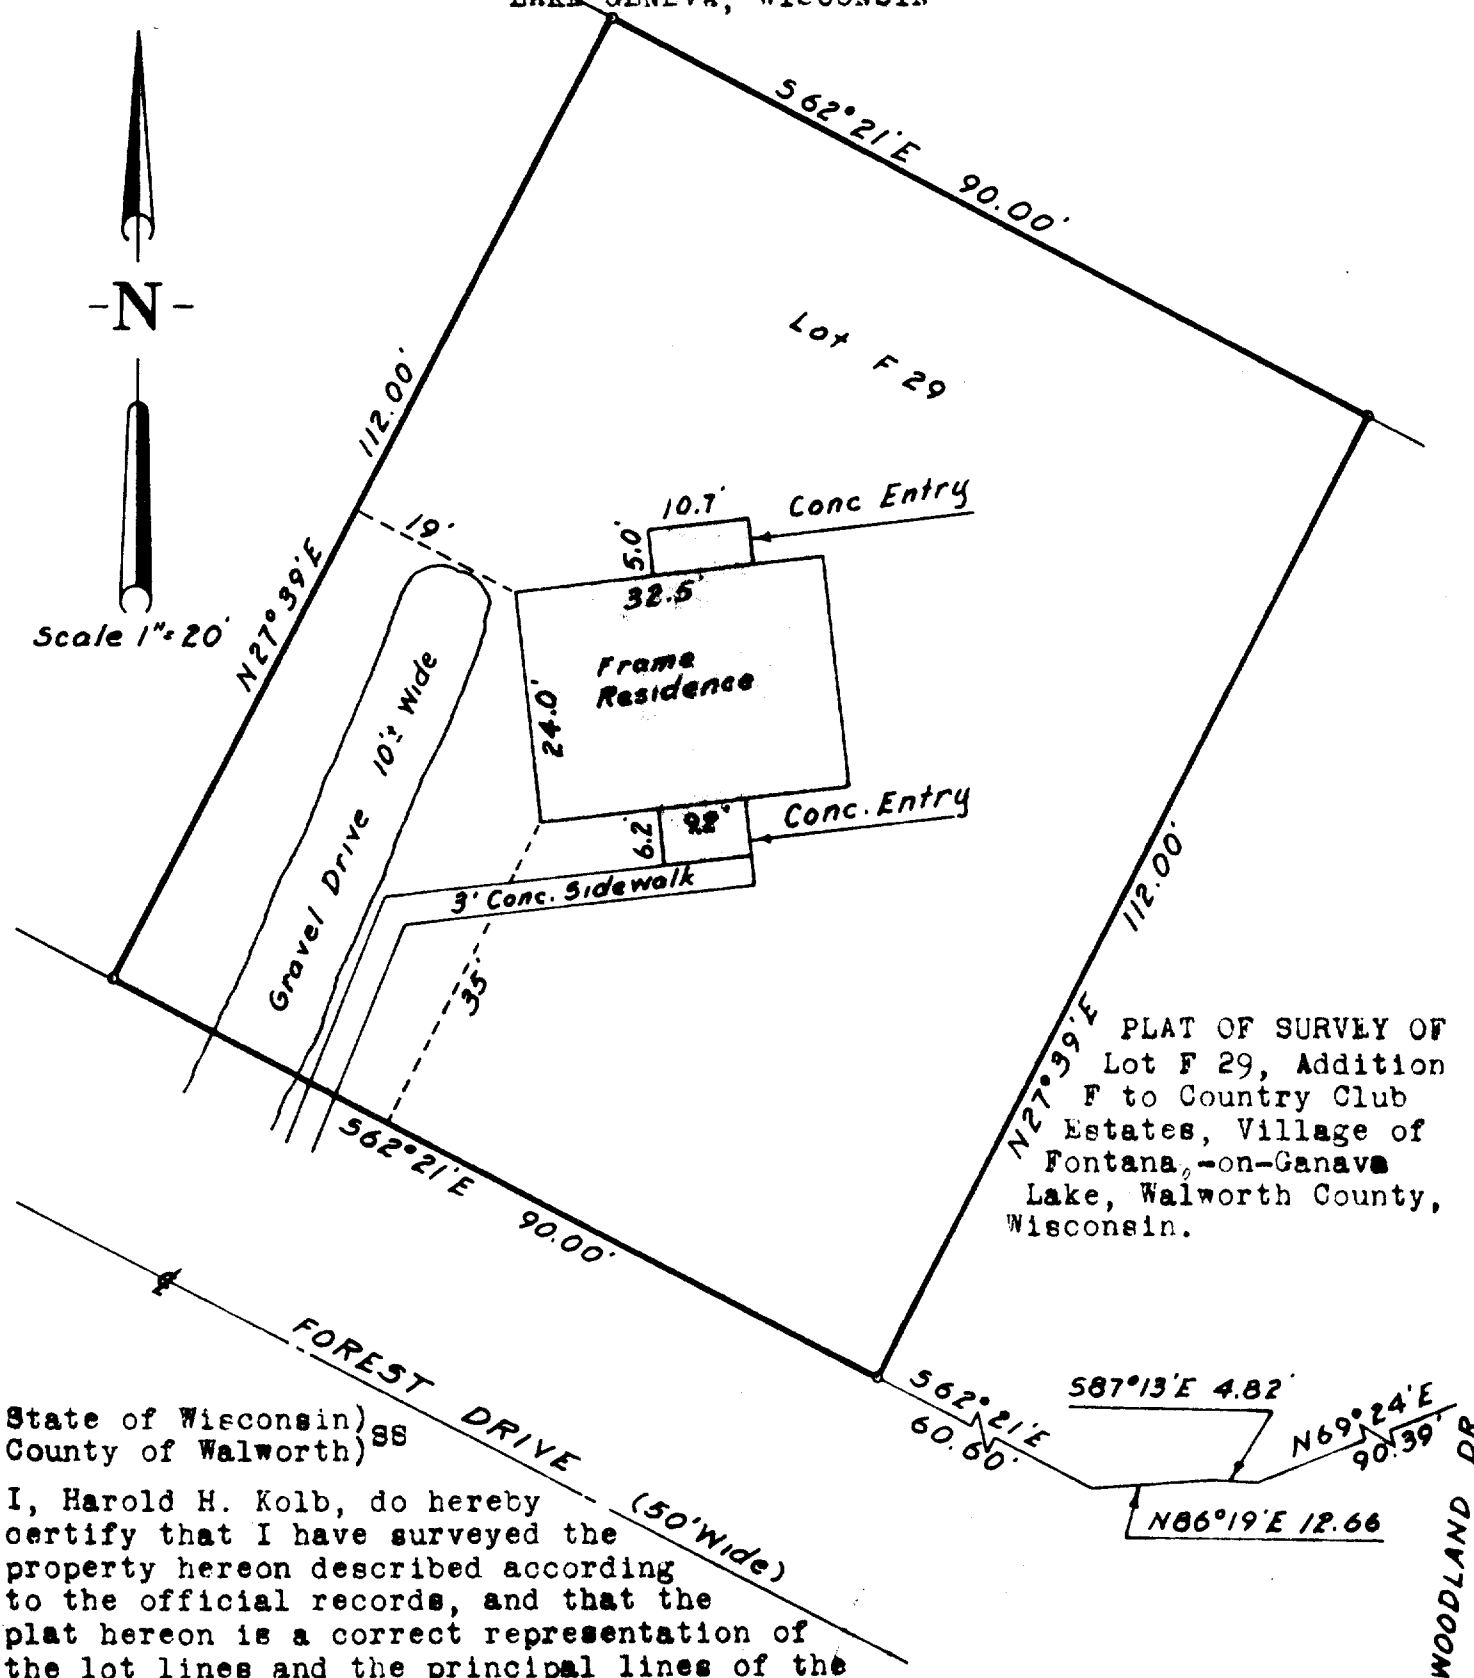


HAROLD H. KOLB
REGISTERED PROFESSIONAL LAND SURVEYOR
LAKE GENEVA, WISCONSIN

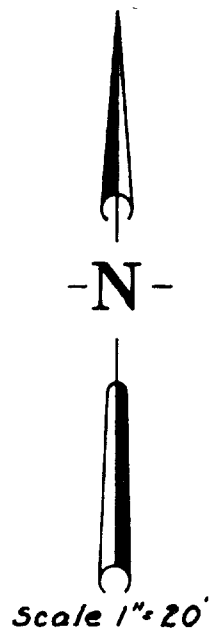

State of Wisconsin) ss
County of Walworth)

I, Harold H. Kolb, do hereby certify that I have surveyed the property hereon described according to the official records, and that the plat hereon is a correct representation of the lot lines and the principal lines of the buildings thereon.

Harold H. Kolb

Harold H. Kolb, Wisconsin Surveyor, S-187
DATE: October 3, 1963

5-214

o - Iron Pipe Found