



**LAND-MARK SURVEYING**  
**Mark L. Miritz**

Wisconsin Registered Land Surveyor S-2582

N9330 Knuteson Drive  
 Whitewater, WI 53190  
 Phone: (262) 495-3284  
 FAX : (262) 495-8421  
 LAND-MARKSURVEYING.COM

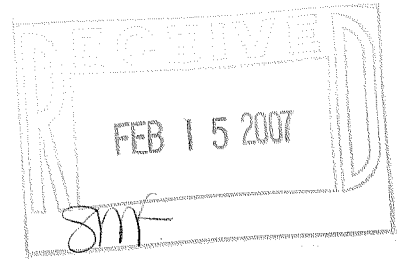

**PLAT OF SURVEY**  
**LOT V OF THE GARDENS 2ND ADDITION, LOCATED**  
**IN THE VILLAGE OF FONTANA - ON - GENEVA LAKE,**  
**WALWORTH COUNTY, WISCONSIN.**

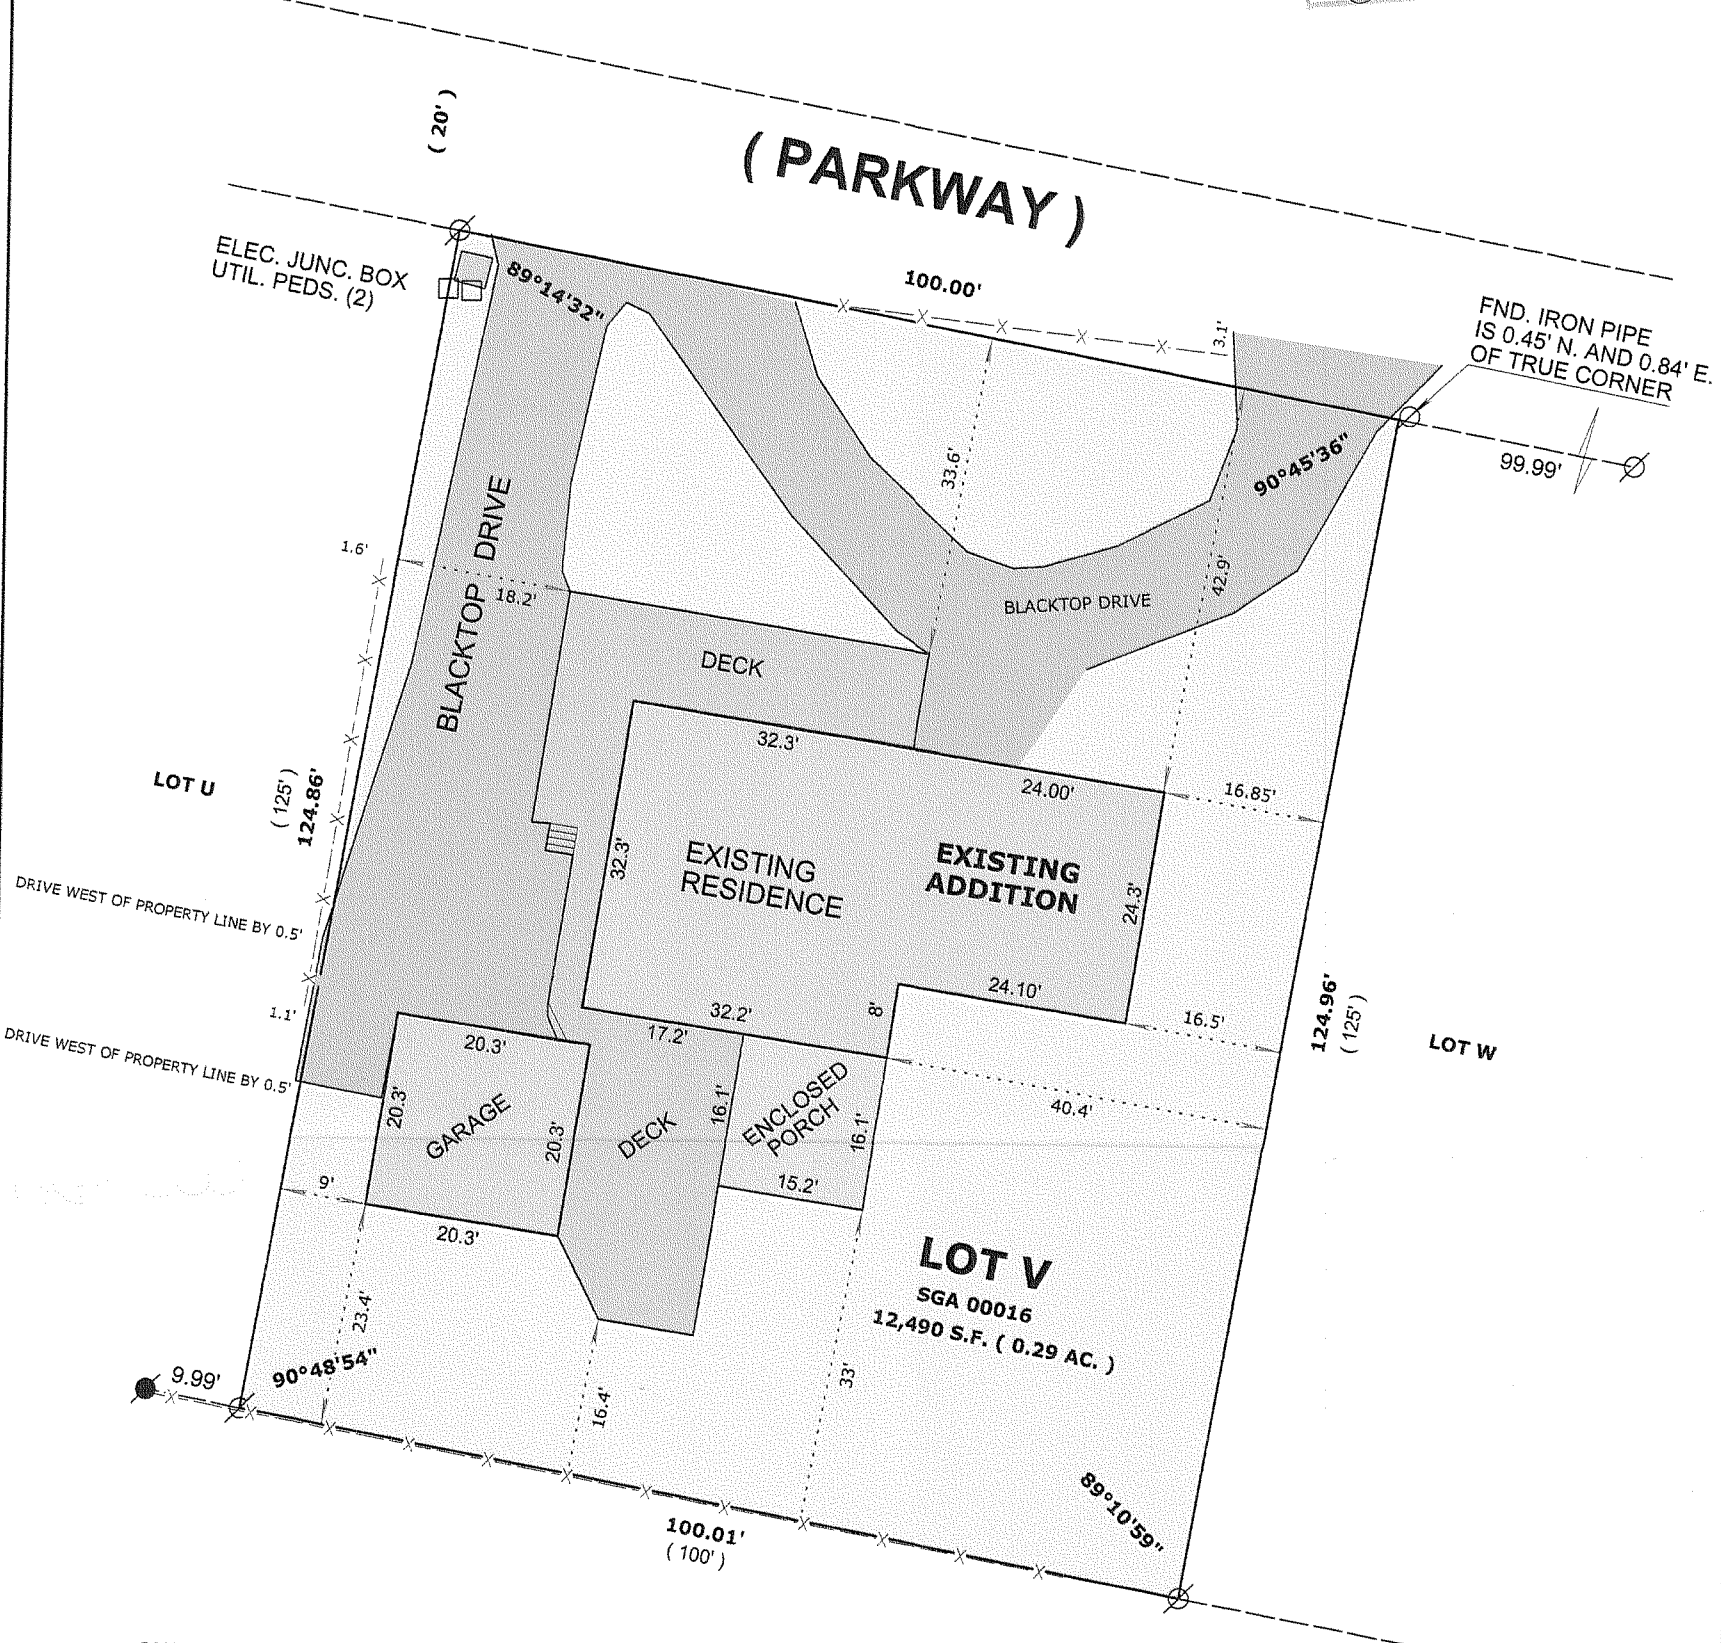


**OWNER: MARGARET E. MOSER TRUST**  
 730 CREEKSIDE - # 506  
 MT. PROSPECT, IL. 60056

**ORDERED BY: HUMMEL CONSTRUCTION**  
 N1958 COUNTY ROAD "O"  
 DELAVAN, WI 53115



**LEGEND**

- ⊗ FOUND IRON PIPE
- FOUND IRON ROD
- ⊠ FOUND COUNTY MONUMENT
- FOUND CONCRETE MONUMENT
- + CHISEL CUT IN CONCRETE
- SET IRON ROD, 24" LONG, WEIGHING 1.5 LBS./LINEAL FT., 3/4" DIA.
- ( x x ) RECORDED AS DIMENSION
- X-X- EXISTING FENCE

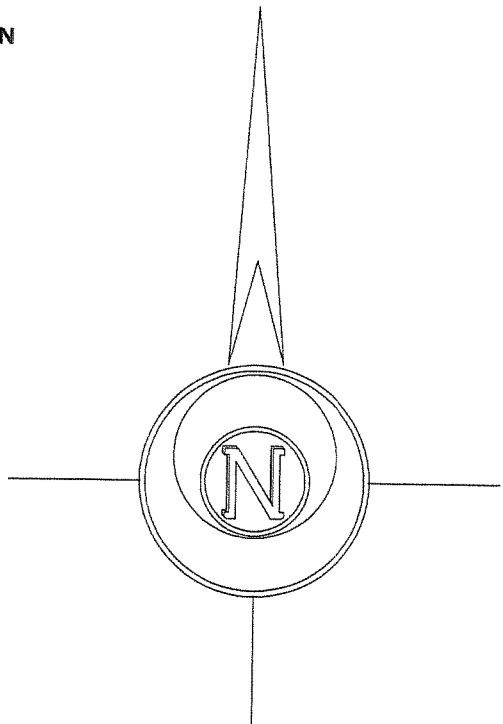

"I hereby certify that the above described property has been surveyed by me or under my direction and that the above map is a true representation thereof and shows the size and location of the property, its exterior boundaries, the location of all visible structures and dimensions of all principal buildings thereon, boundary fences, apparent easements, roadways and visible encroachments, if any."  
 "This survey is made for the use of the present owners of the property, and also those who purchase, mortgage, or guarantee the title thereto within one year from date hereof."

*Mark L. Miritz*  
**MARK L. MIRITZ**  
 WISCONSIN REGISTERED  
 LAND SURVEYOR S-2582

SCALE: 1" = 20 FEET

REVISED JAN. 5, 2006 TO SHOW ADDITION "AS BUILT"

DATE: OCTOBER 3, 2006 JOB NO. 06.909

SGA 716

005-2441