

WORK ORDERED BY -
DENNIS FLINT
MID STATES REMODELING
P.O. BOX 441
ADDISON, IL 60101

FARRIS, HANSEN & ASSOCIATES, INC.
ENGINEERING - ARCHITECTURE - SURVEYING
7 RIDGWAY COURT P.O. BOX 437
ELKHORN, WISCONSIN 53121
OFFICE: (262) 723-2098 FAX: (262) 723-5886


REVISIONS

PROJECT NO.
7595
DATE:
4/15/2008
SHEET NO.
1 OF 1

PLAT OF SURVEY TOPOGRAPHICAL MAPPING

LOT 28 OF UNIT 1 OF COUNTRY CLUB ESTATES
LOCATED IN PART OF THE VILLAGE OF FONTANA-ON-GENEVA LAKE, WALWORTH COUNTY, WISCONSIN

ASSIGNED NORTHEAST LINE OF LOT 28
S 46°50'00" W

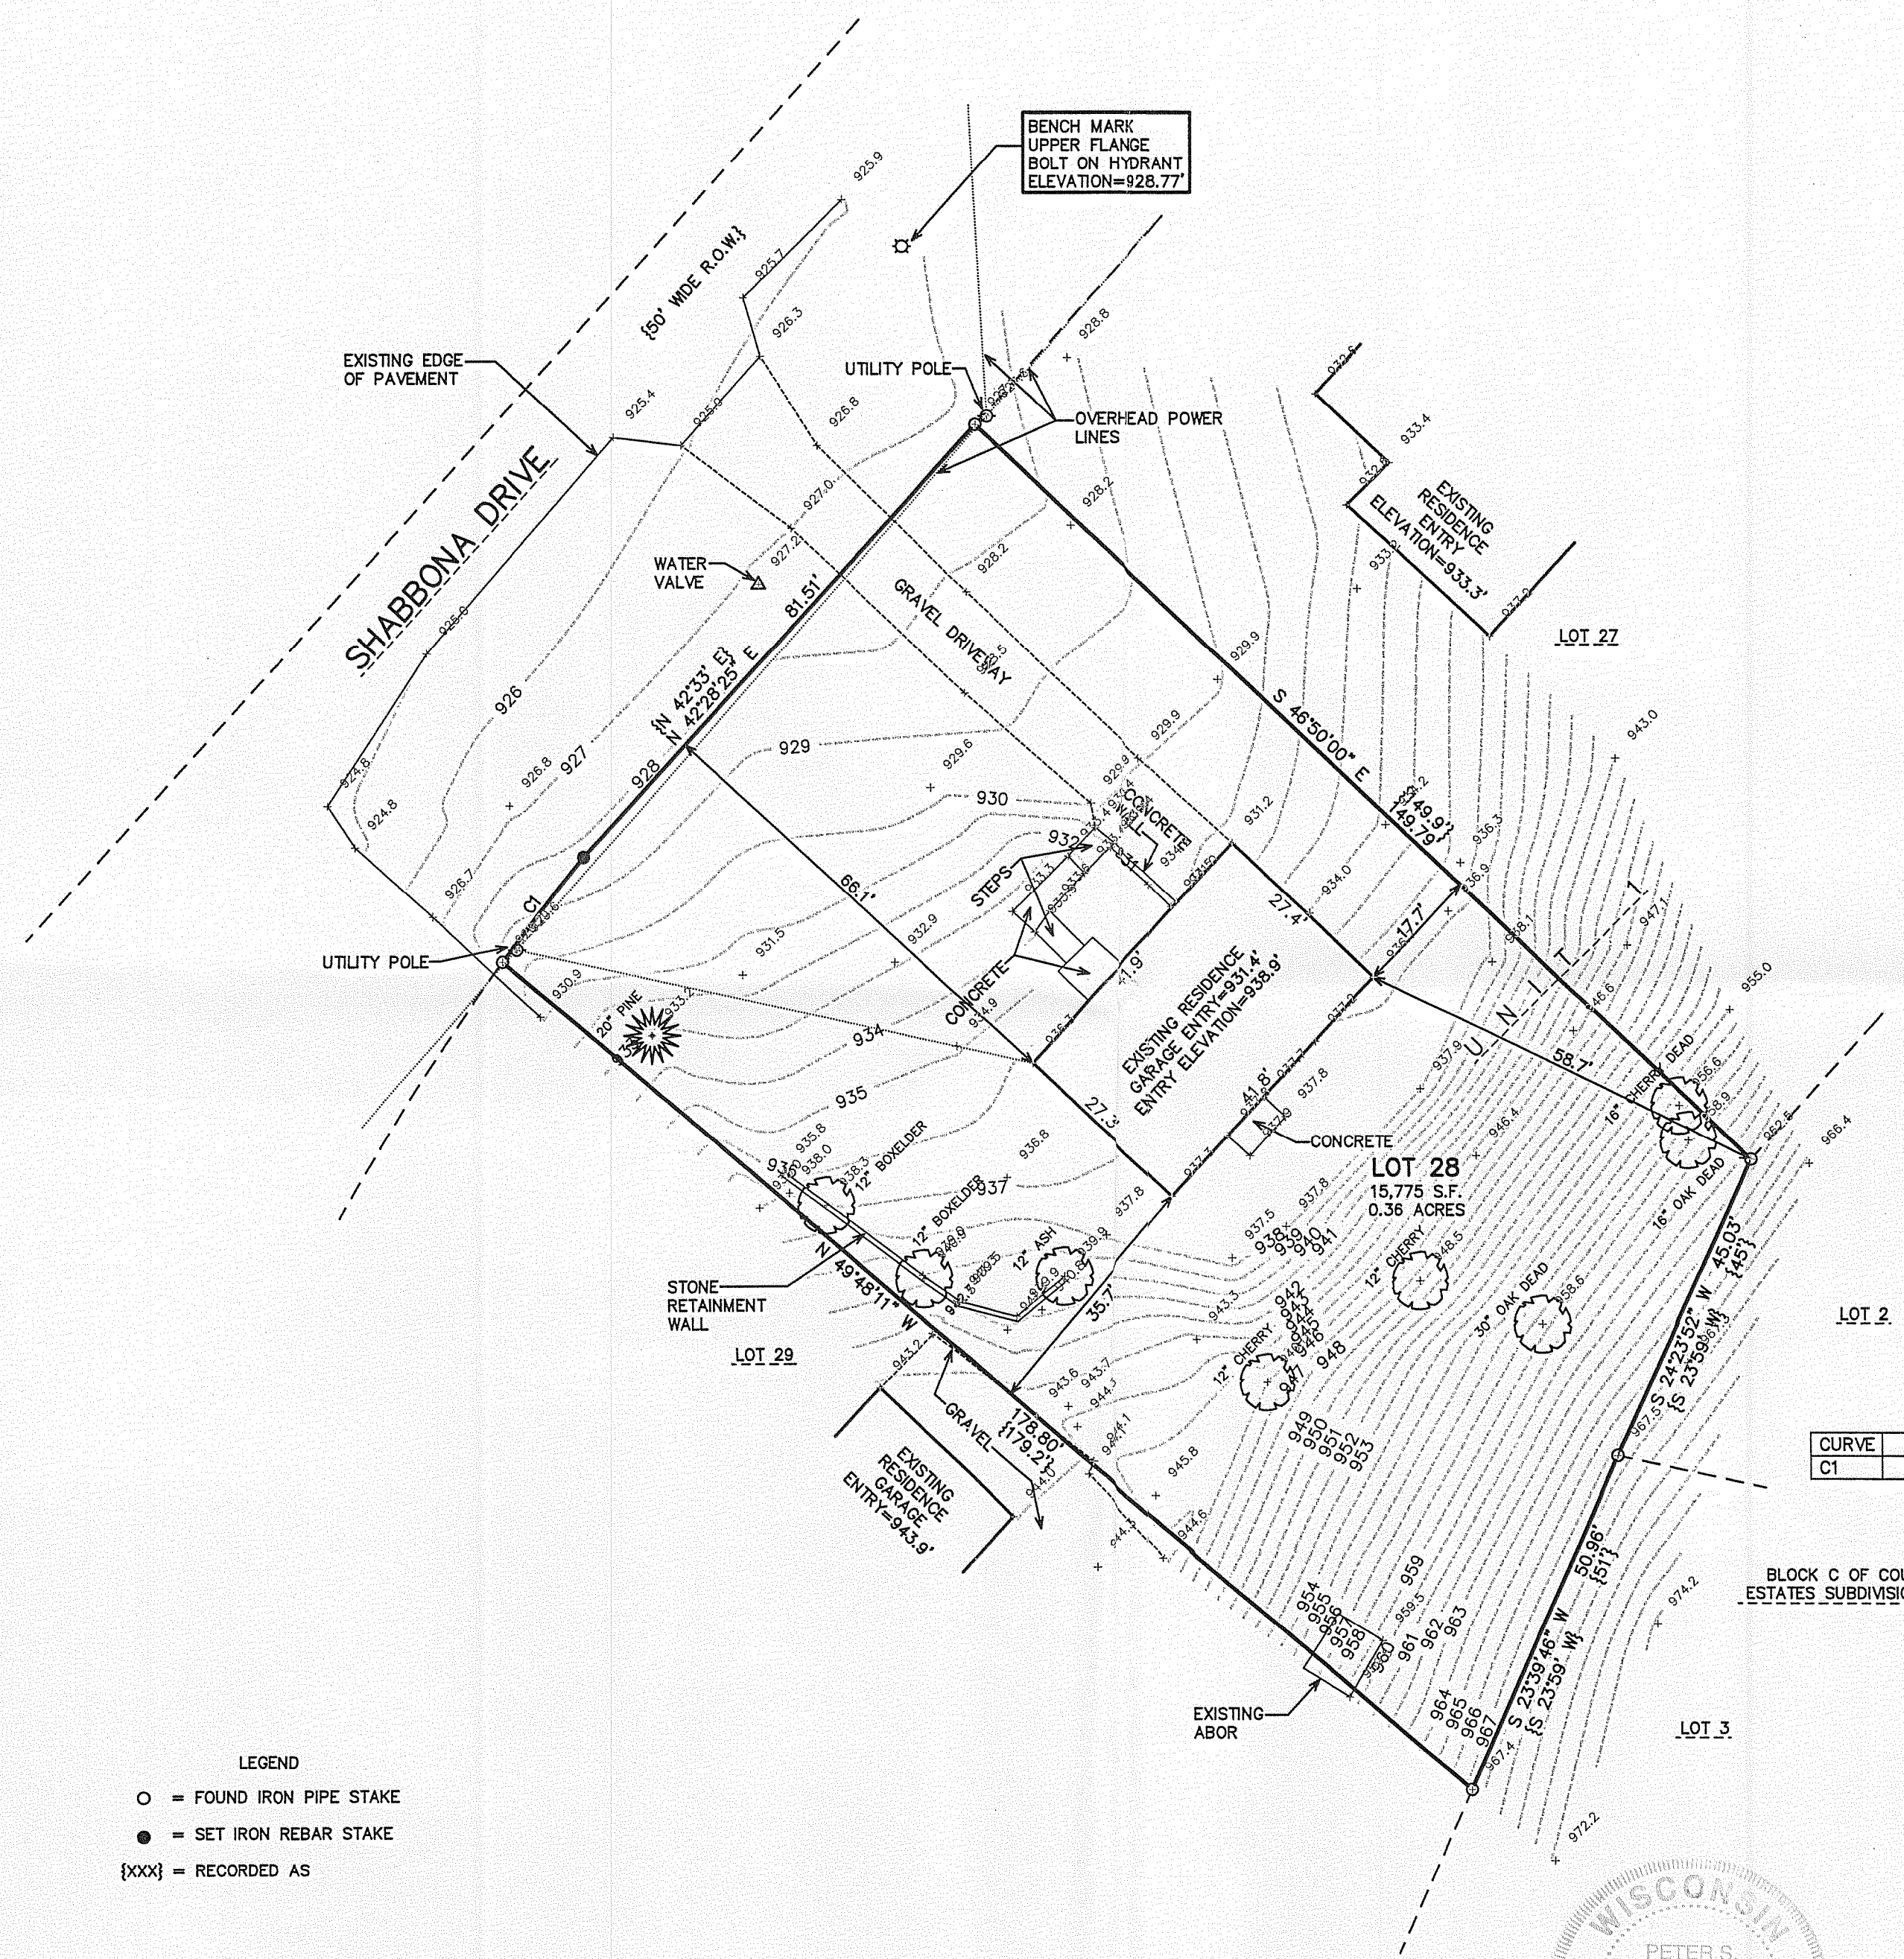

CURVE	ARC	RADIUS	CHORD LENGTH	CHORD BEARING
C1	18.52	355.95	18.52	N 37°45'34" E

BLOCK C OF COUNTRY CLUB
ESTATES SUBDIVISION UNIT NO. 3




NOTE: COPIES OF THIS MAP TO WHICH THE FOLLOWING CERTIFICATE WILL APPLY SHOW THE SURVEYOR'S ORIGINAL SEAL AND SIGNATURE IN RED INK. COPIES BY ANY OTHER MEANS MAY HAVE ALTERATIONS WHICH DO NOT REPRESENT THE SURVEYOR'S WORK PRODUCT.


I HEREBY CERTIFY THAT THE ABOVE DESCRIBED PROPERTY HAS BEEN SURVEYED UNDER MY DIRECTION AND THAT THE ABOVE MAP IS A TRUE REPRESENTATION THEREOF AND SHOWS THE SIZE AND LOCATION OF THE PROPERTY AND ITS EXTERIOR BOUNDARIES. THIS SURVEY IS MADE FOR THE USE OF THE PRESENT OWNERS OF THE PROPERTY, AND ALSO THOSE WHO PURCHASE, MORTGAGE, OR GUARANTEE THE TITLE THERETO WITHIN ONE YEAR FROM THE DATE HEREOF.

DATED: APRIL 15, 2008

Peter S. Gordon
PETER S. GORDON R.L.S. 2101

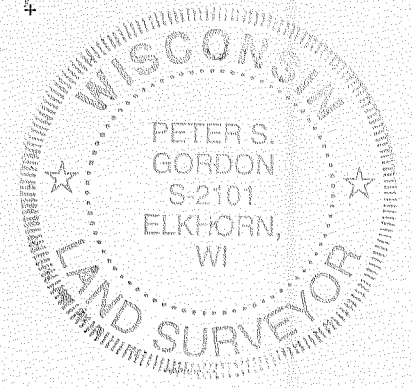

- LEGEND
- = FOUND IRON PIPE STAKE
 - = SET IRON REBAR STAKE
 - {xxx} = RECORDED AS

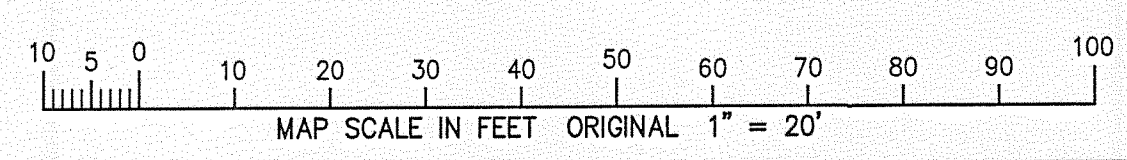

SCO 1 - 26A

005 - 2574