


PLAT OF SURVEY  
 LOTS 6-9, BLOCK 15 OF GLENWOOD SPRINGS  
 LOCATED IN PART OF THE VILLAGE OF FONTANA-ON-GENEVA LAKE,  
 WALWORTH COUNTY, WISCONSIN

SOUTH LINE OF SAID LOT 9  
 BEARS S 90°00'00" W

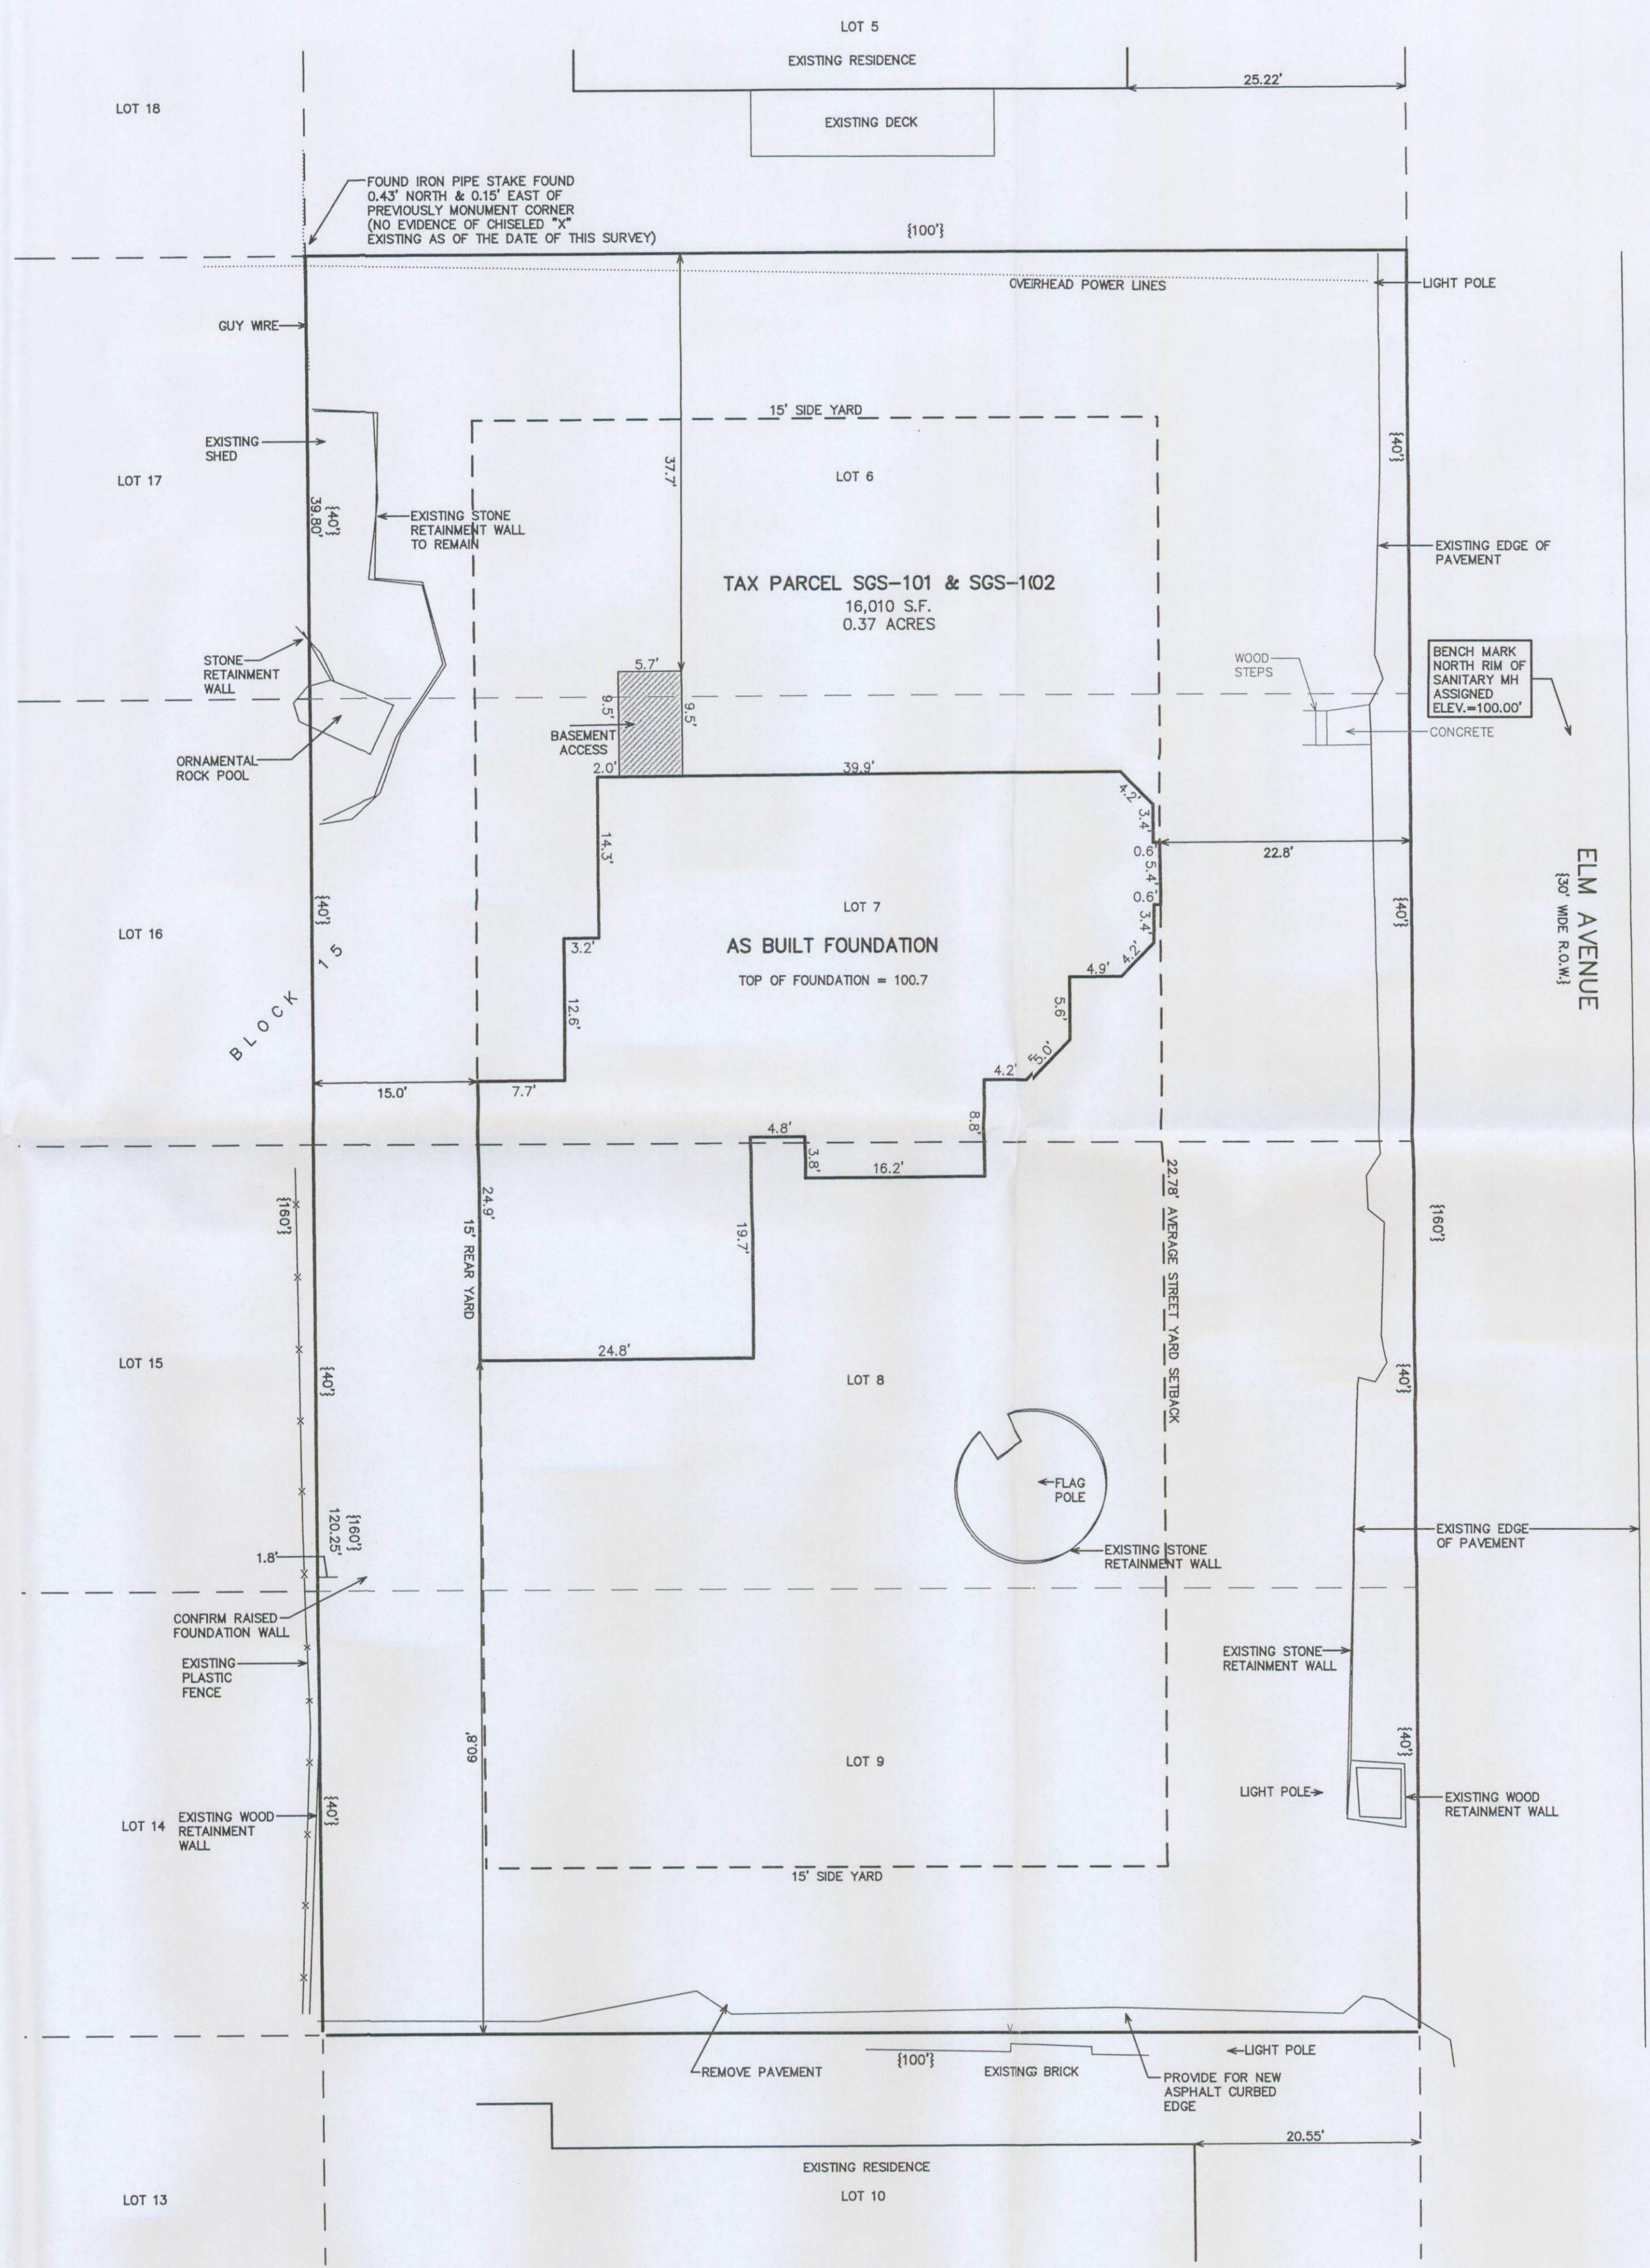

- LEGEND
- = FOUND IRON PIPE STAKE
  - = FOUND IRON REBAR STAKE
  - x = FOUND NAIL IN ROCK
  - {xxx} = RECORDED AS

STREET YARD AVERAGE SUMMARY:  
 25.22' (25') TO NORTH + 20.55' TO SOUTH = 45.55' / 2 = 22.78' MIN. STREET YARD SETBACK

BUILDING HEIGHT SUMMARY:  
 LOWEST EXISTING GRADE AT PROPOSED BUILDING FOOTPRINT = 99.15'  
 99.15' + 35' = 134.15' MAXIMUM BUILDING HEIGHT  
 PROPOSED BUILDING ROOF HEIGHT = 131.4' TO RIDGE

SITE SOILS  
 MpB & MpC - McHENRY SILT LOAM


IMPERVIOUS SURFACE AFTER CONSTRUCTION = 6223 S.F. (39%)  
 GREEN SPACE = 61%

WORK ORDERED BY -  
 TODD CAUFMANN  
 LOWELL MANAGEMENT SERVICES, INC.  
 PO BOX 926  
 LAKE GENEVA, WI 53147

FARRIS, HANSEN & ASSOCIATES, INC.  
 ENGINEERING - ARCHITECTURE - SURVEYING  
 7 RIDGWAY COURT P.O. BOX 437  
 ELKHORN, WISCONSIN 53121  
 OFFICE: (262) 723-2098 FAX: (262) 723-5886


REVISIONS  
 09-18-2009  
 MSC REV.'S

09-25-2009  
 ADD GREEN SPACE COMP.

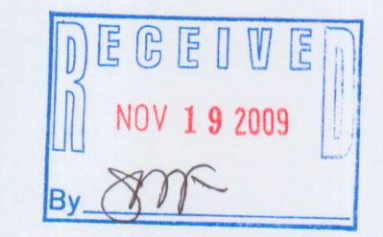


NOTE: COPIES OF THIS MAP TO WHICH THE FOLLOWING CERTIFICATE  
 WILL APPLY SHOW THE SURVEYOR'S ORIGINAL SEAL AND SIGNATURE  
 IN RED INK. COPIES BY ANY OTHER MEANS MAY HAVE ALTERATIONS  
 WHICH DO NOT REPRESENT THE SURVEYOR'S WORK PRODUCT.

I HEREBY CERTIFY THAT THE ABOVE DESCRIBED PROPERTY HAS BEEN  
 SURVEYED UNDER MY DIRECTION AND THAT THE ABOVE MAP IS A TRUE  
 REPRESENTATION THEREOF AND SHOWS THE SIZE AND LOCATION OF  
 THE PROPERTY AND ITS EXTERIOR BOUNDARIES. THIS SURVEY IS  
 MADE FOR THE USE OF THE PRESENT OWNERS OF THE PROPERTY, AND  
 ALSO THOSE WHO PURCHASE, MORTGAGE, OR GUARANTEE THE TITLE  
 THERETO WITHIN ONE YEAR FROM THE DATE HEREOF.

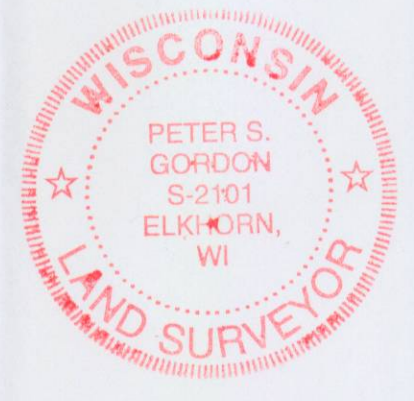

DATED: AUGUST 26, 2009 REVISED 10-30-2009  
 TO SHOW AS BUILT FOUNDATION

*Peter S. Gordon*  
 PETER S. GORDON R.L.S. 2101

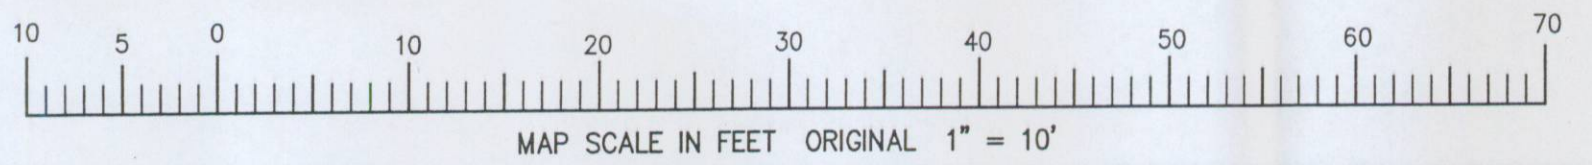

SGS-101 SGS-102

005-2699

PROJECT NO.  
 7977  
 DATE  
 09/04/2009  
 SHEET NO.  
 1 OF 1