


REVISIONS
5/22/2013-KB ADD ADDITIONAL TOPOGRAPHIC INFORMATION BY UNIT 2


005-2996

LOCATED IN THE SW 1/4 OF THE NE 1/4 SECTION 13
TOWN 1 NORTH, RANGE 16 EAST
VILLAGE OF FONTANA—ON—GENEVA LAKE
WALWORTH COUNTY, WI.

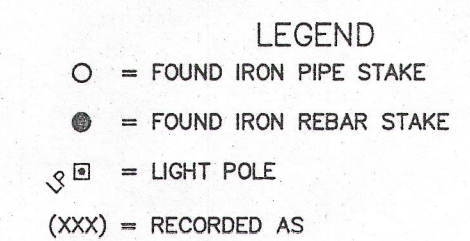

005-2996

7/31/2013 X:\Projects\8757\DCAD\AS-BUILT_20130731

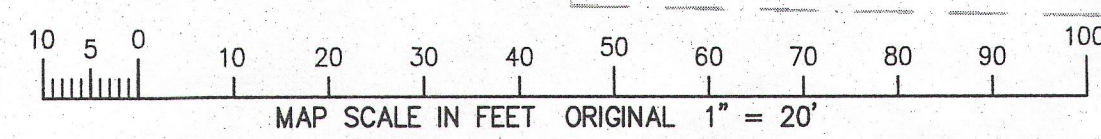

SOUTH LAKESHORE DRIVE

66' WIDE