

# FARRIS, HANSEN & ASSOCIATES, INC.


ENGINEERING – ARCHITECTURE – SURVEYING  
7 RIDGWAY COURT – P.O. BOX 437 – ELKHORN, WISCONSIN 53121  
PHONE: (262) 723-2098 FAX: (262) 723-5886

– WORK ORDERED BY –  
GENEVA LAKE DREAM HOMES, LLC  
PO BOX 29  
LAKE GENEVA, WI 53147

## PLAT OF SURVEY

LOTS 3-5 & 34-36 GLENWOOD SPRINGS ADDITION  
VILLAGE OF FONTANA-ON-GENEVA LAKE, WALWORTH COUNTY, WISCONSIN

N. LINE OF LOTS 3 & 36 ASSUMED  
TO BEAR EAST

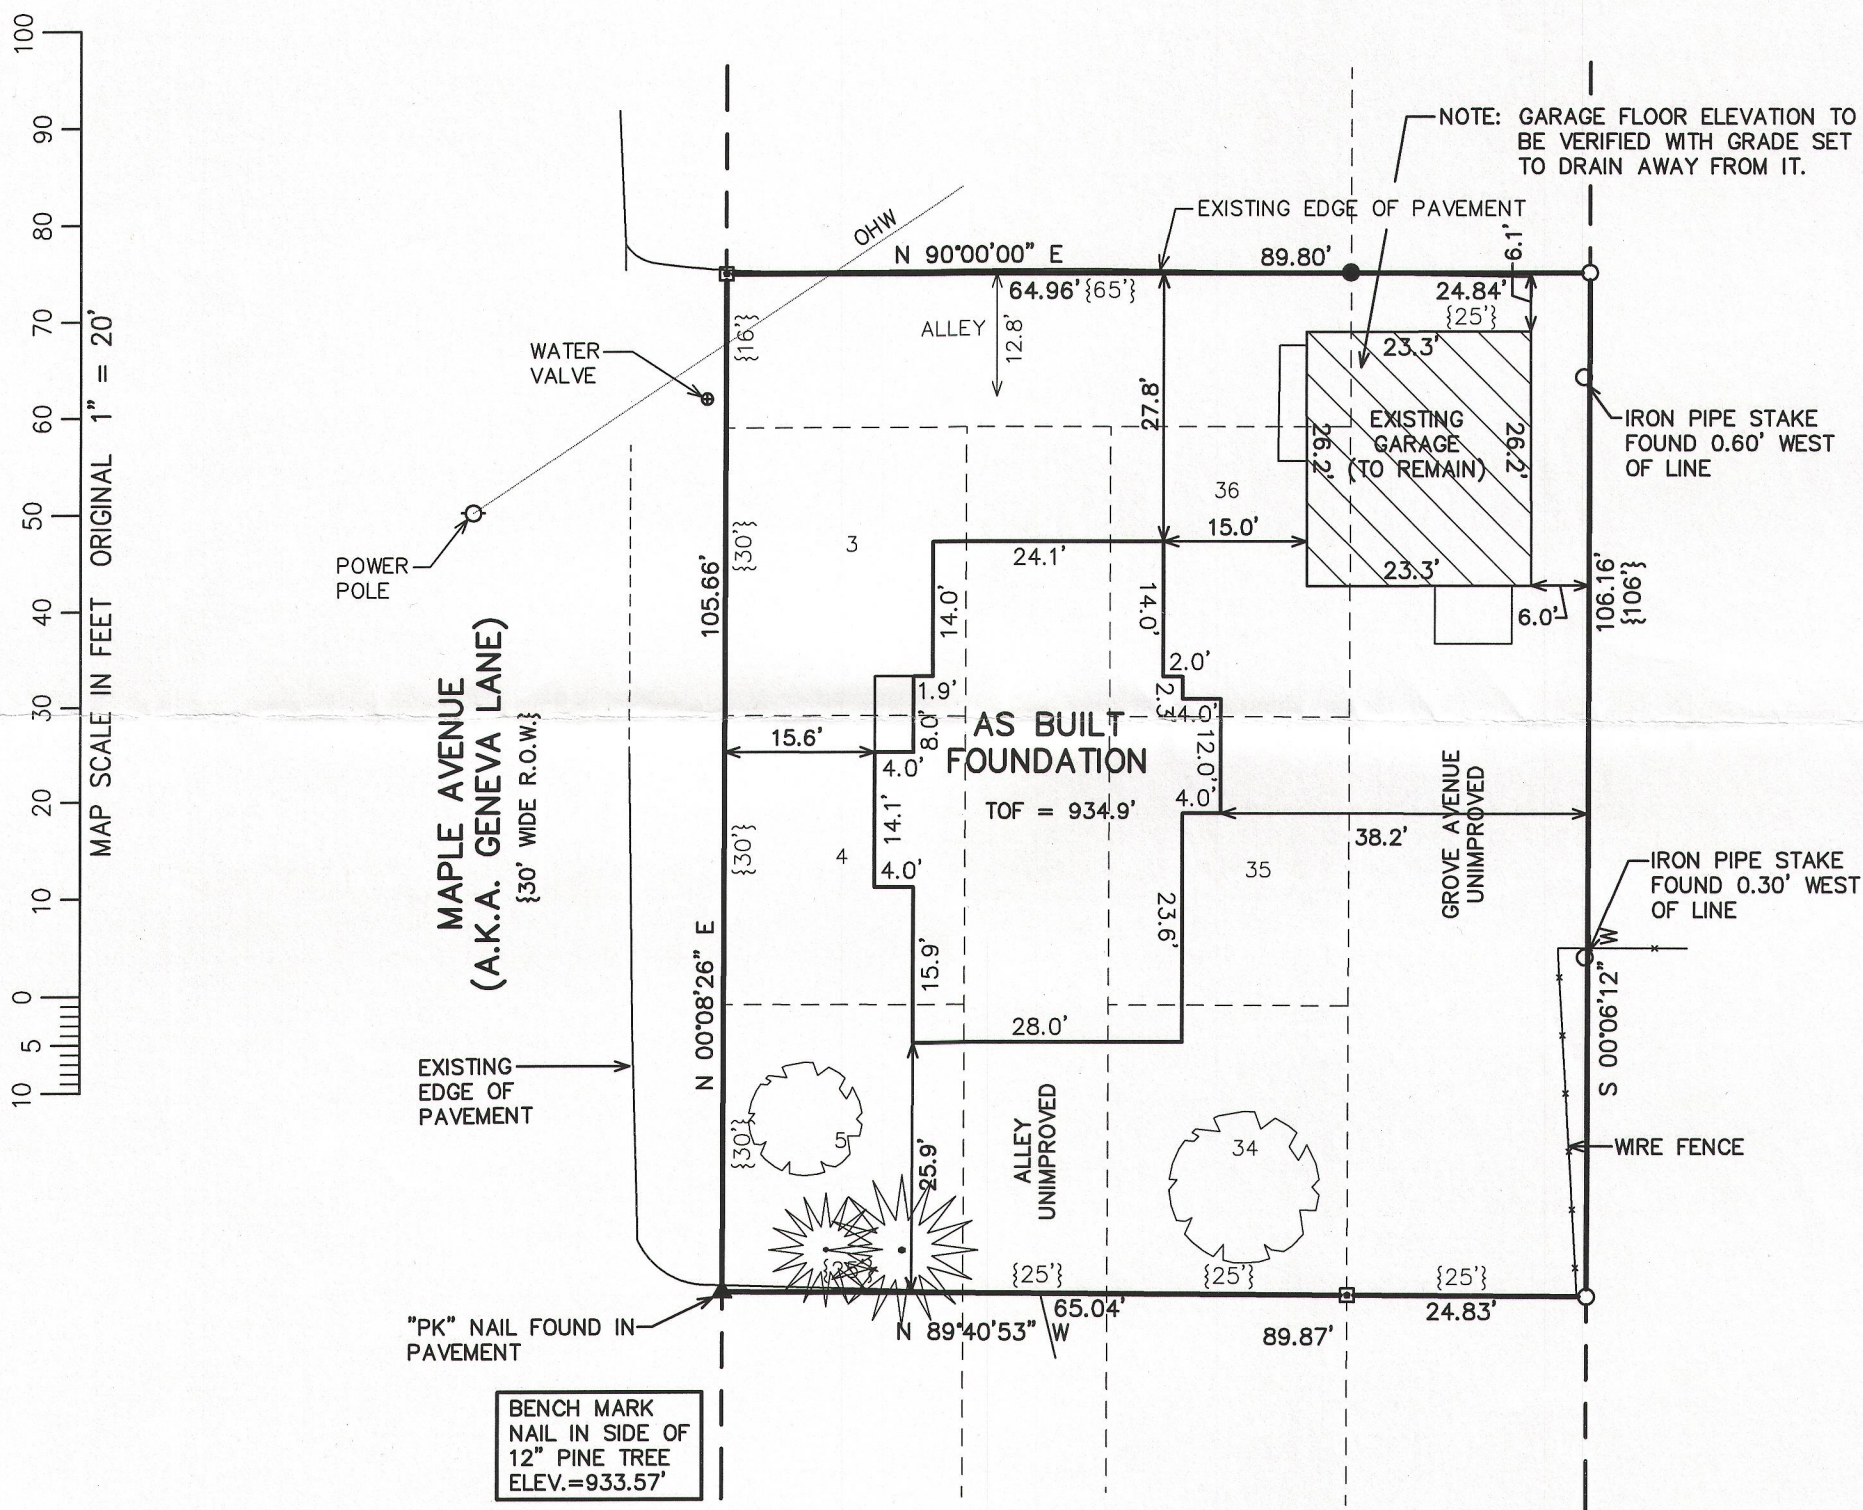

### STREET YARD AVERAGE CALCULATION:

$$25.0' \text{ (MINIMUM)} + 6.1' \text{ (RES. TO SOUTH)} = 31.1'$$

$$31.1' / 2 = 15.55' \text{ MINIMUM SETBACK}$$

$$\text{TOTAL LAND AREA} = 9,513 \text{ S.F. (0.22 ACRES)}$$


NOTE: COPIES OF THIS MAP TO WHICH THE FOLLOWING CERTIFICATE WILL APPLY SHOW THE SURVEYOR'S ORIGINAL SEAL AND SIGNATURE IN RED INK. COPIES BY ANY OTHER MEANS MAY HAVE ALTERATIONS WHICH DO NOT REPRESENT THE SURVEYOR'S WORK PRODUCT.

I HEREBY CERTIFY THAT THE ABOVE DESCRIBED PROPERTY HAS BEEN SURVEYED UNDER MY DIRECTION AND THAT THE ABOVE MAP IS A TRUE REPRESENTATION THEREOF AND SHOWS THE SIZE AND LOCATION OF THE PROPERTY AND ITS EXTERIOR BOUNDARIES. THIS SURVEY IS MADE FOR THE USE OF THE PRESENT OWNERS OF THE PROPERTY, AND ALSO THOSE WHO PURCHASE, MORTGAGE, OR GUARANTEE THE TITLE THERETO WITHIN ONE YEAR FROM THE DATE HEREOF.

DATED: AUGUST 29, 2014


REVISED: 9/22/2014-KB  
TO SHOW STREET YARD AVERAGE  
NOTE

REVISED 11-26-2014  
TO SHOW SIZE & LOCATION OF  
AS BUILT FOUNDATION

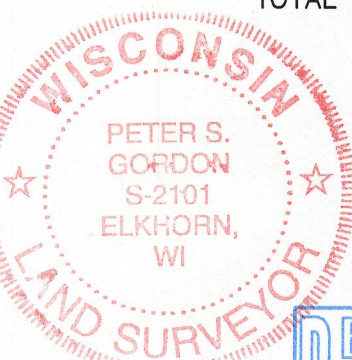

### LEGEND

- = IRON PIPE STAKE FOUND
- = IRON REBAR STAKE FOUND
- = 6" CONCRETE MONUMENT WITH PIN
- {XXX} = RECORDED AS

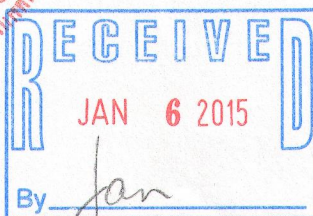

*Peter S. Gordon*  
PETER S. GORDON R.L.S. 2101

PROJECT: 9120  
DATE: 8/29/2014  
SHEET 1 OF 1

8G8A-3  
8G8A-17

0053091