

FARRIS, HANSEN & ASSOCIATES, INC.





ENGINEERING — ARCHITECTURE — SURVEYING
7 RIDGWAY COURT — P.O. BOX 437 — ELKHORN, WISCONSIN 53121
PHONE: (262) 723-2098 FAX: (262) 723-5886

— WORK ORDERED BY —
KEN HARKNESS
1808A WILDBERRY DRIVE
GLENVIEW, IL 60025

RIPARIAN MAPPING

TAX PARCEL SS&G 00002 (HARKNESS PROPERTY)

BEING LOT 2 OF STEARNS & GEROULDS SUBDIVISION
VILLAGE OF FONTANA-ON-GENEVA LAKE, WALWORTH COUNTY, WISCONSIN

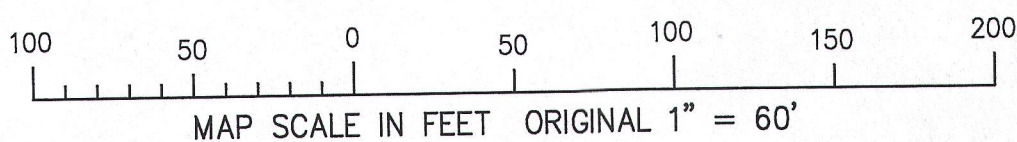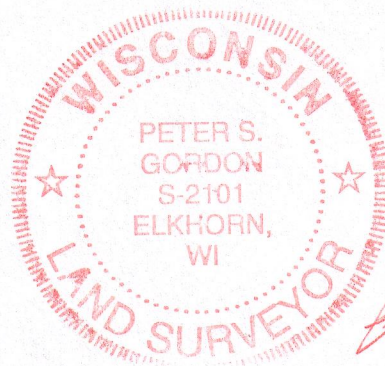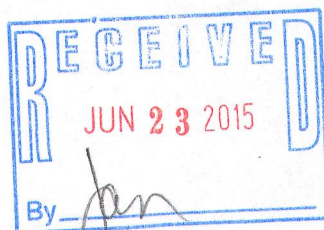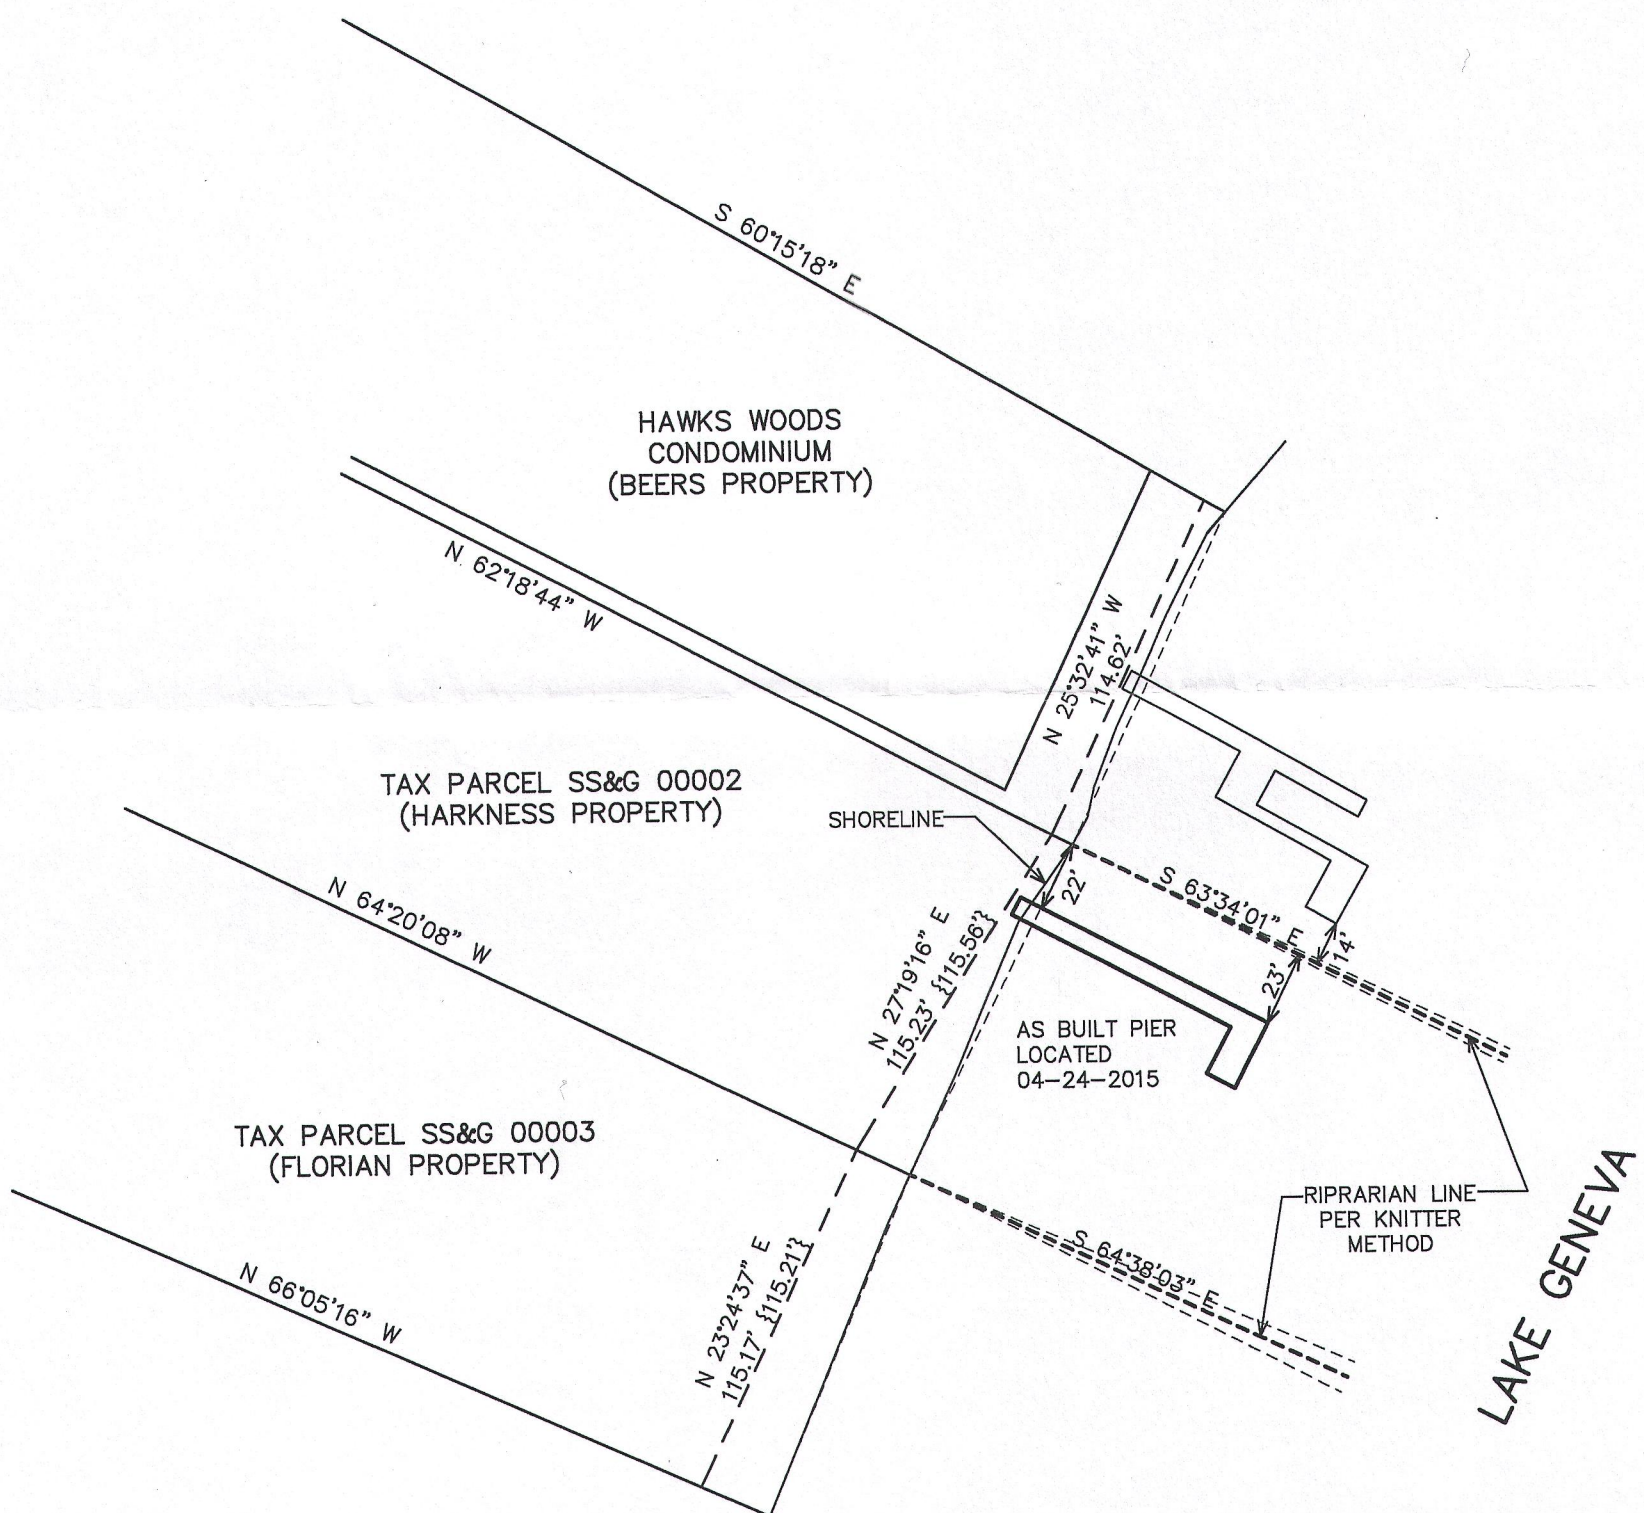

PROJECT: 9240
DATE: 3/23/2015
SHEET 1 OF 1