


PLAT OF SURVEY
-OF-

LOTS J10 AND J11 OF COUNTRY CLUB ESTATES, ADDITION "J", A SUBDIVISION LOCATED IN OUTLOTS 101, 102 & 103 OF THE ASSESSOR'S PLAT OF THE VILLAGE OF FONTANA-ON-GENEVA LAKE IN THE SOUTHWEST 1/4 OF SECTION 14 & THE NORTHWEST 1/4 OF SECTION 23 & THE NORTHEAST 1/4 OF SECTION 22, TOWNSHIP 1 NORTH, RANGE 16 EAST OF THE FOURTH PRINCIPAL MERIDIAN, IN THE VILLAGE OF FONTANA-ON-GENEVA LAKE, COUNTY OF WALWORTH AND STATE OF WISCONSIN.

SURVEY FOR: TRICIA FORBECK OF KEEFE REAL ESTATE
SURVEY ADDRESS: 981 TARRANT DRIVE, FONTANA, WI 53125

BEARINGS HEREON RELATE TO THE EASTERLY LINE OF TARRANT DRIVE. ASSUMED BEARING OF NORTH 09°33'40" EAST AS PLATTED.

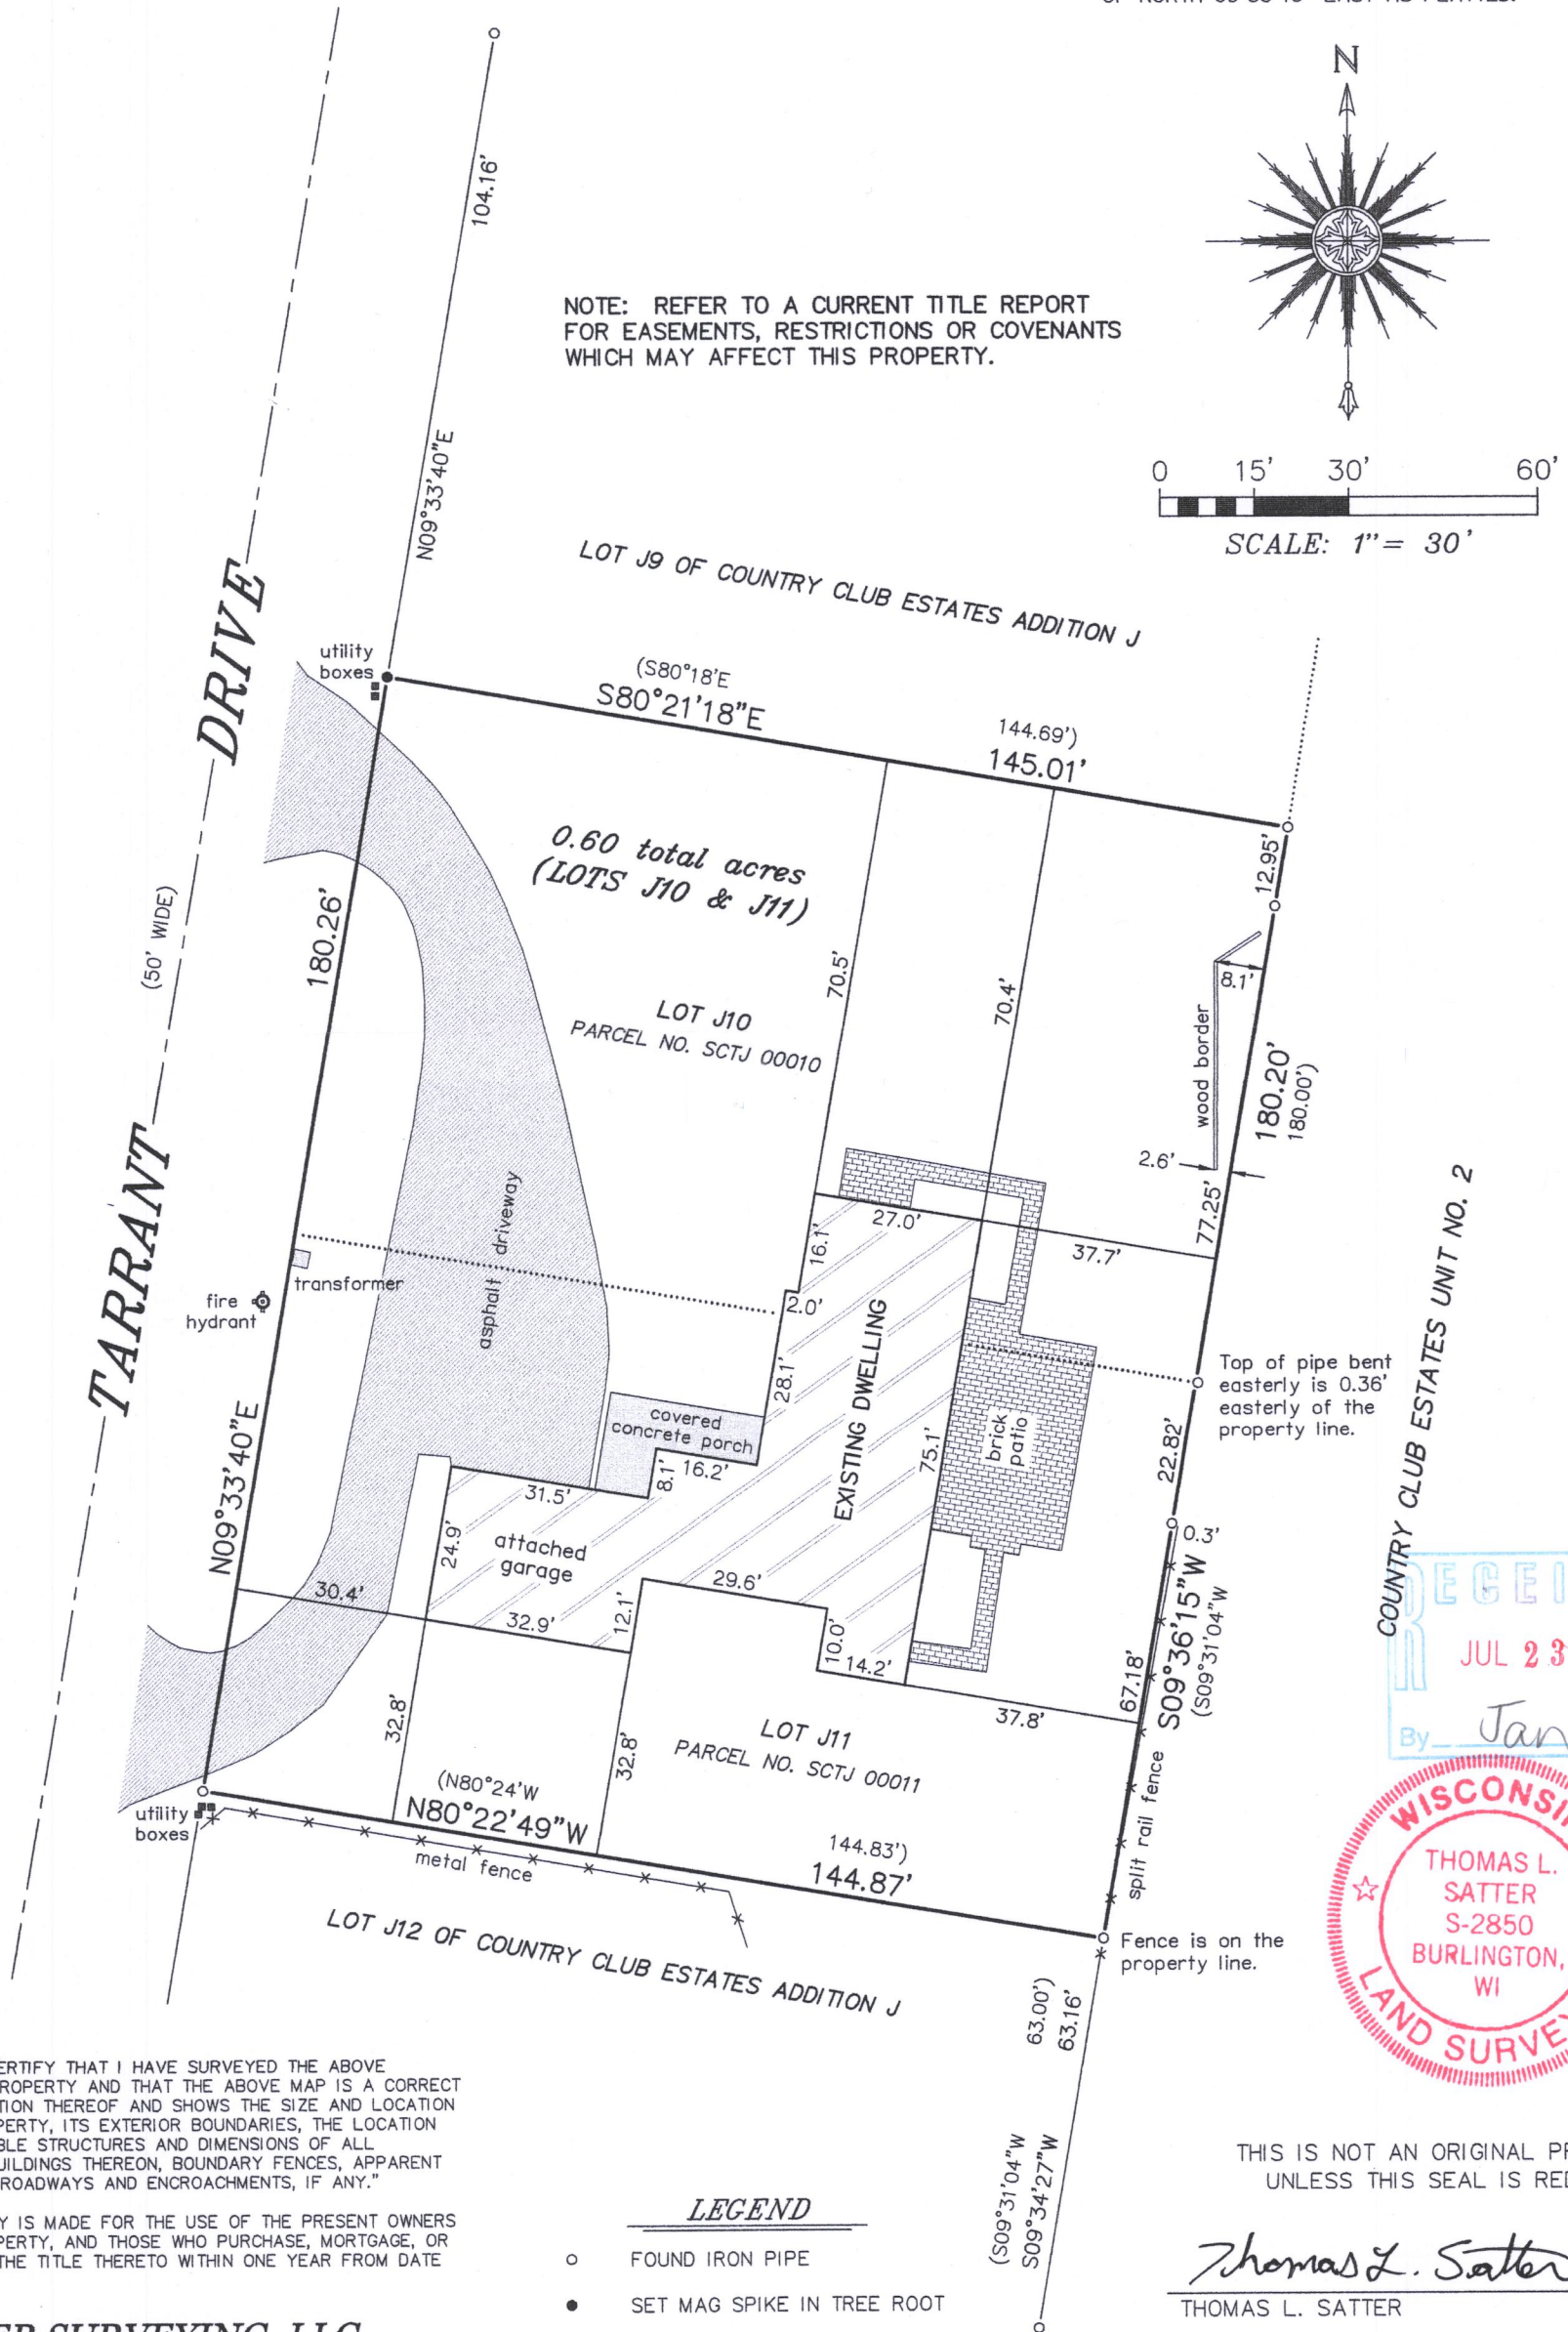

SATTER SURVEYING, LLC
LAND SURVEYS, MAPPING AND PLANNING
272 ORIGIN STREET
BURLINGTON, WI 53105
262-661-4239

JUNE 28, 2018
DATE

061802
JOB NUMBER

SCTJ-10
SCTJ-11

005-3413