



PREPARED FOR
ROBBIE BAGNI

PLAT OF SURVEY

- OF -

The North 35 feet of Lot 11 and the North 35 feet of Lot 12, both
in Block 3 of D.A. Reid's Addition to Reid's Park, Village of
Fontana-on-Geneva-Lake, in Walworth County, State of Wisconsin

PATHFINDER SURVEYING
(a NMB Company)
P.O BOX 322
LAKE GENEVA, WI. 53147
WWW.PATHFINDERSURVEYING.NET
262-248-8303

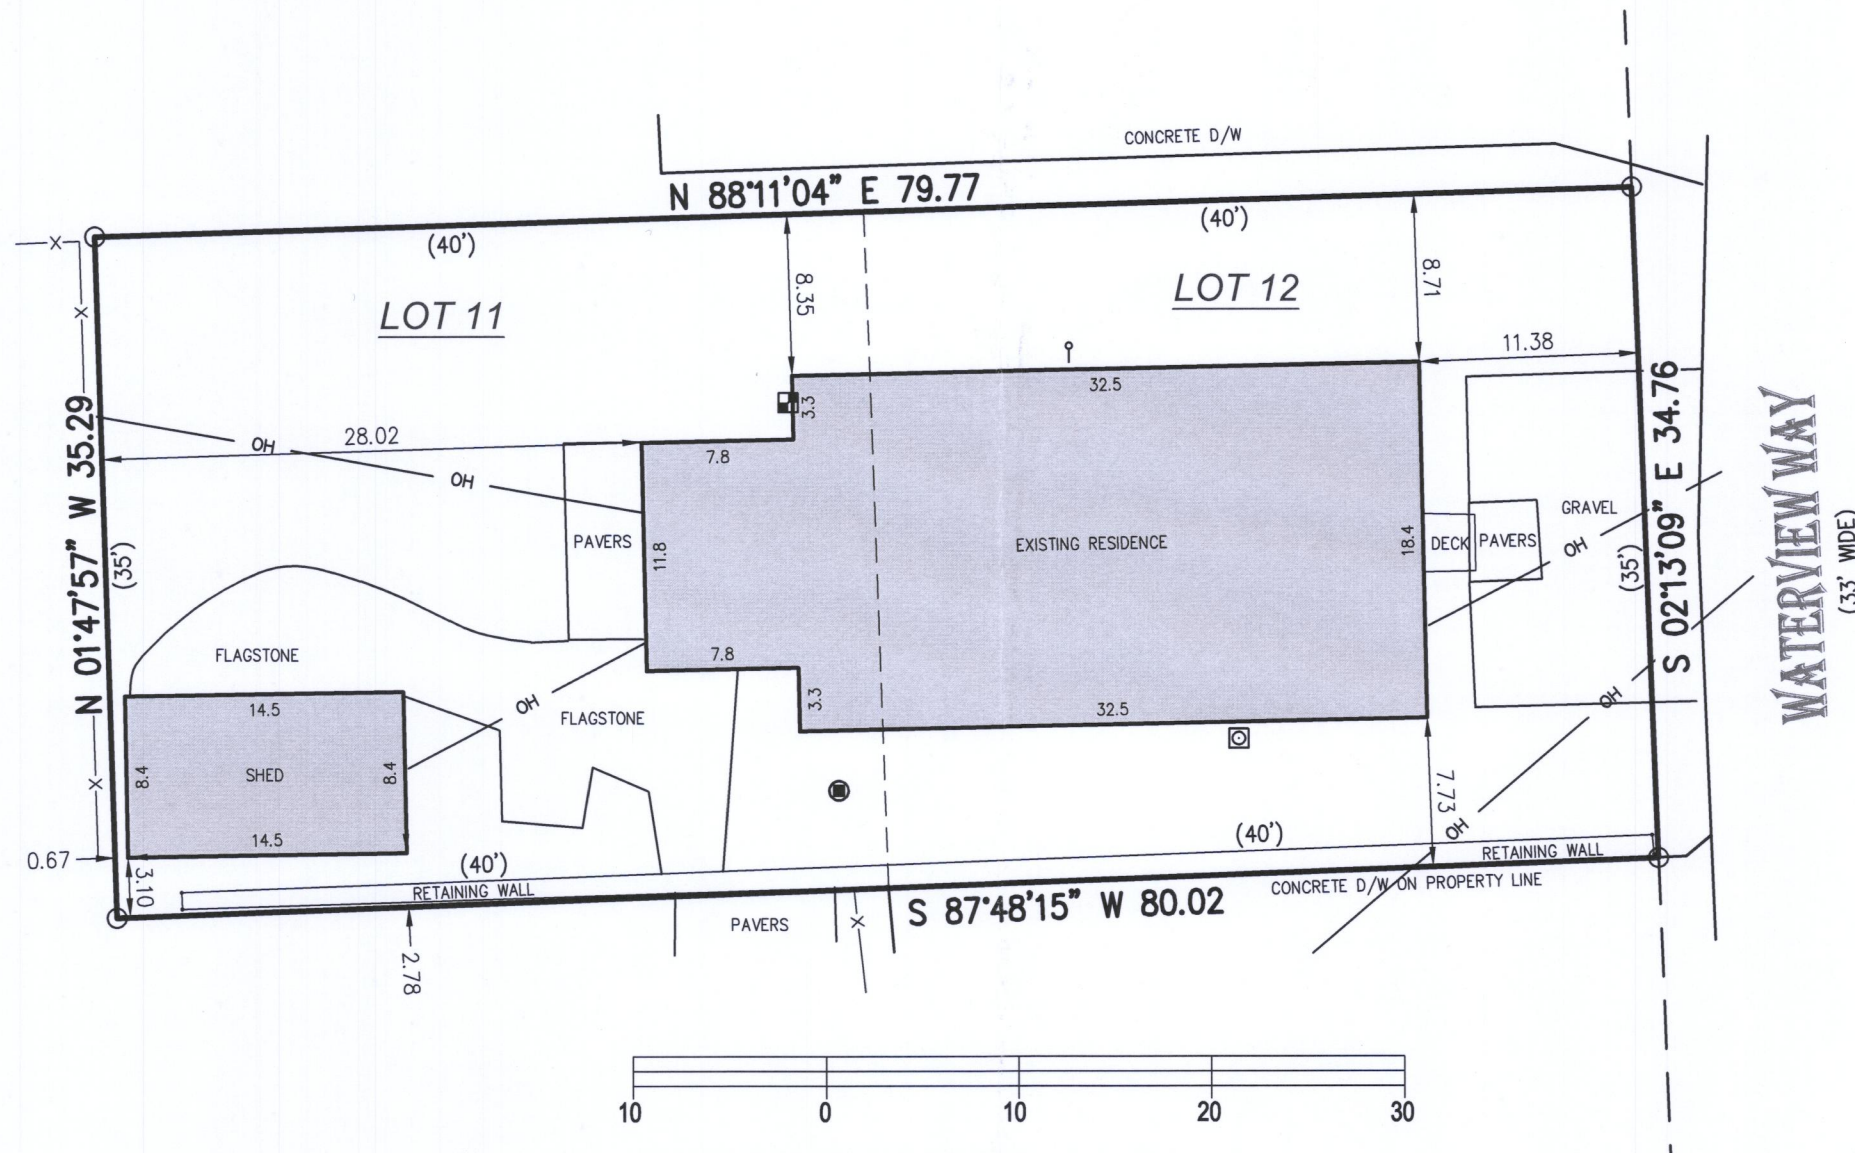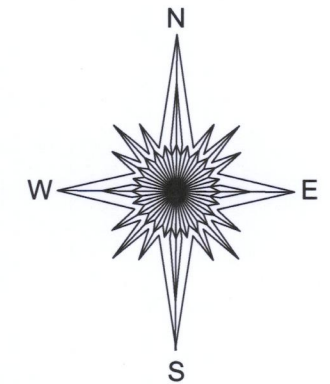

- () = recorded as
- ⊙ = miscellaneous manhole
- = found iron pipe
- OH — = overhead wires
- ⌚ = clean out
- ⊗ = gas meter
- X — = fence
- ⊞ = electric meter

SCALE 1" = 10'

JOB # 2018.0127.01


TAX ID # SRA 00020

BASIS OF BEARING OF THIS PLAT: THE US STATE PLANE
COORDINATE SYSTEM SOUTH ZONE, NAD 83. WISCORS.

I hereby certify that I have surveyed the above- described property and the
above map is a true representation thereof and shows the size and
location of the property, its exterior boundaries, the location and dimensions
of all structures thereon, fences, apparent easements and roadways and
visible encroachments if any to the best of my knowledge and belief.

This survey is made for the present owners of the property, and those who
purchase, mortgage, or guarantee the title thereto, within one year from the
date hereof.

DATED THIS 3RD DAY OF MAY, 2018.

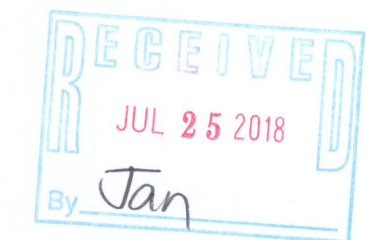

Mark R. Madsen
MARK R. MADSEN S - 2271
Wisconsin Professional Land Surveyor

SRA-20

005-3420