


PLAT OF SURVEY
-OF-


LOT 6 OF ADDITION "A" TO COUNTRY CLUB ESTATES, A SUBDIVISION LYING IN THE SOUTHWEST 1/4 OF THE SOUTHEAST 1/4 AND THE SOUTHEAST 1/4 OF THE SOUTHWEST 1/4 OF SECTION 14 AND IN THE NORTHWEST 1/4 OF THE NORTHEAST 1/4 OF SECTION 23, TOWNSHIP 1 NORTH, RANGE 16 EAST OF THE FOURTH PRINCIPAL MERIDIAN, IN THE VILLAGE OF FONTANA-ON-GENEVA LAKE, WALWORTH COUNTY, WISCONSIN.

SURVEY FOR: HARRY SOLING
SURVEY ADDRESS: 847 FEATHERSTONE DRIVE, FONTANA, WI 53125

- LEGEND
- FOUND IRON PIPE
 - ✕ FOUND IRON ROD
 - FOUND MASONRY NAIL
 - SET IRON PIPE
 - () RECORDED AS

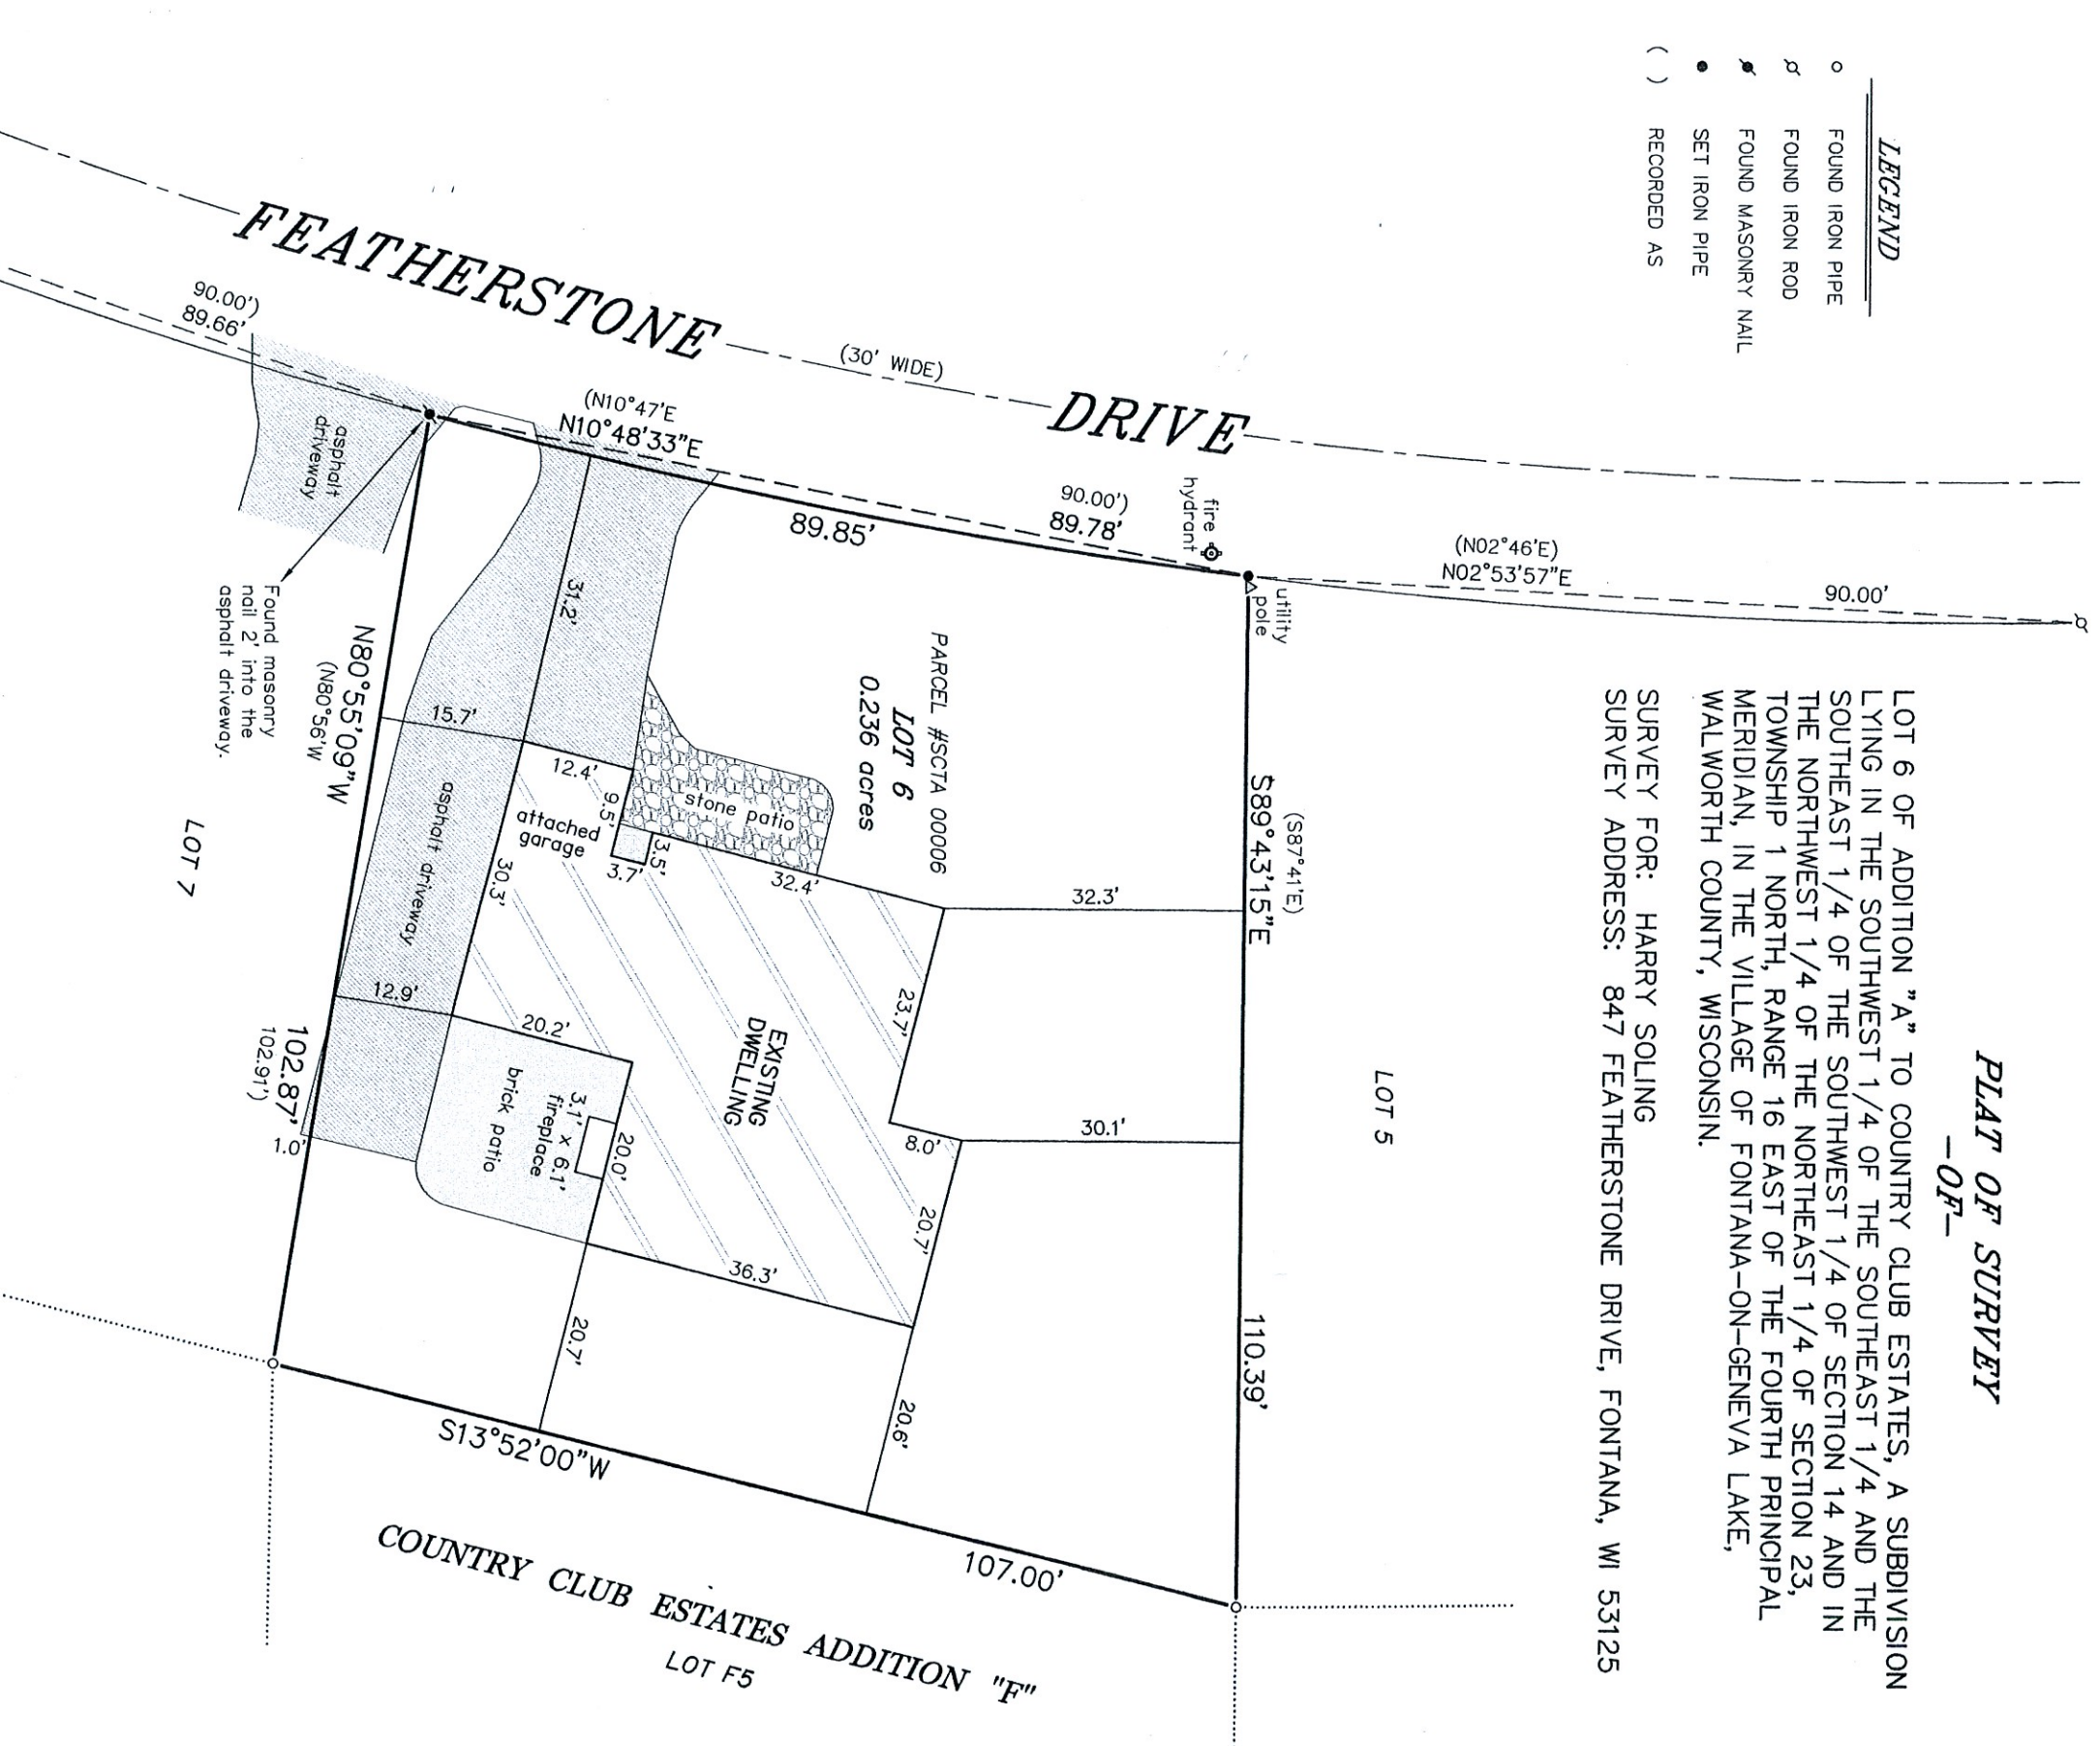

BEARINGS HEREON RELATE TO THE EAST LINE OF LOT 6 OF ADDITION "A" TO COUNTRY CLUB ESTATES. ASSUMED BEARING OF SOUTH 13°52'00" WEST AS PLATTED.

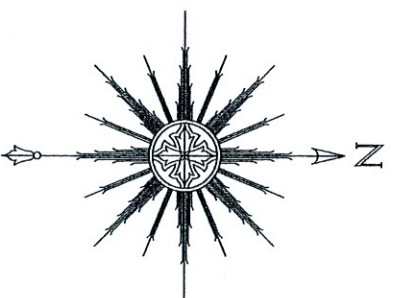

THIS IS NOT AN ORIGINAL PRINT
UNLESS THIS SEAL IS RED.

Thomas L. Satter

THOMAS L. SATTER S-2850

APRIL 28, 2021 042103
DATE JOB NUMBER

SATTER SURVEYING, LLC
LAND SURVEYS, MAPPING AND PLANNING
272 ORIGEN STREET
BURLINGTON, WI 53105
262-661-4239

0 10' 20' 40'
SCALE: 1" = 20'