


HAROLD H. KOLB

REGISTERED PROFESSIONAL LAND SURVEYOR
LAKE GENEVA, WISCONSIN



N

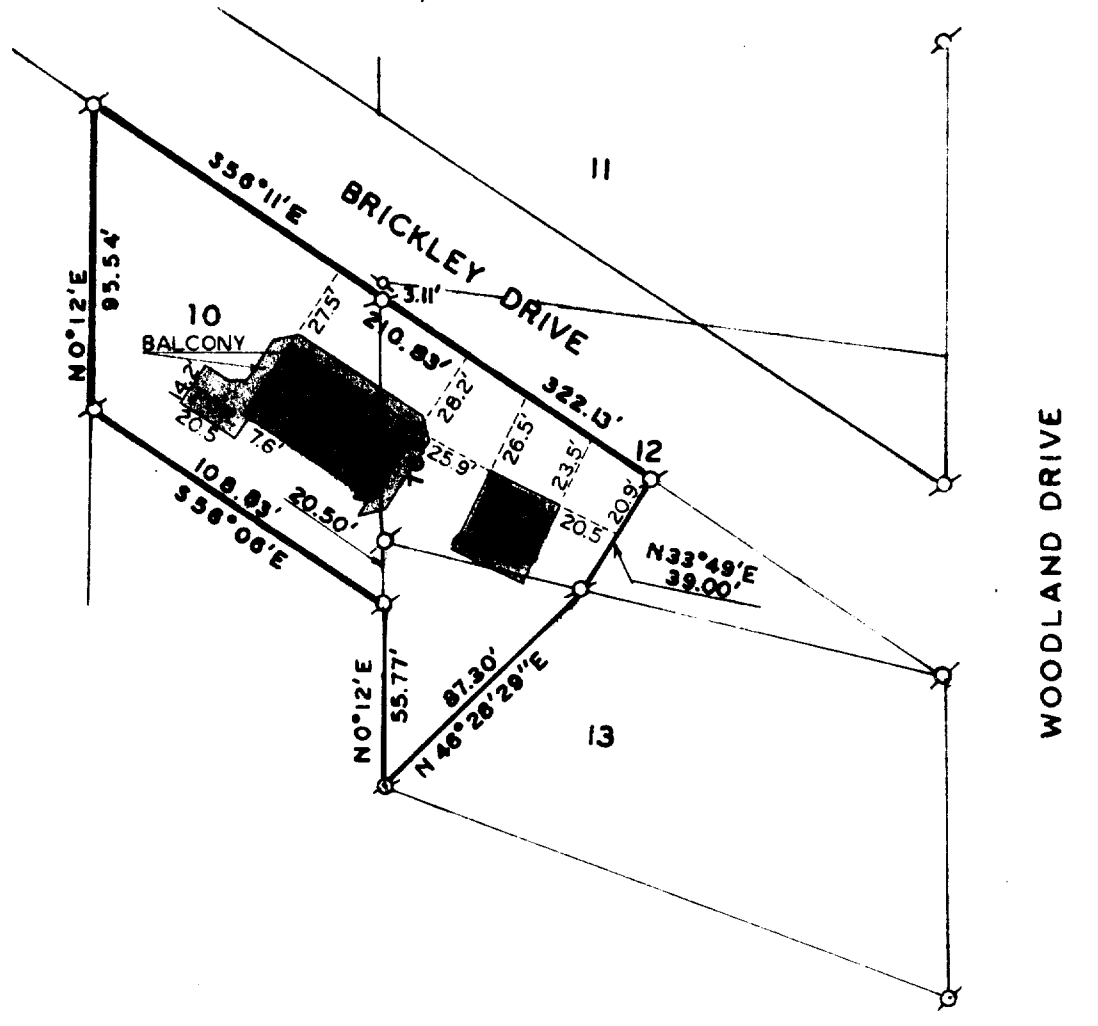

SCALE 1" = 60'

LEGEND


- ⊗ - IRON PIPE FOUND
- - IRON PIPE PLACED
- - CONCRETE MONUMENT
- x - SPIKE

Plat of survey of
part of lots 10, 12, and 13, Addition D
to Country Club Estates, Village
Frontage on Geneva Lake, Volworte
County, Wisconsin.

OWNERS: Roger Kolb

I, HAROLD H. KOLB, DO HEREBY CERTIFY THAT I HAVE
SURVEYED THE PROPERTY HEREON DESCRIBED ACCORDING
TO THE OFFICIAL RECORDS, AND THAT THE PLAT HEREON
IS A CORRECT REPRESENTATION OF THE LOT LINES.

Harold H. Kolb
HAROLD H. KOLB
WISCONSIN REGISTERED LAND SURVEYOR, S-187
DATE June 29, 1975

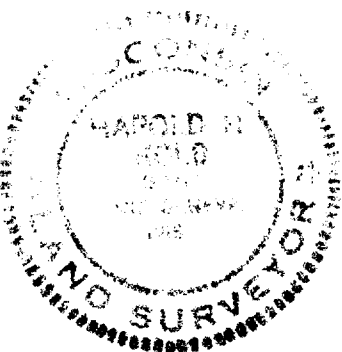

SCPD-10

REVISED: Feb. 10, 1975

5-388