

FARRIS, HANSEN & COOPER, INC.

ENGINEERING, SURVEYING AND LAND PLANNING
715 W. WALWORTH ST. - P.O. BOX 487 - ELKHORN, WI 53121
OFFICE: 414/723-2088

WARREN E. HANSEN
PROFESSIONAL ENGINEER

DANIEL D. COOPER
ROBERT A. FARRIS
LAND SURVEYOR



ENGINEERING
MUNICIPAL - STRUCTURAL
HIGHWAYS - PUBLIC WORKS

MORTGAGE INSPECTION SURVEY

SURVEYING & PLANNING
SUBDIVISIONS - LOT SURVEYS
CONSTRUCTION STAKING - MAPPING

LEGEND

- - IRON PIPE FOUND
- - CONC. MON. FOUND
- () - RECORD DIMENSION

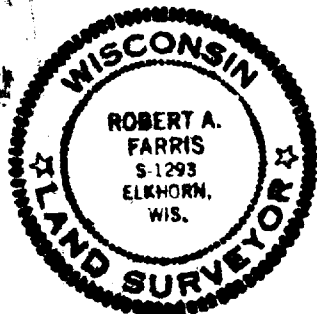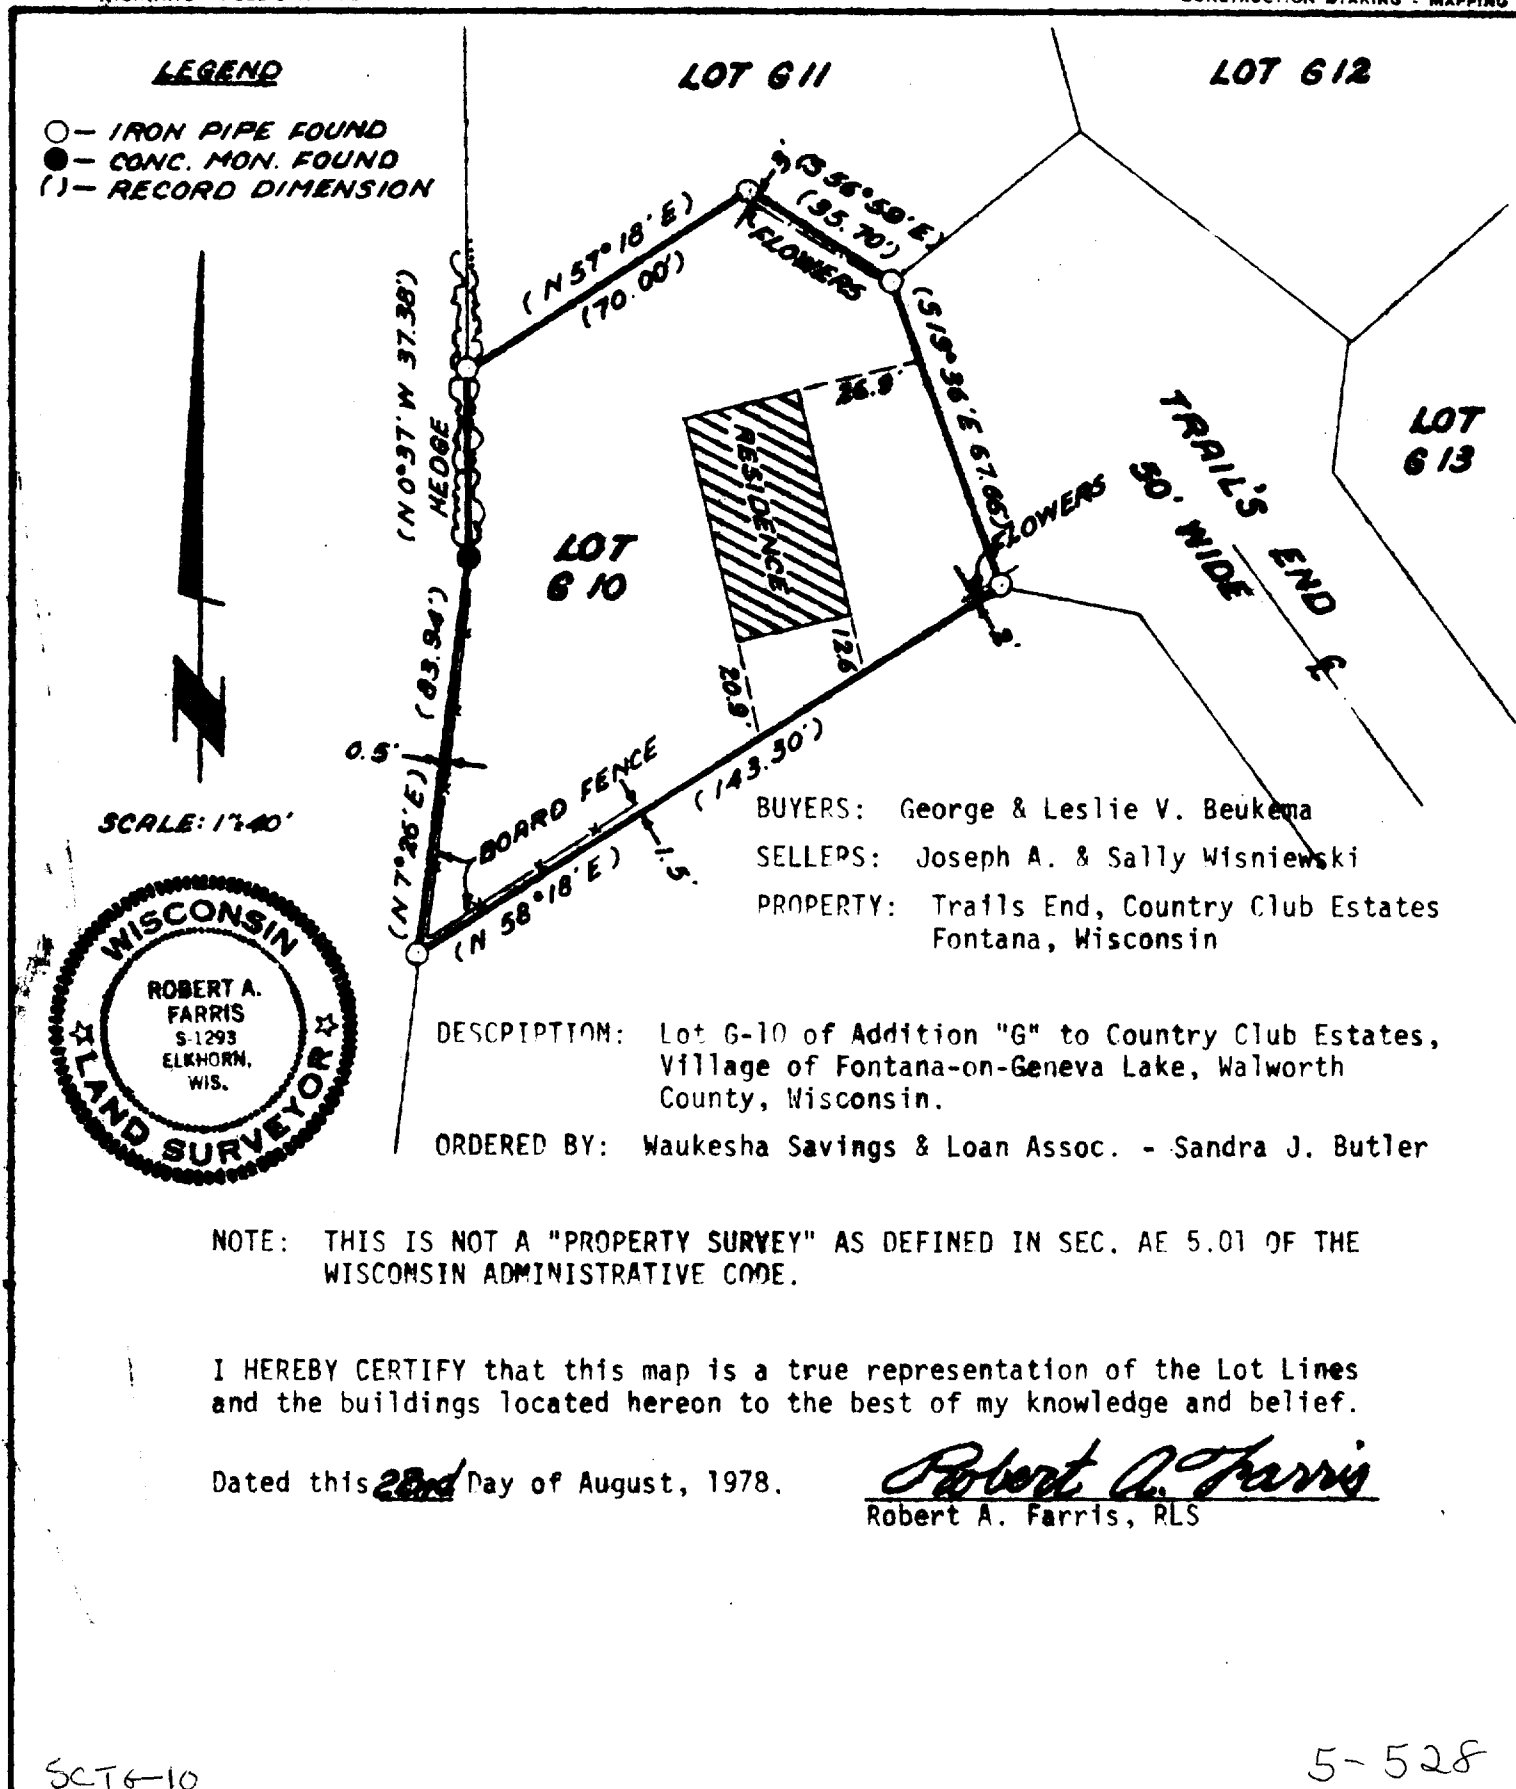

SGT6-10

5-528

NO. 1387