


KOLB LAND CONSULTING, INC.  
 LAND SURVEYING · SUBDIVIDING · LAND PLANNING

LAKE GENEVA, WISCONSIN 53147

WHITEWATER, WISCONSIN 53190

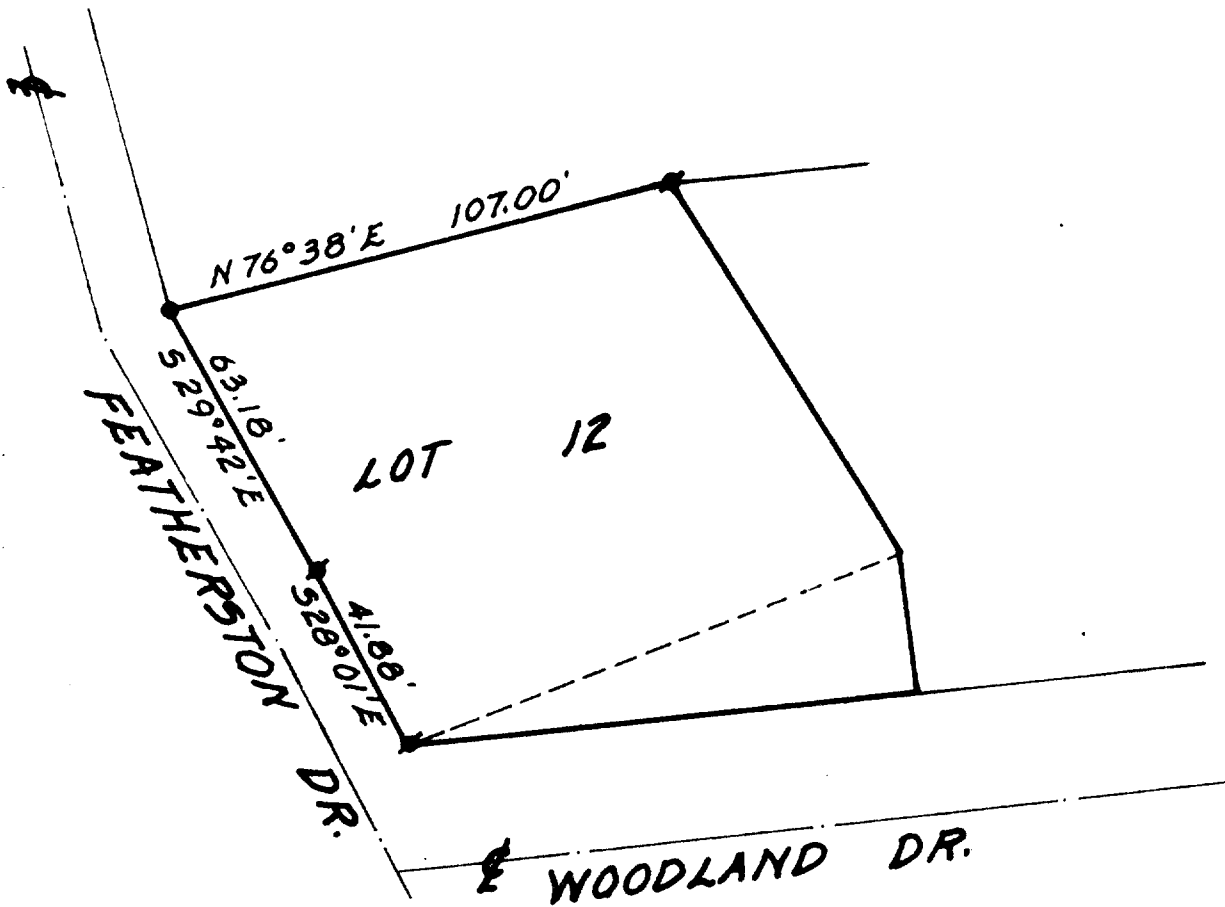

PLAT OF SURVEY OF

THE RELOCATION AND REMONUMENTATION OF THE NORTHWEST  
 CORNER OF LOT 12, ADDITION A TO COUNTRY CLUB ESTATES,  
 VILLAGE OF FONTANA-ON-GENEVA LAKE, WALWORTH COUNTY, WI.

ORDERED BY: WATER USERS CO-OP  
 P.O. BOX 97  
 FONTANA, WI. 53125




SCALE: 1"=40'

LEGEND

- CONCRETE MONUMENT FOUND
- CONCRETE MONUMENT SET

I, HAROLD H. KOLB, DO HEREBY CERTIFY  
 THAT I HAVE SURVEYED THE PROPERTY  
 HEREON DESCRIBED ACCORDING TO THE  
 OFFICIAL RECORDS, AND THAT THE PLAT  
 HEREON IS A CORRECT REPRESENTATION  
 OF THE LOT LINES TO THE BEST OF MY  
 KNOWLEDGE AND BELIEF.

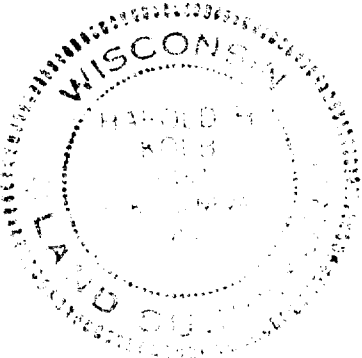

*Harold H. Kolb*

HAROLD H. KOLB  
 WISCONSIN REGISTERED LAND SURVEYOR, S-187  
 DATE OCTOBER 28, 1982