


KOLB LAND CONSULTING, INC.
 LAND SURVEYING · SUBDIVIDING · LAND PLANNING

929 WILLIAMS STREET LAKE GENEVA, WISCONSIN 53147 414-248-3697

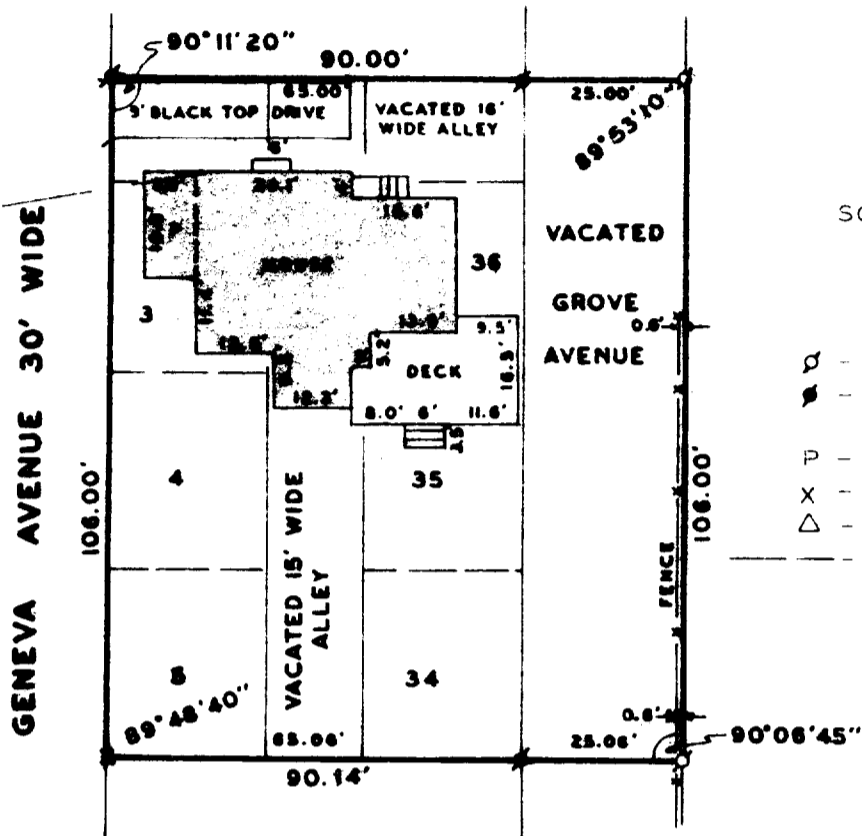

SCALE: 1" = 30'


LEGEND

- ⊙ - IRON PIPE FOUND
- ⊙ - 6" DIA. CONCRETE MON. FOUND
- P - PORCH
- X - RAILROAD SPIKE SET
- △ - UTILITY POLE
- — — — — OVERHEAD UTILITY LINE

PLAT OF SURVEY OF

OWNER: MR. & MRS. JAMES WINKE
 5745 N. OLEANDER
 CHICAGO, IL. 60631

LOTS 3, 4, 5, 34, 35 AND 36 IN
 THE ADDITION TO GLENWOOD
 SPRINGS, VILLAGE OF FONTANA-
 ON-GENEVA LAKE, WALWORTH
 COUNTY, WISCONSIN.

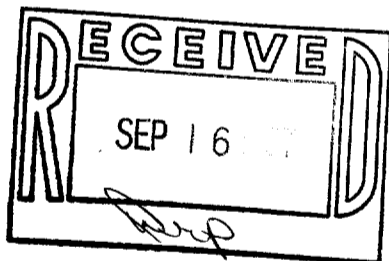

I HEREBY CERTIFY THAT I HAVE SURVEYED THE ABOVE DESCRIBED PROPERTY AND THAT THE ABOVE MAP IS A TRUE REPRESENTATION THEREOF AND SHOWS THE SIZE AND LOCATION OF THE PROPERTY, ITS EXTERIOR BOUNDARIES, THE LOCATION OF ALL VISIBLE STRUCTURES AND DIMENSIONS OF ALL PRINCIPAL BUILDINGS THEREON, BOUNDARY FENCES, APPARENT EASEMENTS, ROADWAYS AND VISIBLE ENCROACHMENTS, IF ANY, TO THE BEST OF MY KNOWLEDGE AND BELIEF.

THIS SURVEY IS MADE FOR THE USE OF THE PRESENT OWNERS OF THE PROPERTY AND ALSO THOSE WHO PURCHASE, MORTGAGE OR GUARANTEE THE TITLE THERETO WITHIN ONE (1) YEAR FROM DATE HEREOF.
 SURVEY NOT VALID UNLESS SURVEYOR'S SIGNATURE IS IN RED.

HAROLD H. KOLB

WISCONSIN REGISTERED LAND SURVEYOR, S-187

DATE MARCH 20, 1987

REVISED

REVISED