


GENEVA

LAKE

PARK


PARK

PLACE

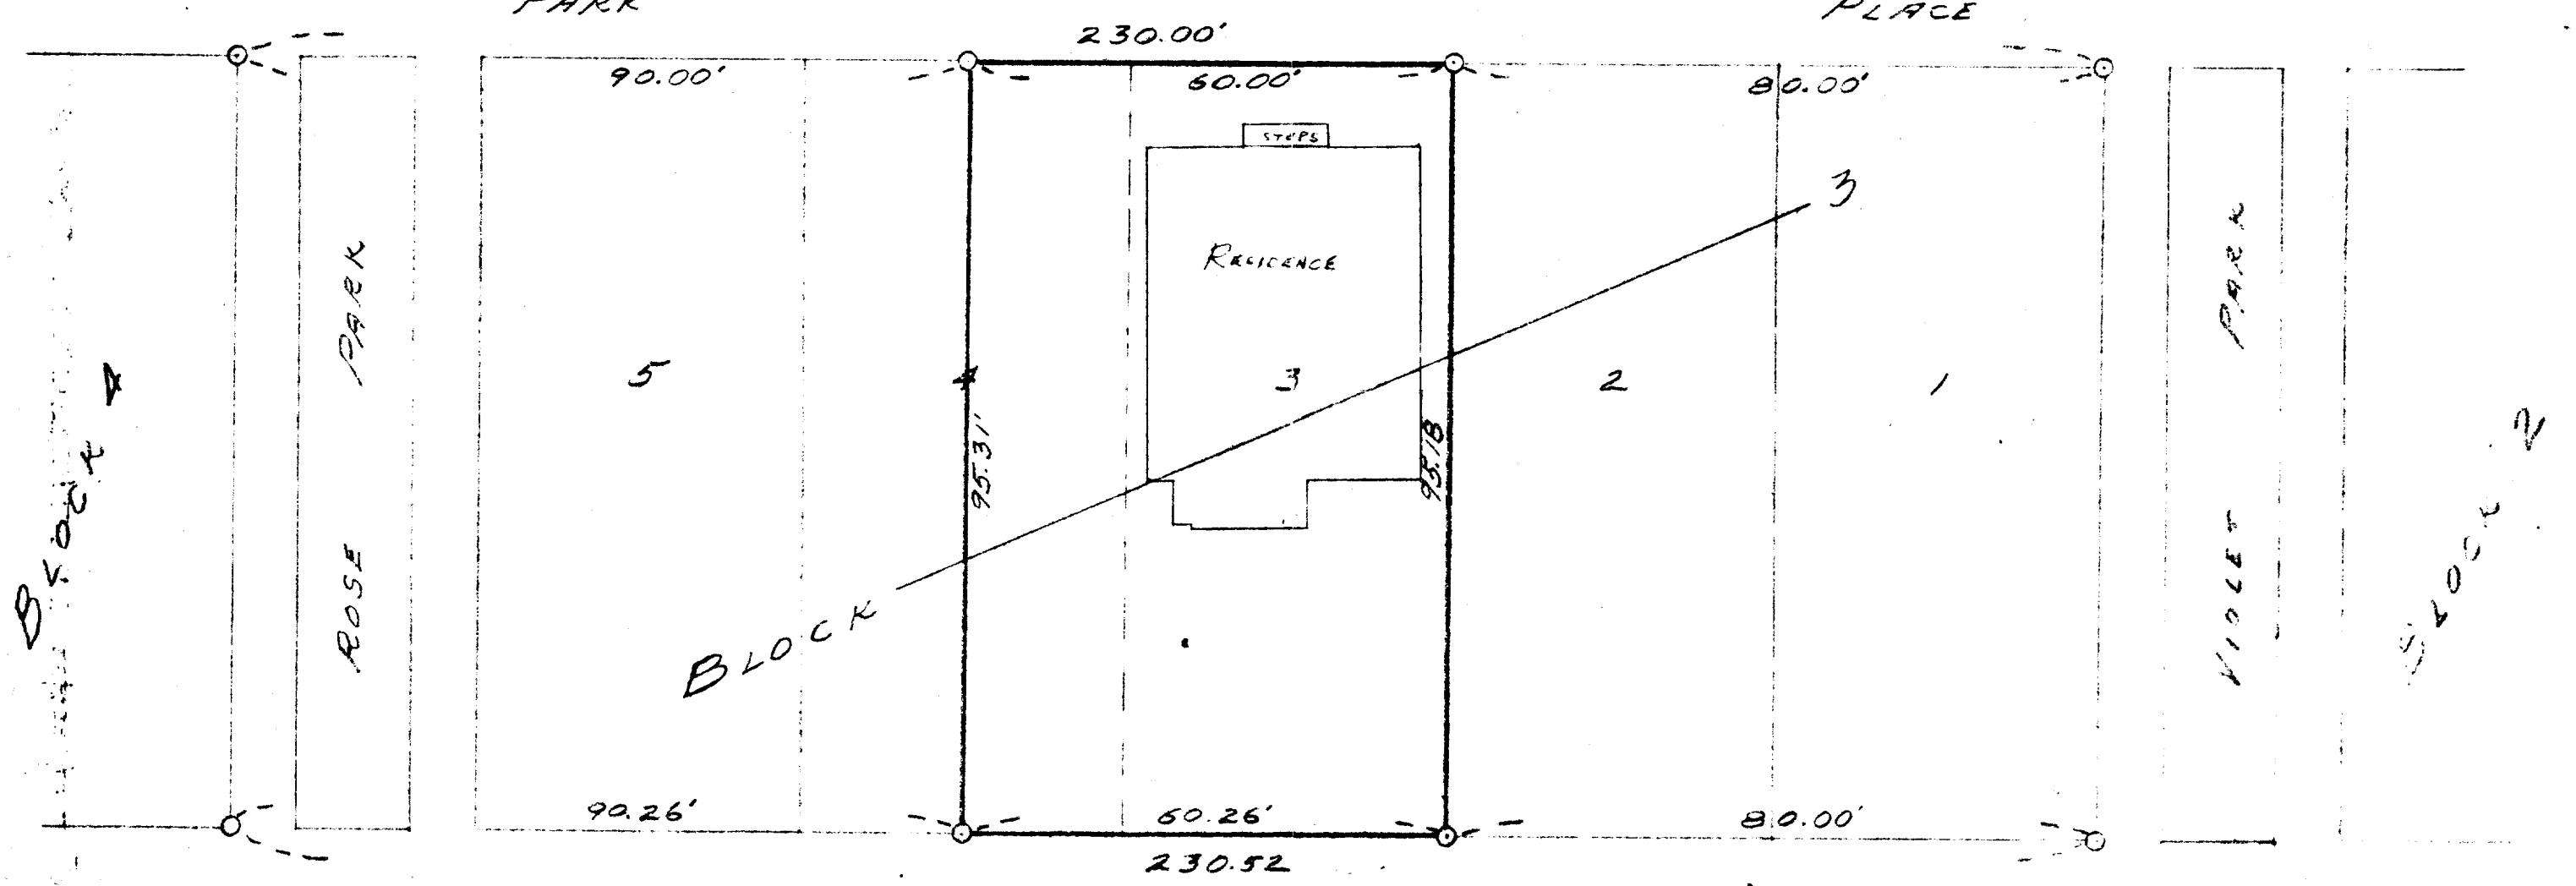

HARVARD

AVENUE

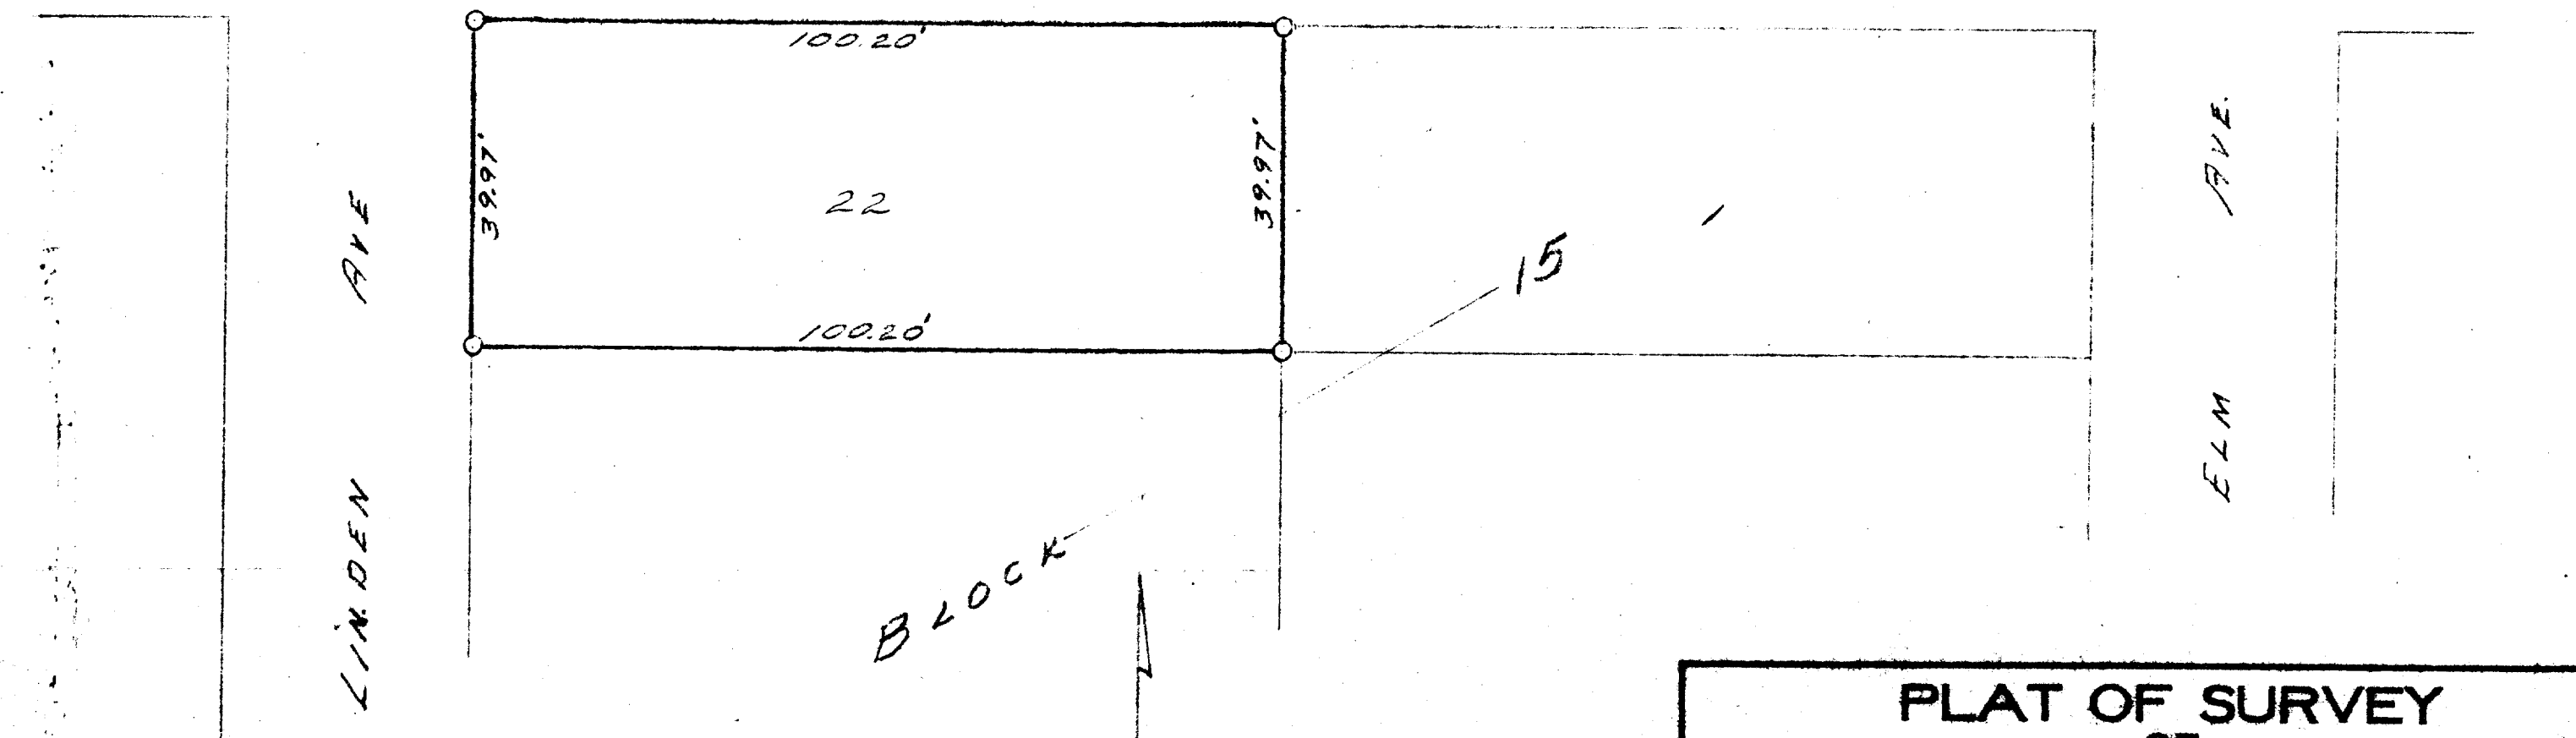

PLAT OF SURVEY
OF

LOT 3 AND EAST 1/2 LOT 4
OF BLOCK 3 AND LOT 22
OF BLOCK 15
GLENWOOD SPRINGS SUBDIVISION
WALWORTH CO., WISCONSIN

Lloyd S. Jensen
SURVEYOR

SCALE 1" = 20'

DATE July 1953