
## ABELL SURVEYING & MAPPING DELAVAN, WISCONSIN 53115 414-720-6787

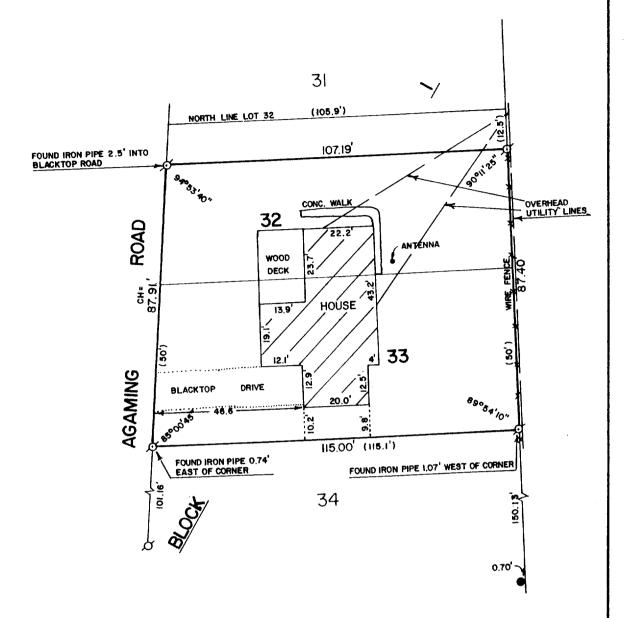

## PLAT OF SURVEY OF


LOT 32 EXCEPT THE NORTHERLY 12.5 FEET AND LOT 33, BLOCK 1, INDIAN HILLS SUBDIVISION, VILLAGE OF FONTANA-ON-GENEVA LAKE, WALWORTH COUNTY, WISCONSIN.

ORDERED BY:

ANCHOR SAVINGS & LOAN

P.O. BOX 997

LAKE GENEVA, WI. 53147

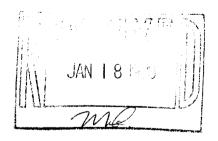

SCALE

1"=30'

LEGEND Ø - IRON PIPE FOUND● - IRON ROD FOUND

( )- RECORDED AS

I HEREBY CERTIFY THAT I HAVE SURVEYED THE ABOVE DESCRIBED PROPERTY AND THAT THE ABOVE MAP IS A TRUE REPRESENTATION THEREOF AND SHOWS THE SIZE AND LOCATION OF THE PROPERTY, ITS EXTERIOR BOUNDARIES, THE LOCATION OF ALL VISIBLE STRUCTURES AND DIMENSIONS OF ALL PRINCIPAL BUILDINGS THEREON, BOUNDARY FENCES, APPARENT EASEMENTS, ROADWAYS AND VISIBLE ENCROACHMENTS, IF ANY, TO THE BEST OF MY KNOWLEDGE AND BELLEF.

THIS SURVEY IS MADE FOR THE USE OF THE PRESENT OWNERS OF THE PROPERTY, AND ALSO THOSE WHO PURCHASE, MORTGAGE, OR GUARANTEE THE TITLE THERETO WITHIN ONE (1) YEAR FROM DATE HEREOF.

DAVID F. ABELL WISCONSIN REGISTERED LAND SURVEYOR, S-1596

89083

DATE JOB NUMBER = NOTE: THIS IS NOT A CERTIFIED COPY UNLESS SEALED.